


(A) METAL CORNER CLOSURE
3" = 1'-0"

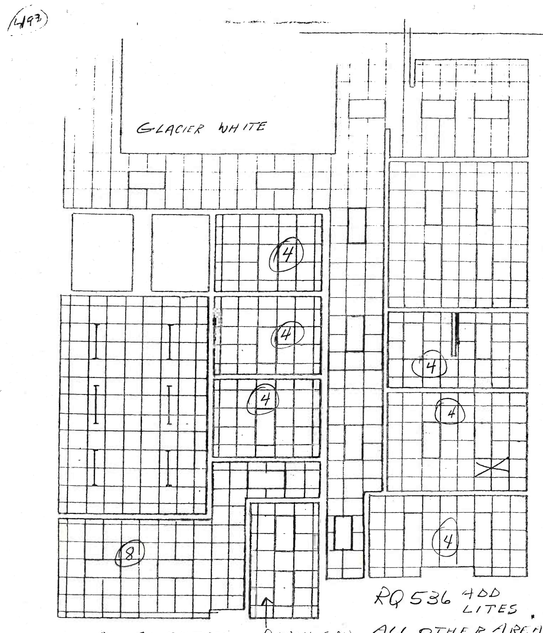

ADD 21 FIXTURES

BLACK GRID GLACIER TILE BLACK

RQ 586 ADD LITES. ALL OTHER AREAS GLACIER WHITE GRID

REFLECTED CEILING-PATROL		2/17/92
KENTON PETERS + ASSOC. 44 E MIFFLIN MADISON, WISCONSIN 53703	JEFFERSON COUNTY LAW ENFORCEMENT CENTER JEFFERSON, WISCONSIN	G225

AS BUILT
DEC 6, 1994

DATE	REVISION

STRUCTURAL CONSULTANT

MECHANICAL CONSULTANT

ARCHITECT
KENTON PETERS + ASSOC., INC.
44 E MIFFLIN
MADISON, WISCONSIN 53703
(608) 255-5656

JEFFERSON COUNTY
LAW ENFORCEMENT CENTER
JEFFERSON, WISCONSIN

REFLECTED CLG PLAN
FIRST FLOOR
SHERIFF'S DEPT.
1/8"=1'-0"

6-11-90

A12