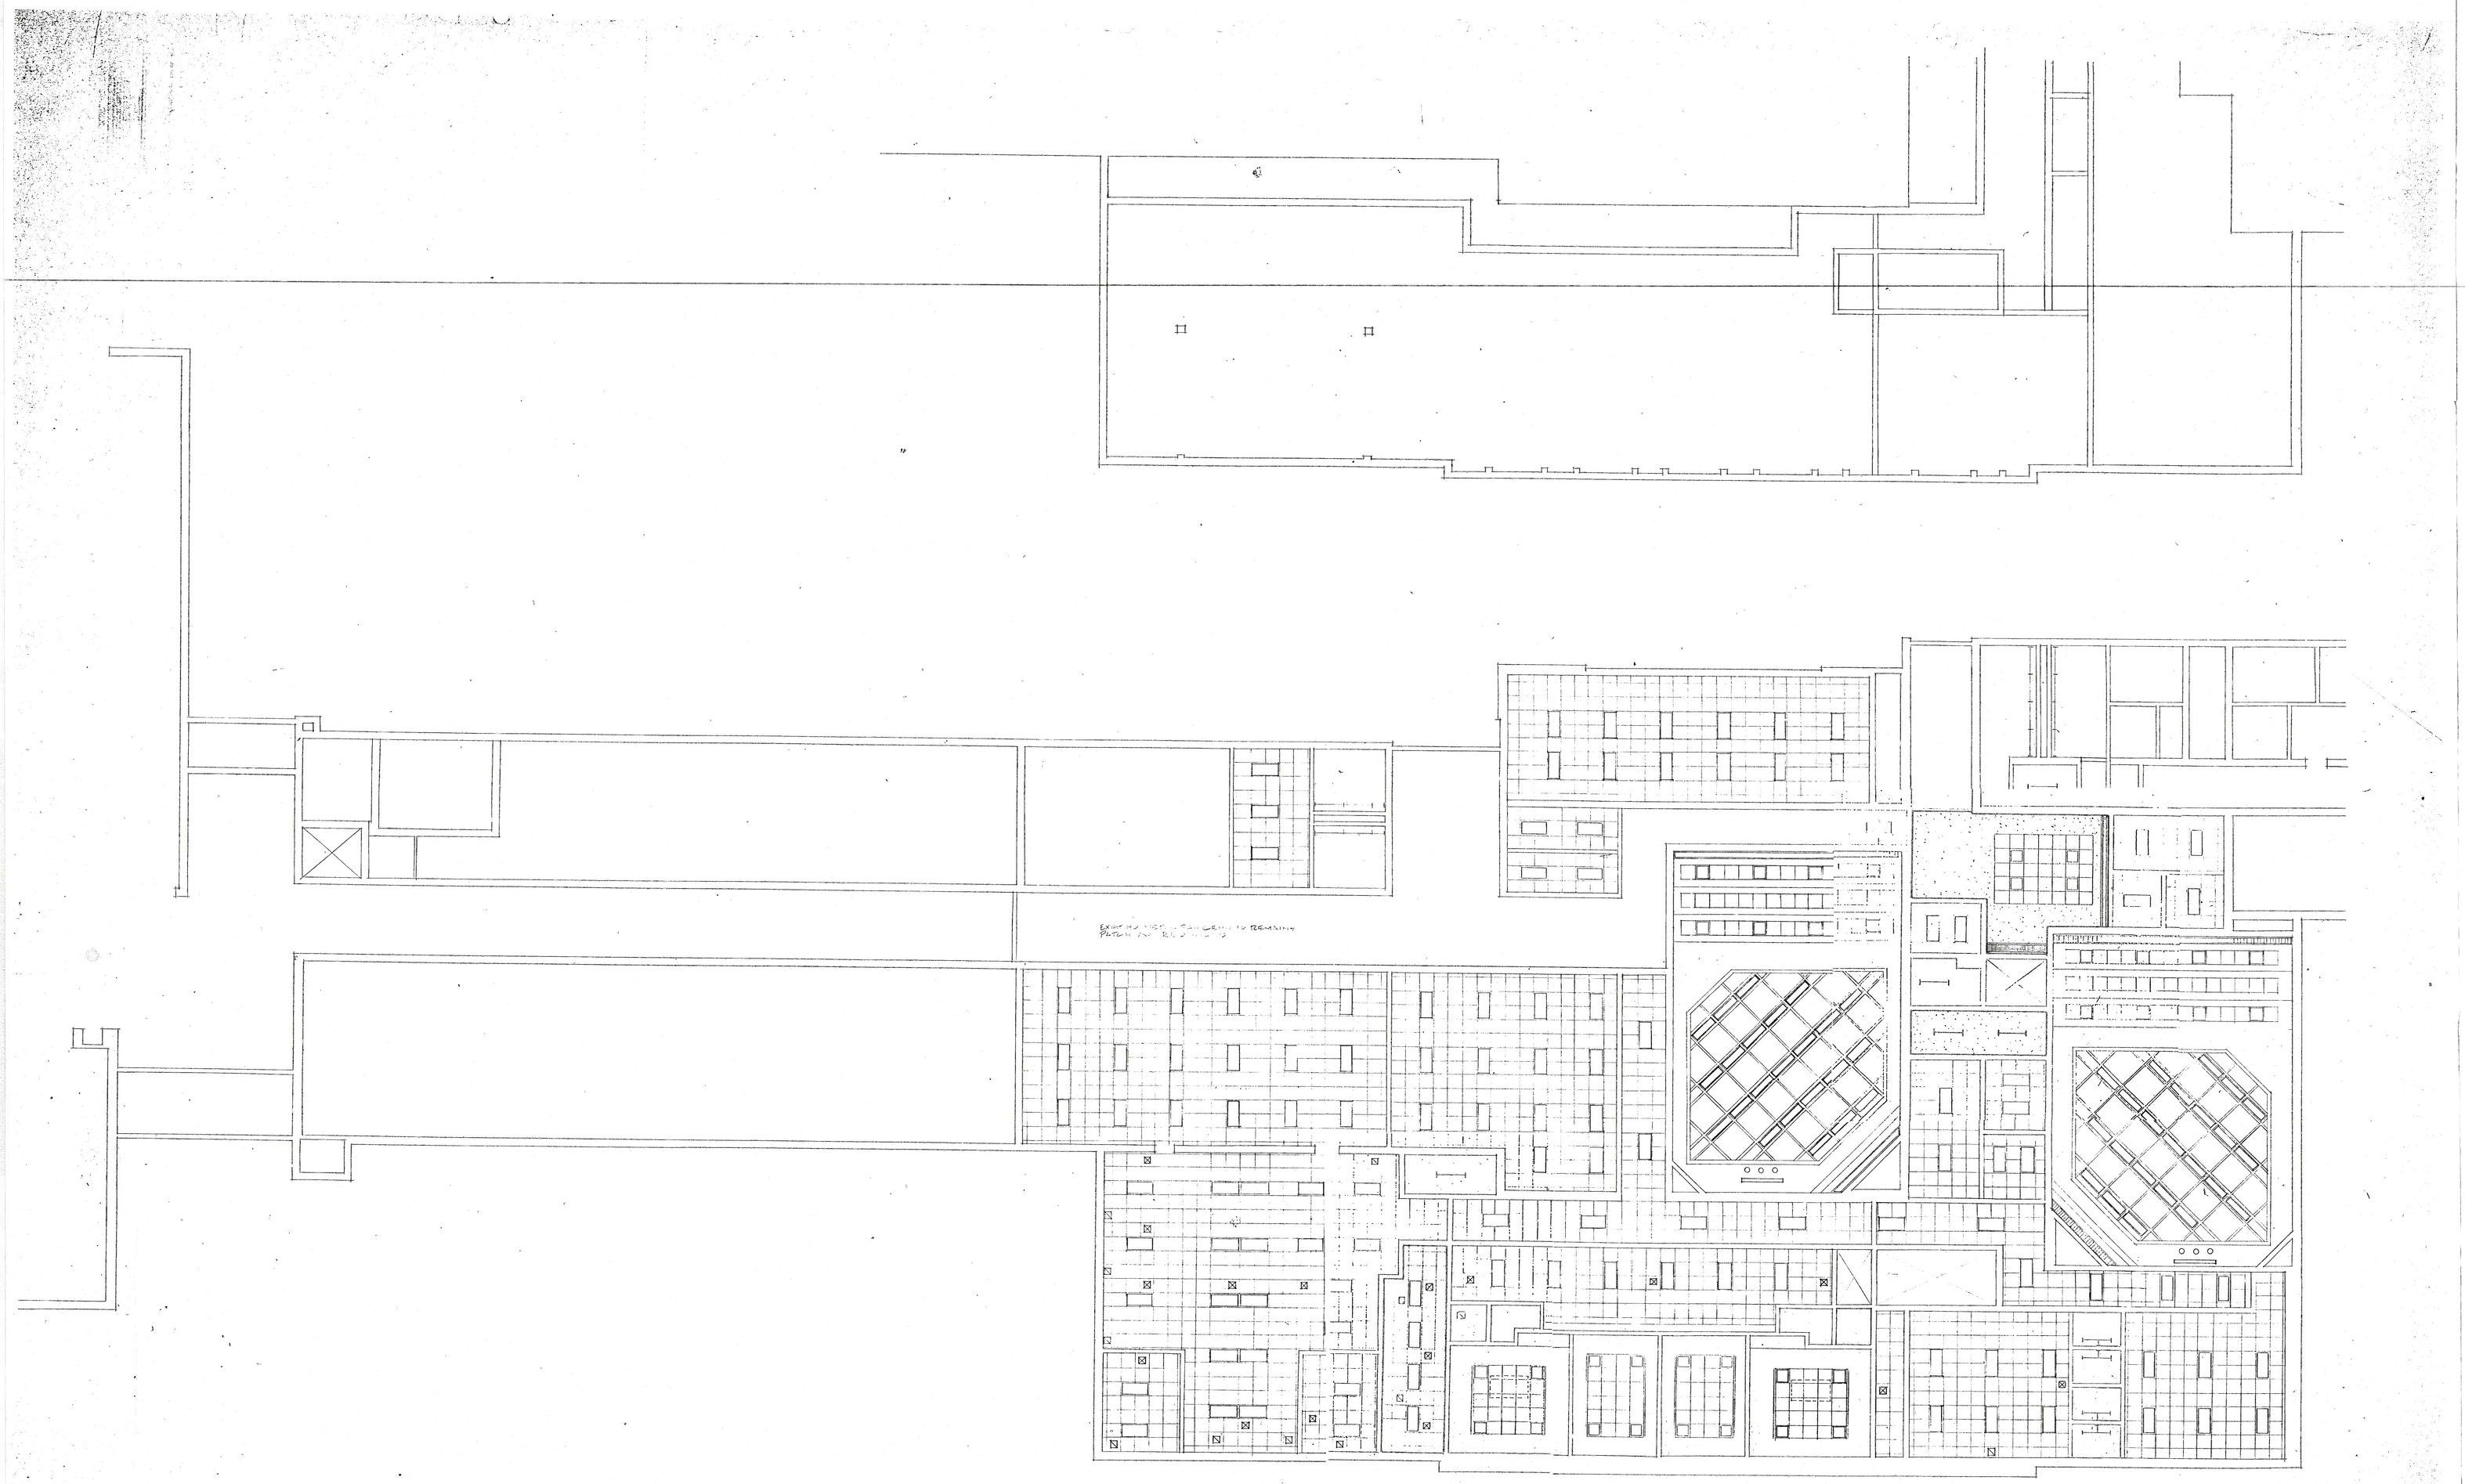


STRUCTURAL CONSULTANT

MECHANICAL CONSULTANT

ARCHITECT

KENTON PETERS + ASSOC., INC.
44 E MIFFLIN
MADISON, WISCONSIN 53703
(608) 255-5656

JEFFERSON COUNTY
LAW ENFORCEMENT CENTER

JEFFERSON, WISCONSIN

DATE	REVISION

AS BUILT
DEC 6, 1994

REFLECTED CEILING PLAN
FIRST FLOOR & BASEMENT
1/8"-1'-0"

8-11-94

A13