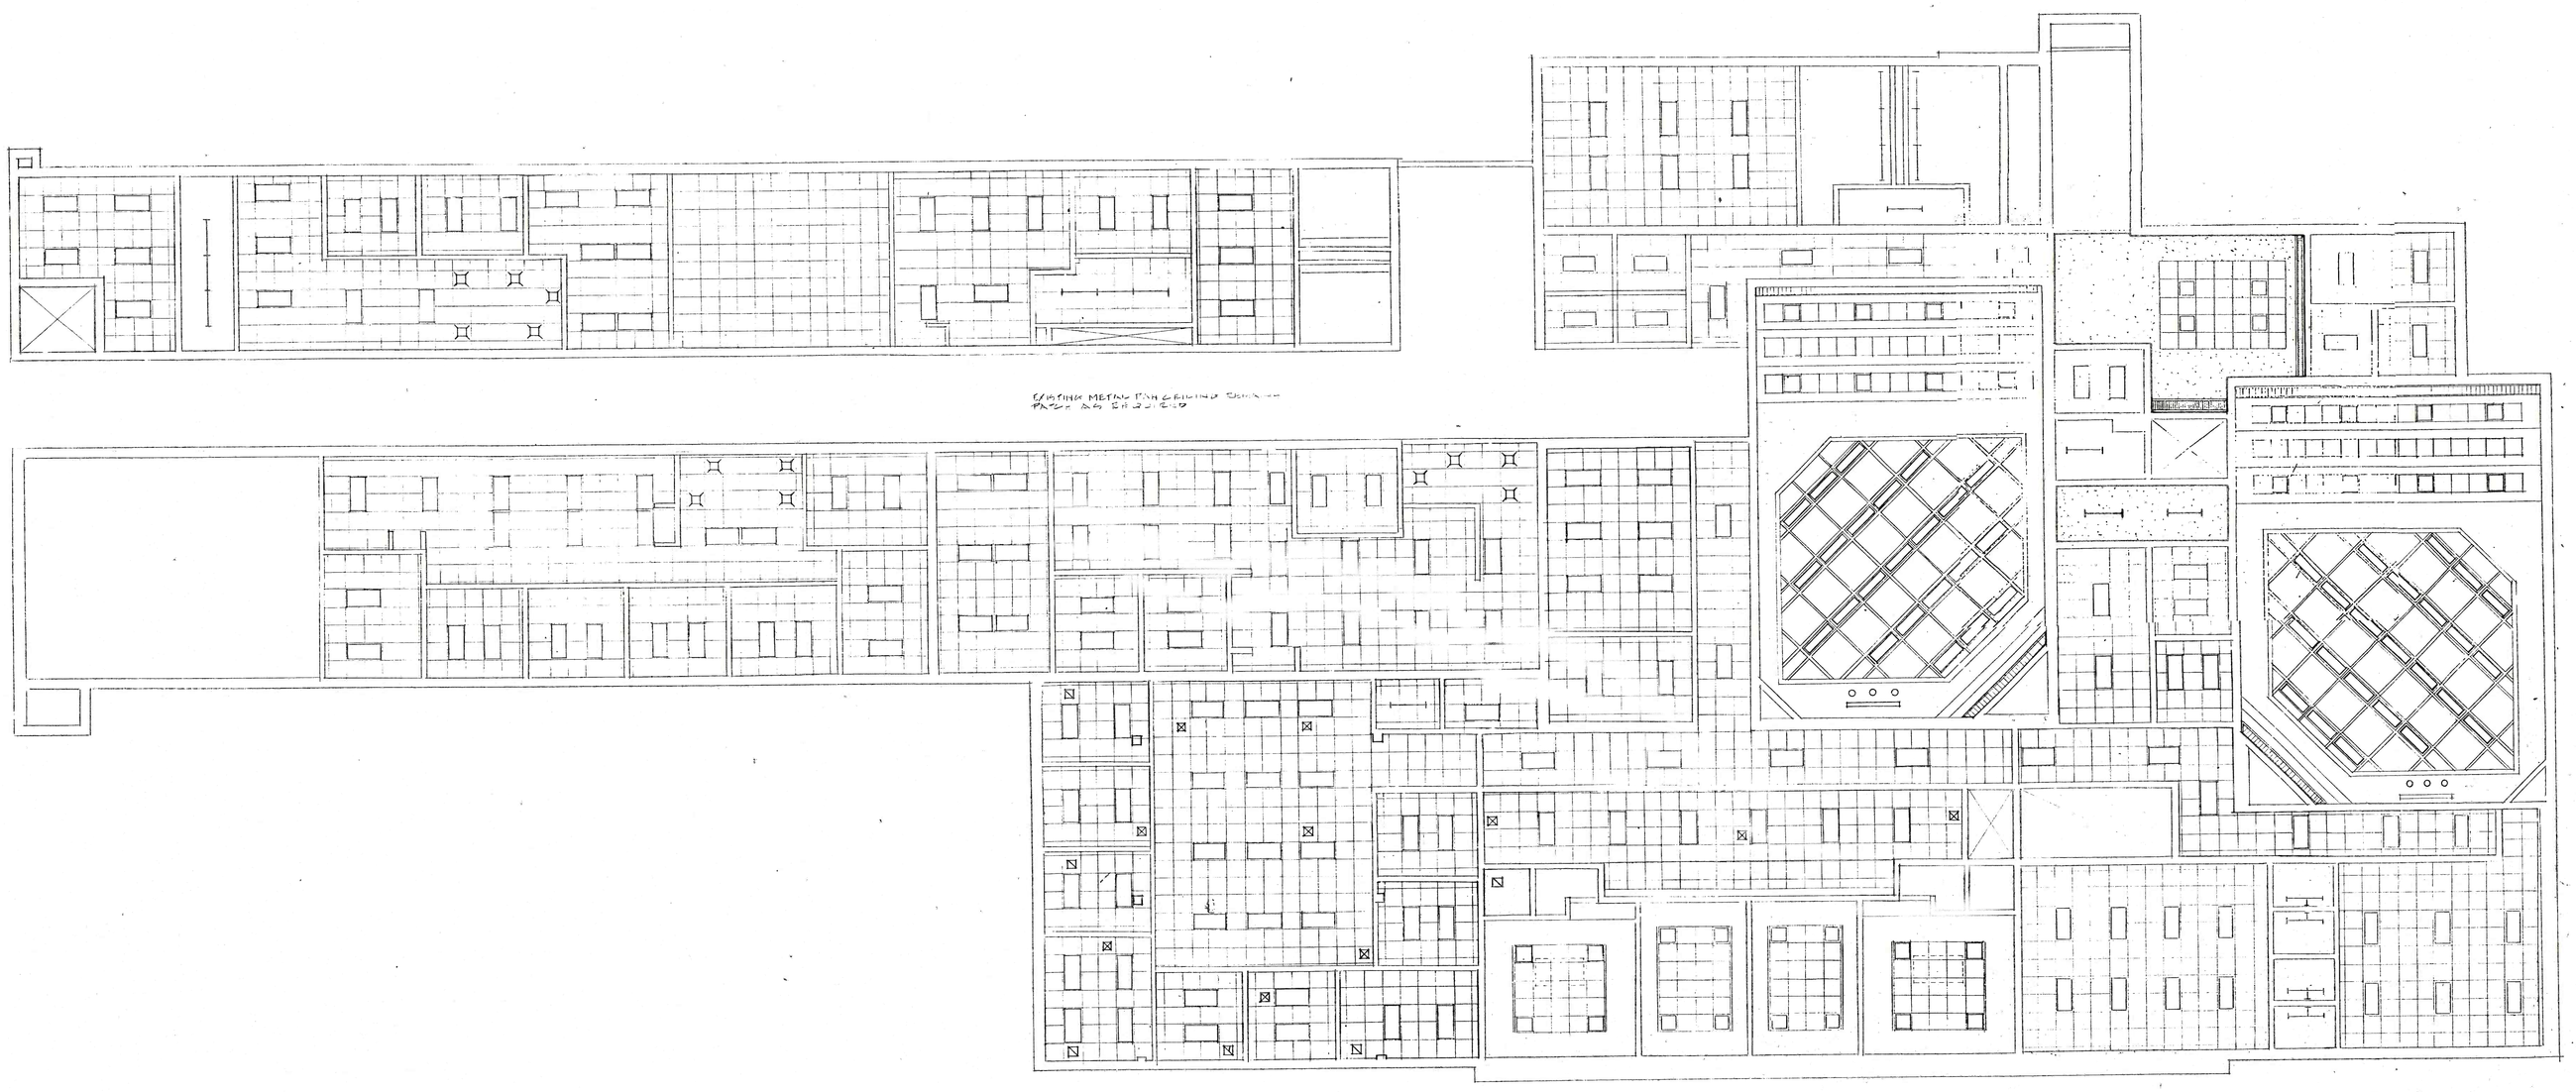


EXISTING METAL PAN CEILING GRID - WEST 2/3 OF SECOND

AS BUILT
DEC 6, 1994

DATE	REVISION

STRUCTURAL CONSULTANT

MECHANICAL CONSULTANT

ARCHITECT
KENTON PETERS + ASSOC., INC.
44 E MIFFLIN
MADISON, WISCONSIN 53703
(608) 255-5658

JEFFERSON COUNTY
LAW ENFORCEMENT CENTER
JEFFERSON, WISCONSIN

REFLECTED CEILING PLAN
SECOND FLOOR - NORTH

8-11-99

A14