

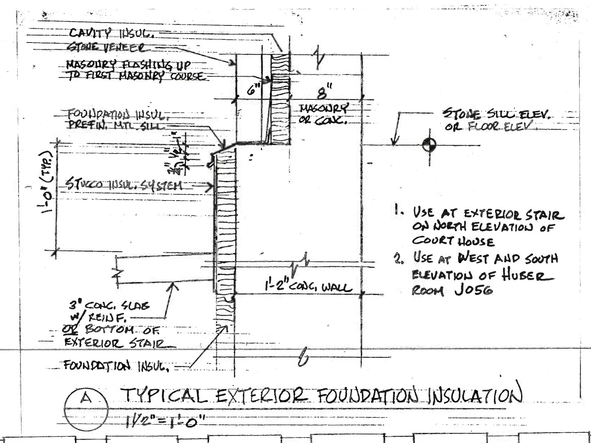



A TYPICAL EXTERIOR FOUNDATION INSULATION
1½"=1'-0"

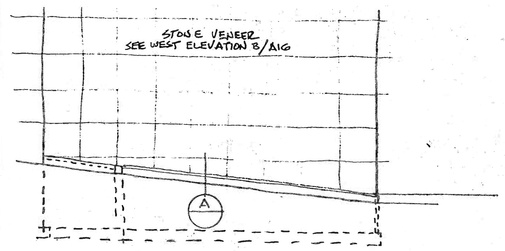


TYPICAL EXTERIOR FOUNDATION INSULATION		10/29/90
KENTON PETERS + ASSOC. 44 E MIFFLIN MADISON, WISCONSIN 53703 (608) 255-5656	JEFFERSON COUNTY LAW ENFORCEMENT CENTER JEFFERSON, WISCONSIN	DRG

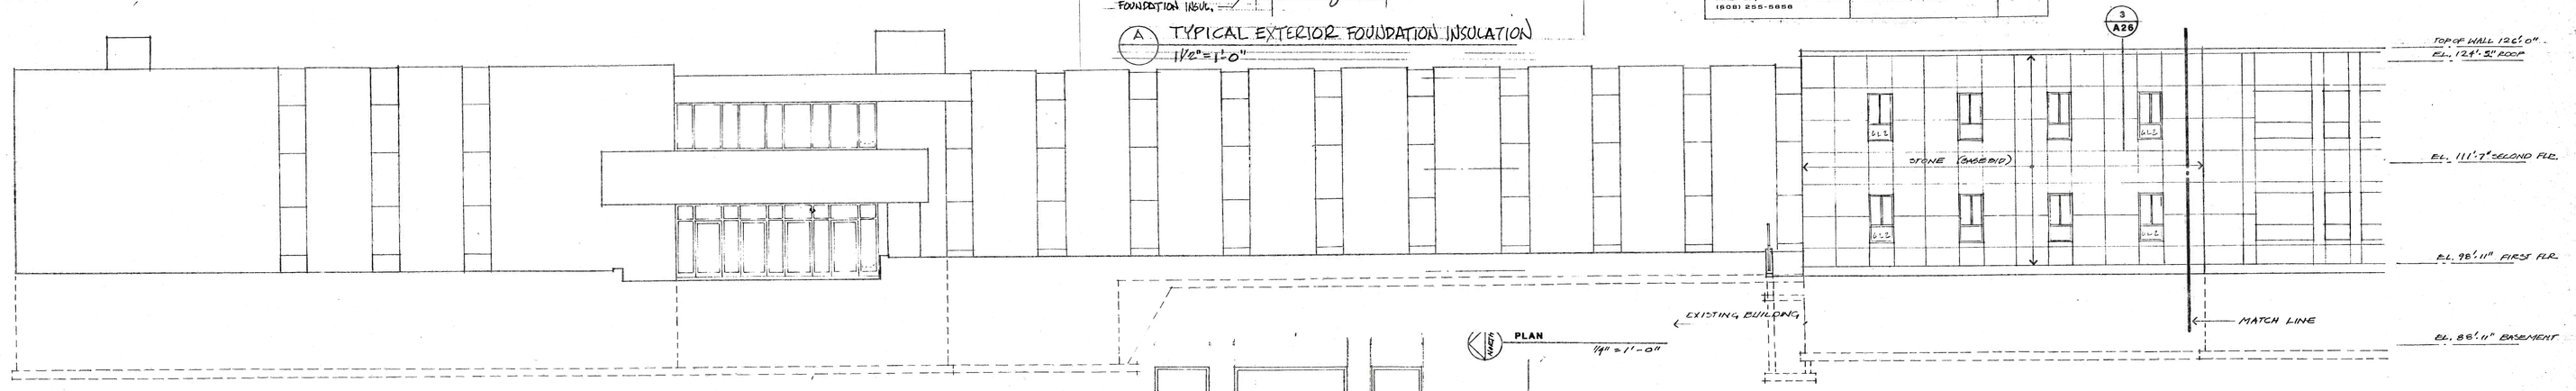


WEST ELEVATION A

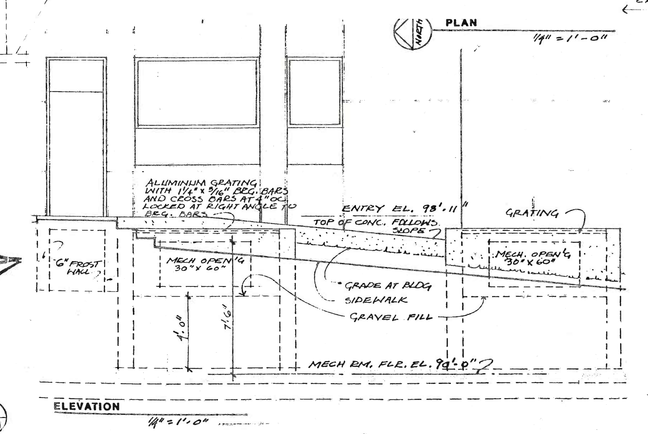


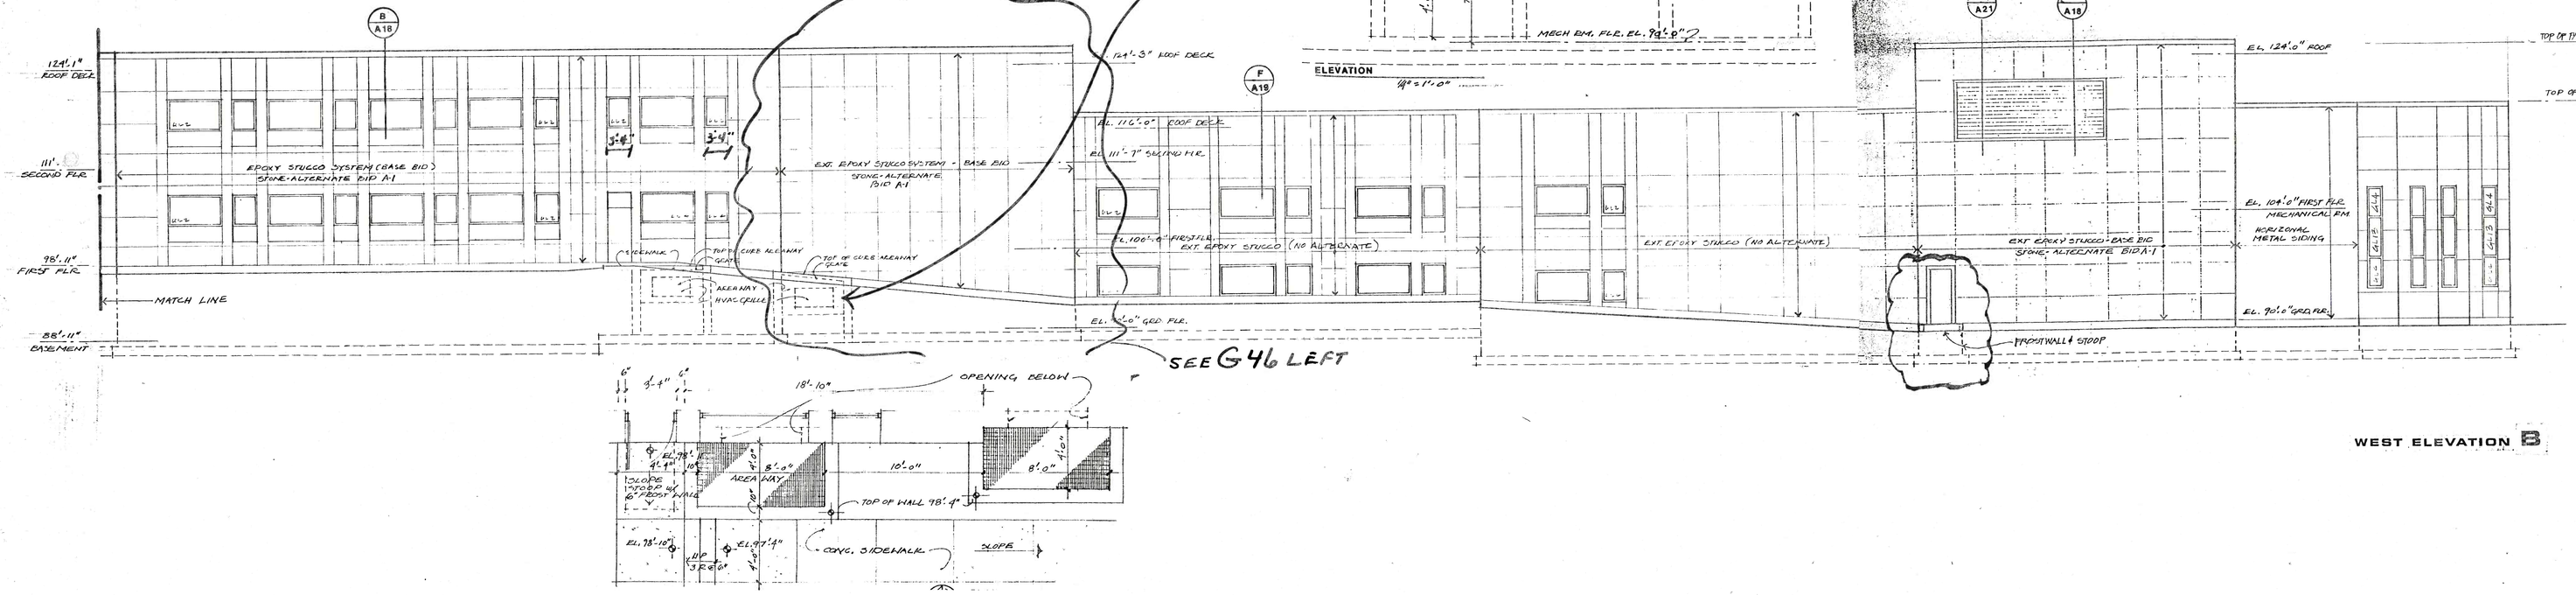

WEST ELEVATION B

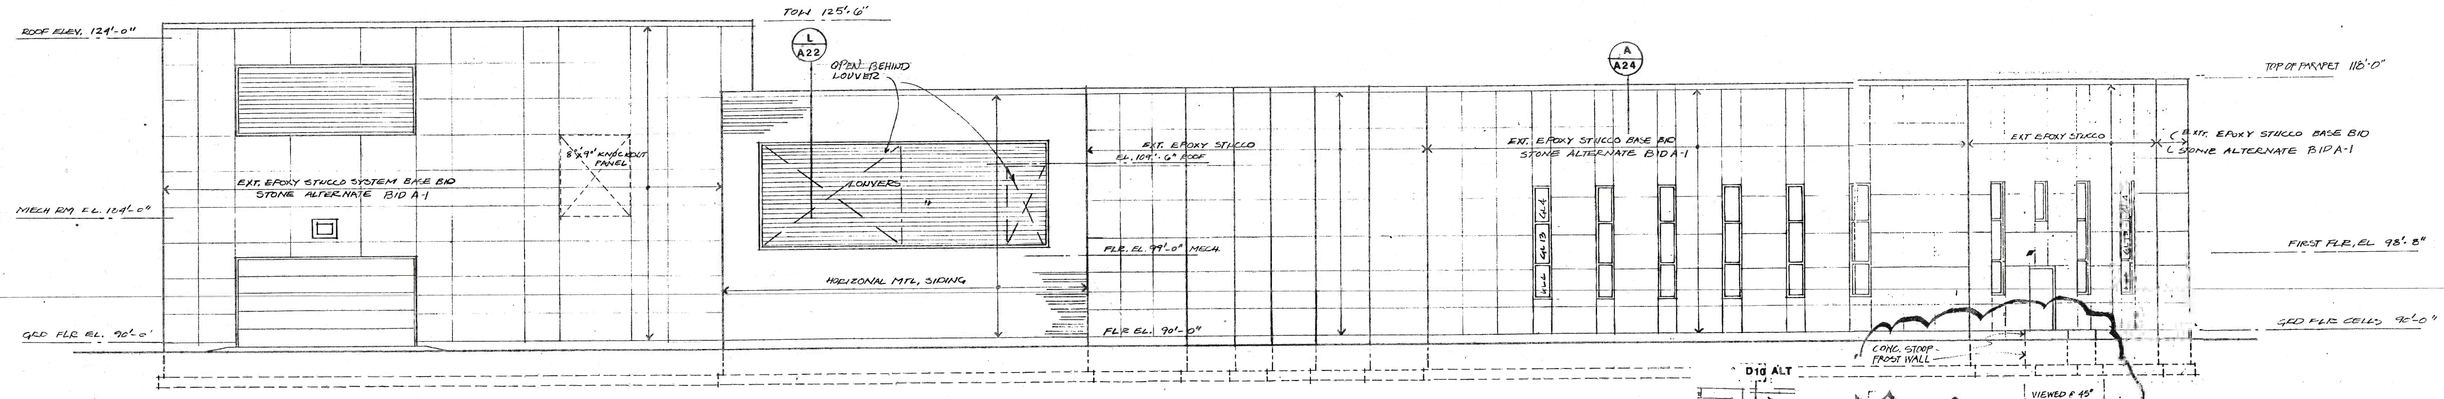

SOUTH ELEVATION C

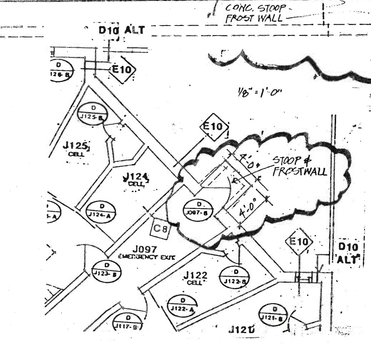

AS BUILT
DEC 6, 1994

DATE	REVISION
	Elevation F entrance through which section A/A25 in indicated is new aluminum entrance delete "exist". Note on elevation. Elevation H no alternate stone bid this elevation.

STRUCTURAL CONSULTANT

MECHANICAL CONSULTANT

ARCHITECT
KENTON PETERS + ASSOC., INC.
44 E MIFFLIN
MADISON, WISCONSIN 53703
(608) 255-5656

JEFFERSON COUNTY
LAW ENFORCEMENT CENTER
JEFFERSON, WISCONSIN

BUILDING ELEVATIONS SOUTH & WEST — 5-11-90

1/8"-1'-0" — A16