
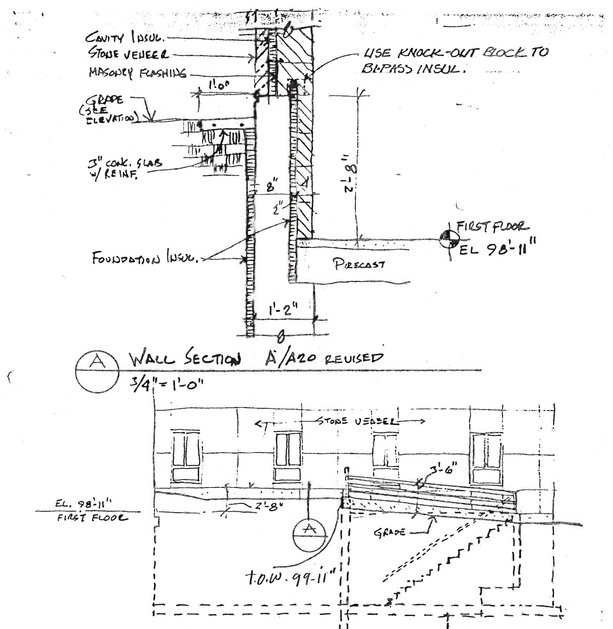


A WALL SECTION A/A20 REVISED
3/4"=1'-0"

D A17 NORTH ELEVATION D
1/8"=1'-0" ELEVATION D/A17 REVISED

NORTH WALL ELEVATION & DETAIL		10/30/90
KENTON PETERS + ASSOC. 44 E MIFFLIN MADISON, WISCONSIN 53703 (608) 255-5656	JEFFERSON COUNTY LAW ENFORCEMENT CENTER JEFFERSON, WISCONSIN	G45

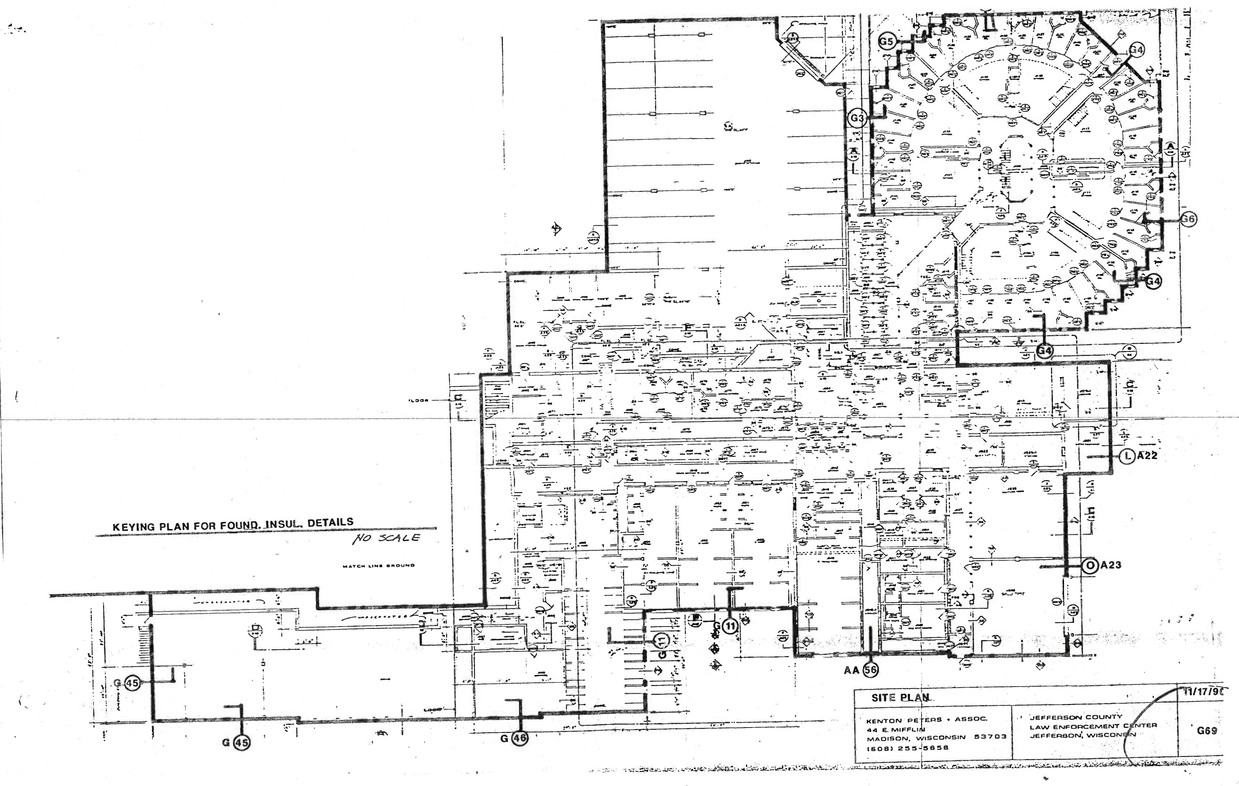

KEYING PLAN FOR FOUND. INSUL. DETAILS
NO SCALE

SITE PLAN		11/17/90
KENTON PETERS + ASSOC. 44 E MIFFLIN MADISON, WISCONSIN 53703 (608) 255-5656	JEFFERSON COUNTY LAW ENFORCEMENT CENTER JEFFERSON, WISCONSIN	G69

KENTON PETERS + ASSOCIATES, INC.
324 SOUTH HAMILTON STREET
MADISON, WI 53703
(608) 255-5656

A17 SUPPLEMENTARY DRAWINGS

AS BUILT
DEC 6, 1994