

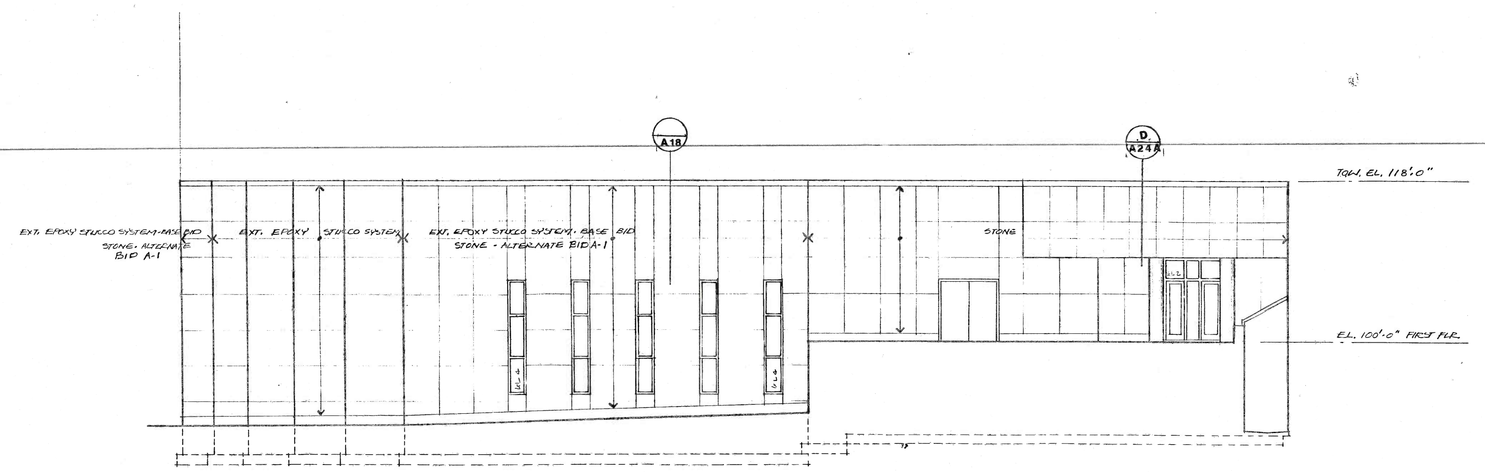



NORTH ELEVATION **E**

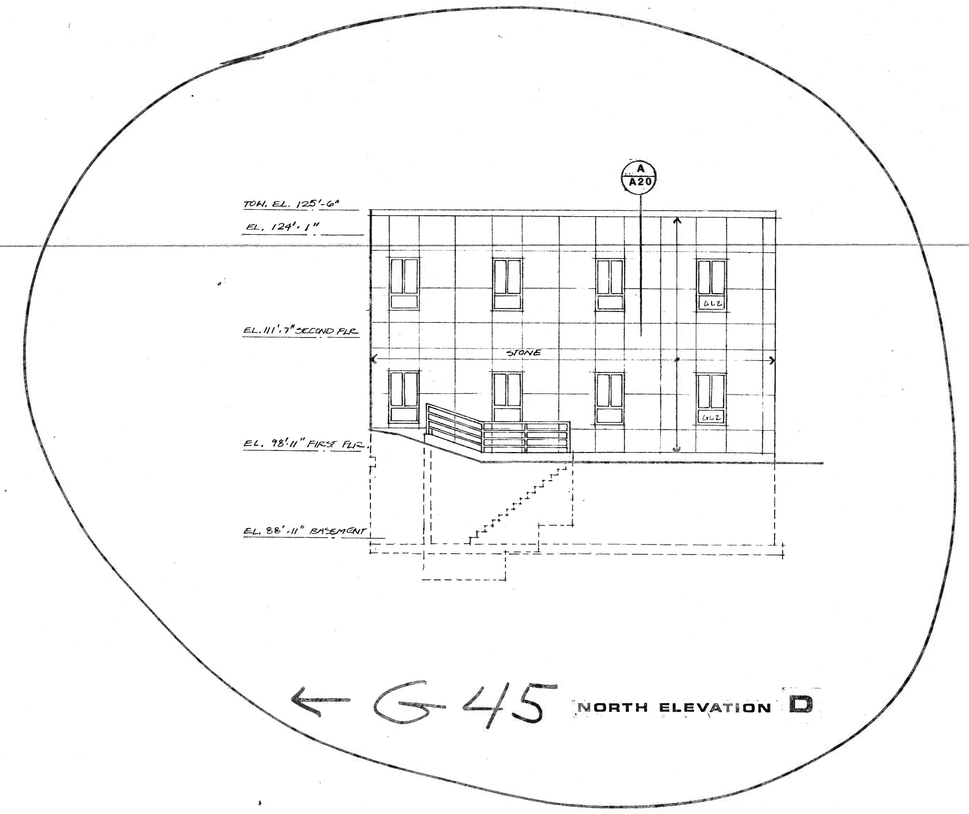

← G-45 NORTH ELEVATION **D**

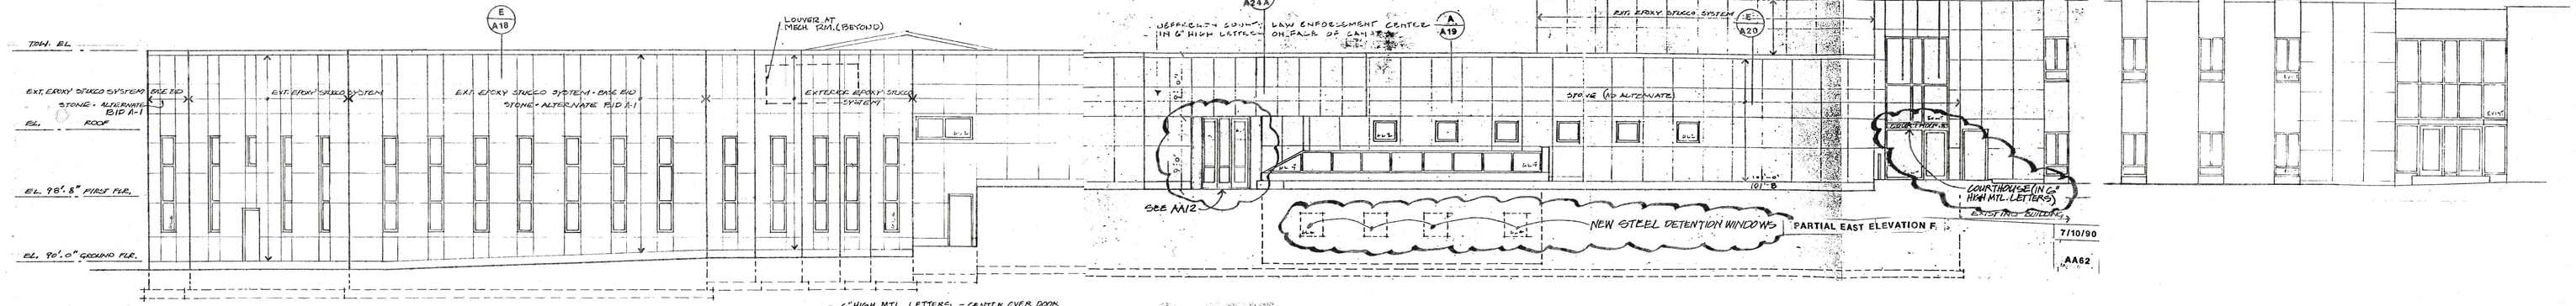


EAST ELEVATION **F**

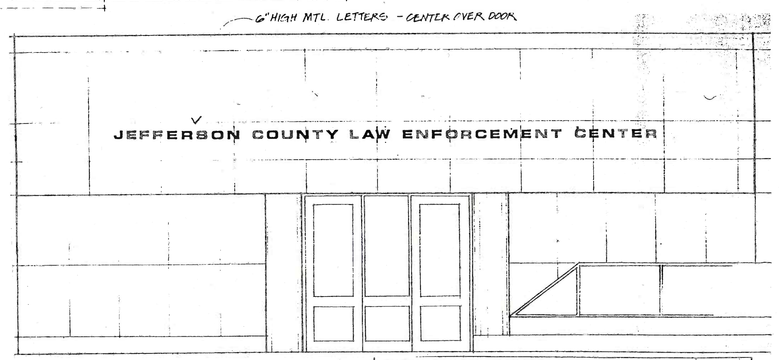


ENTRY CANOPY SIGNAGE — 7/10/90 — AA12

EAST ENTRY ELEVATION


1/4"=1'-0"

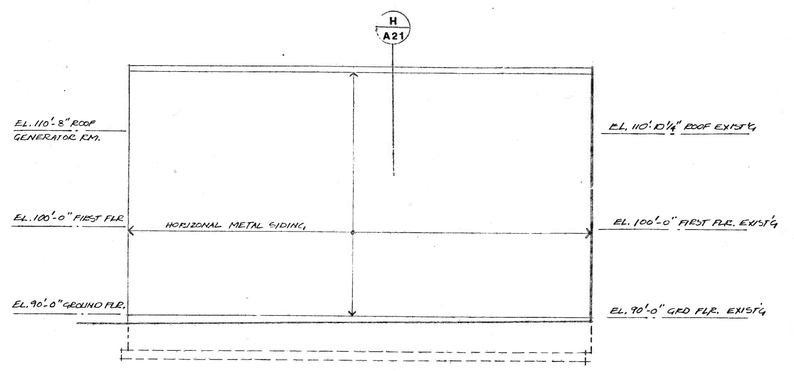


ELEVATION **K**

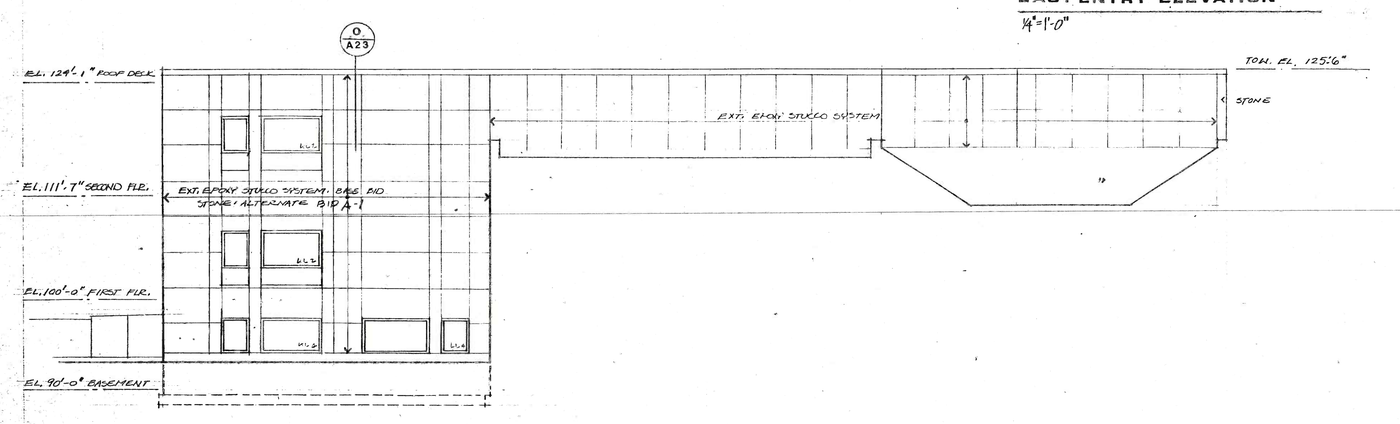

ELEVATION **G**

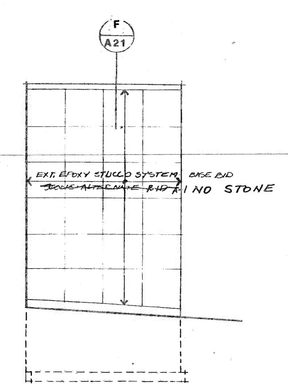

ELEVATION **H**

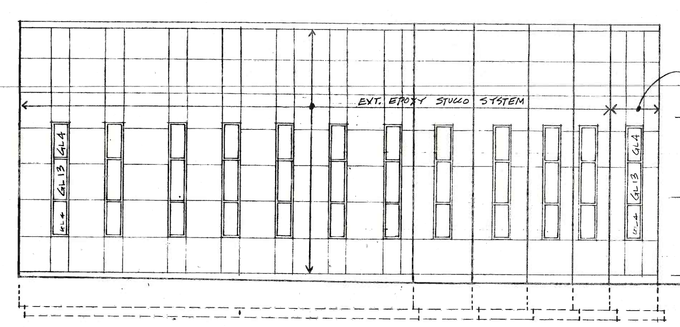

ELEVATION **J**

AS BUILT
DEC 6, 1994

DATE	REVISION

STRUCTURAL CONSULTANT

MECHANICAL CONSULTANT

ARCHITECT

KENTON PETERS + ASSOC., INC.
44 E MIFFLIN
MADISON, WISCONSIN 53703
(608) 255-5656

JEFFERSON COUNTY LAW ENFORCEMENT CENTER

JEFFERSON, WISCONSIN

BUILDING ELEVATIONS — 5-11-90 — A12

1/8"-1'-0"