


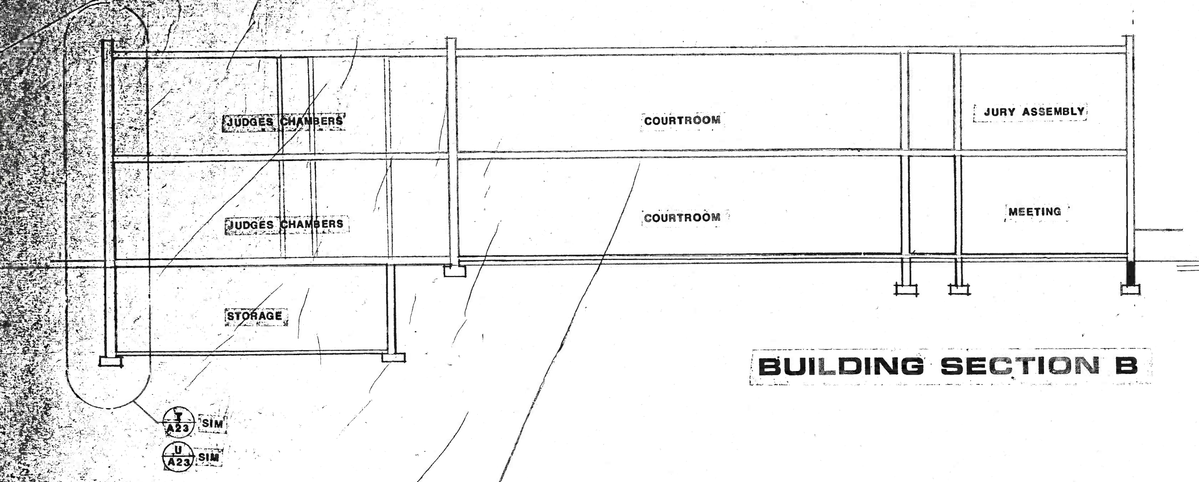


BUILDING SECTION B

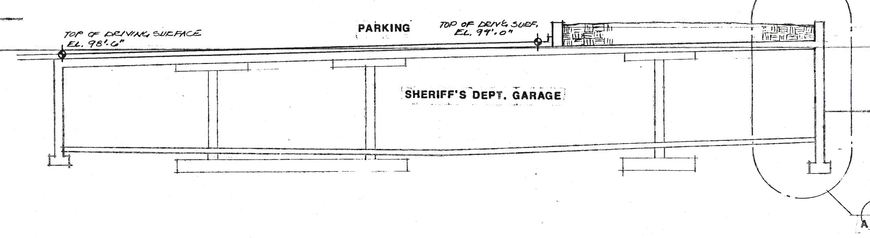


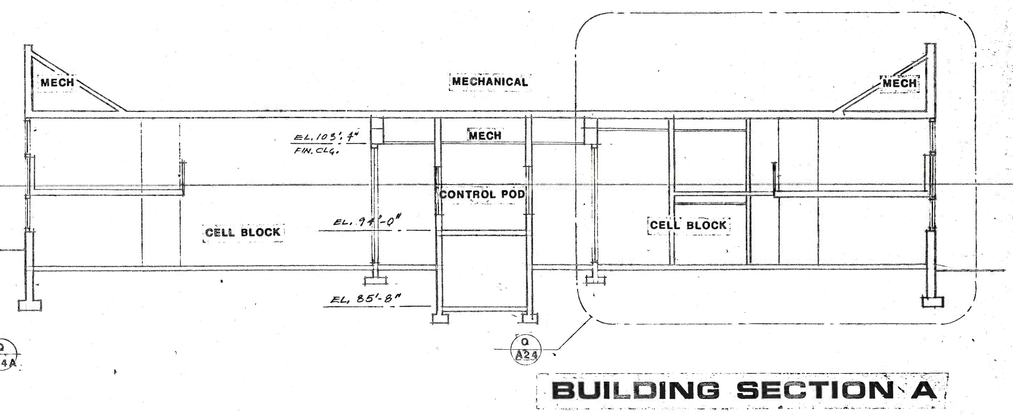


BUILDING SECTION A

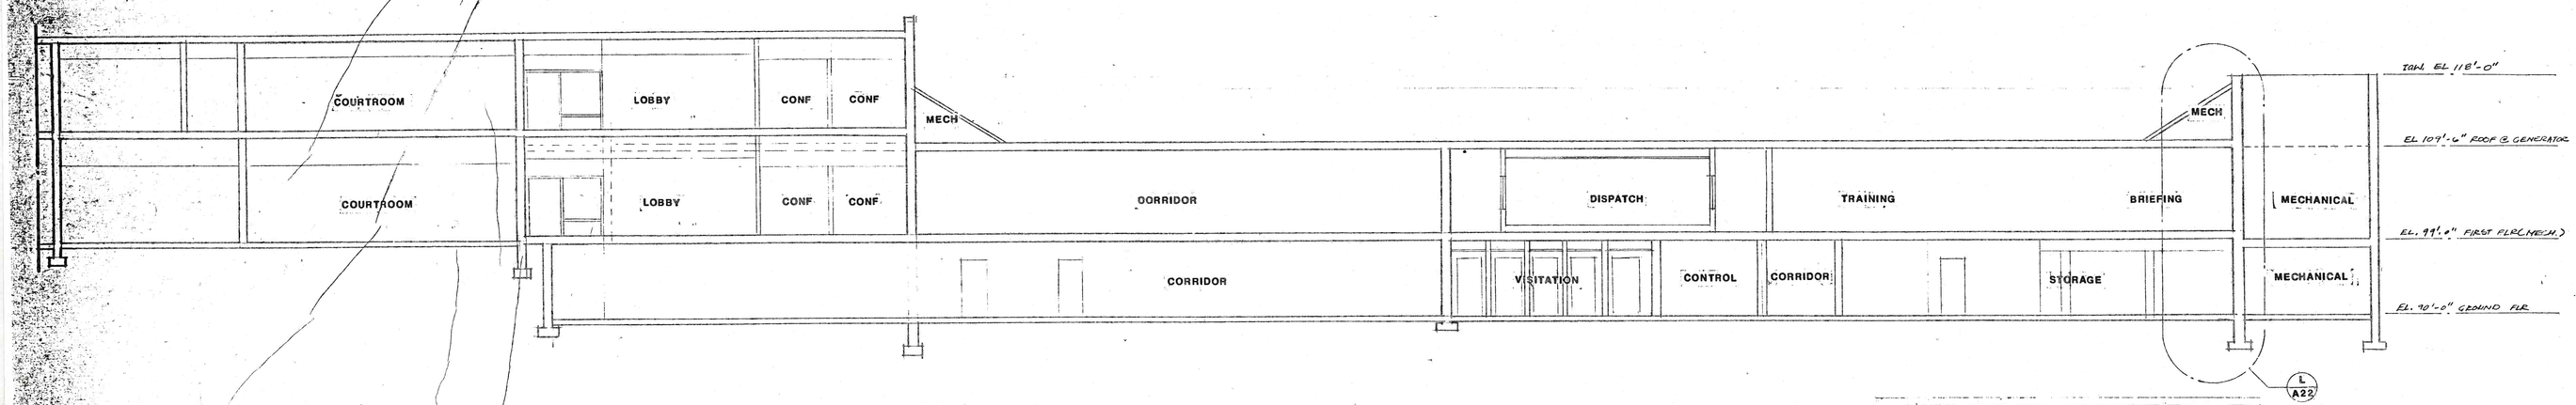

BUILDING SECTION C

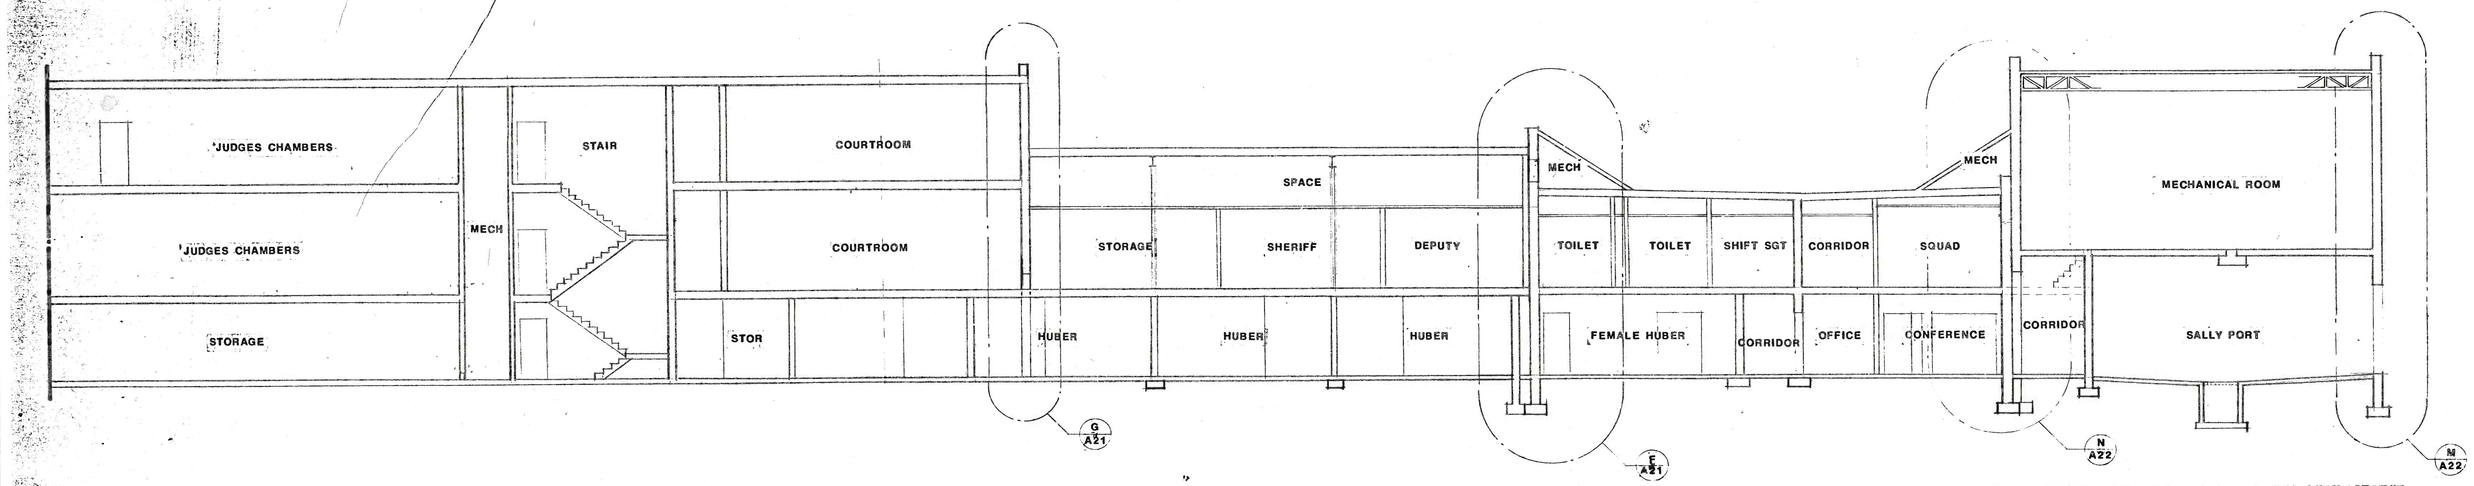

BUILDING SECTION D

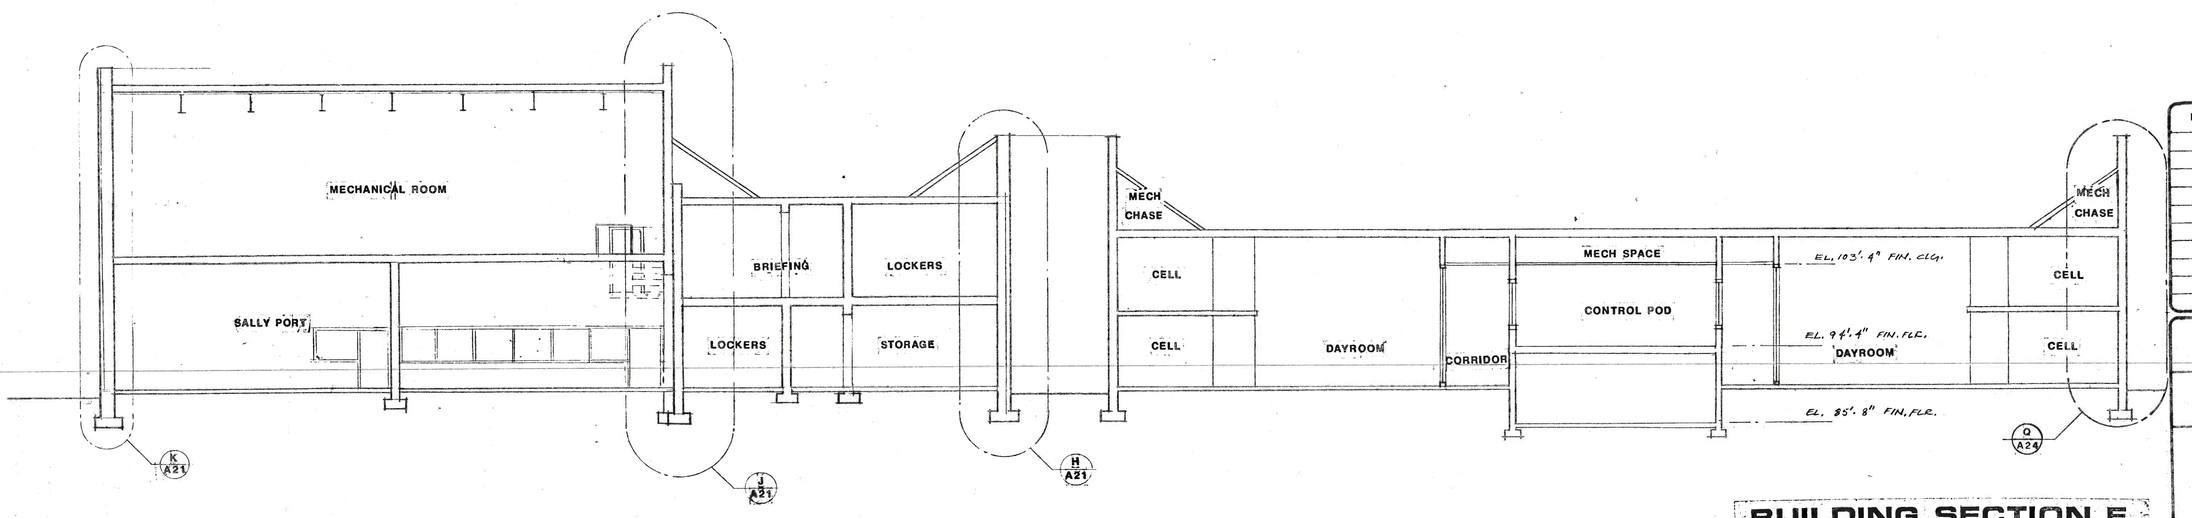

BUILDING SECTION E

AS BUILT
DEC 6, 1994

DATE	REVISION

STRUCTURAL CONSULTANT

MECHANICAL CONSULTANT

ARCHITECT

KENTON PETERS + ASSOC., INC.
44 E MIFFLIN
MADISON, WISCONSIN 53703
(608) 255-5656

JEFFERSON COUNTY
LAW ENFORCEMENT CENTER

JEFFERSON, WISCONSIN

BUILDING SECTIONS

SCALE: 1/8"-1'-0"

A18