
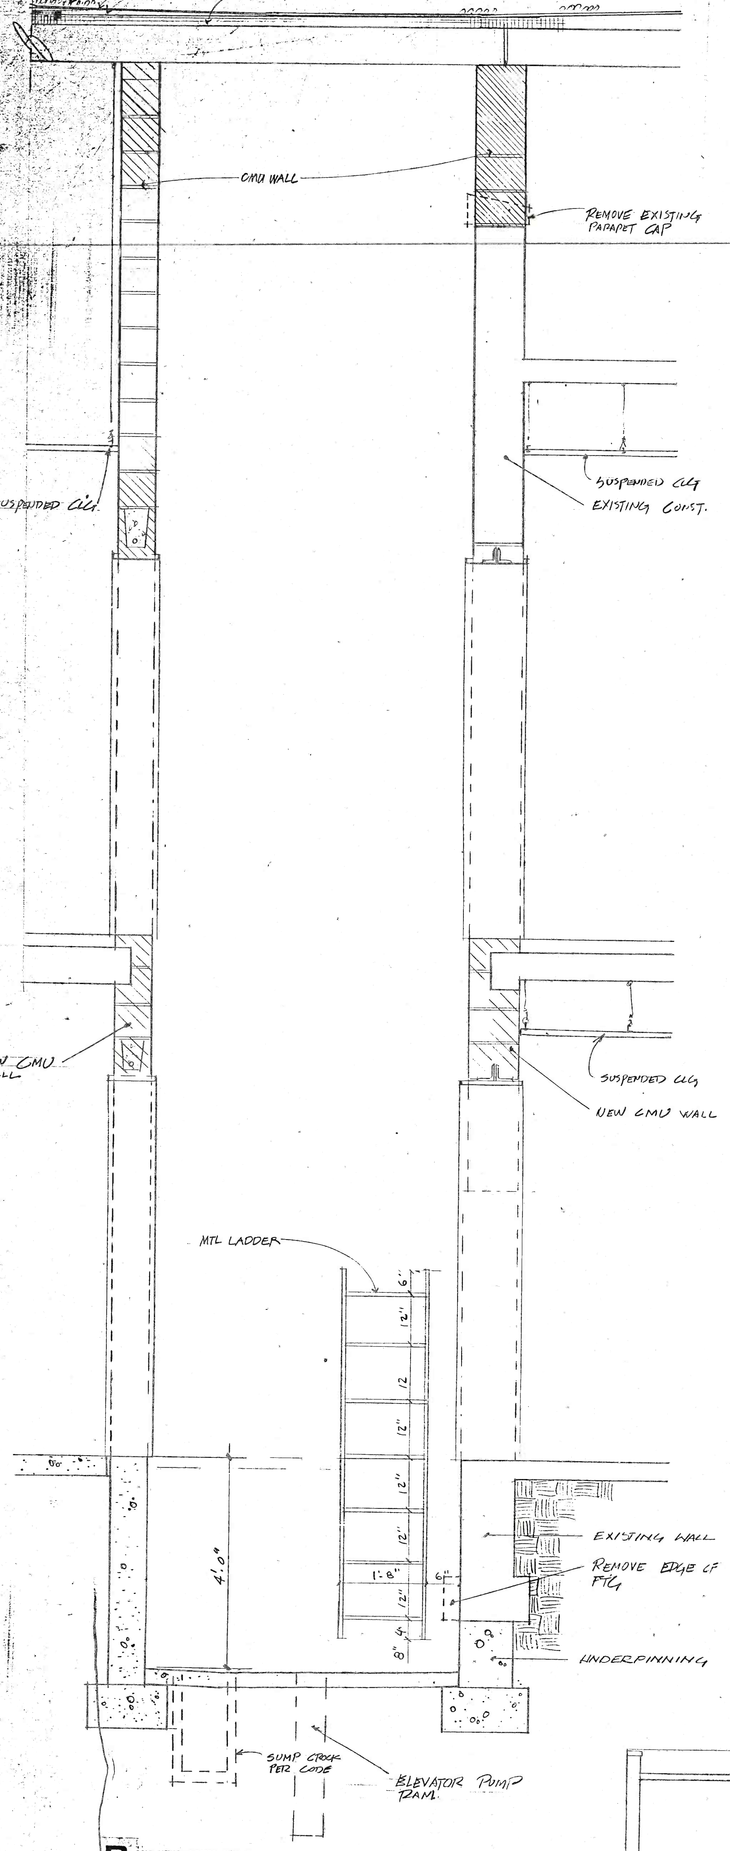



B WALL SECTION
THRU ELEVATOR NO.1 3/4" = 1'-0"

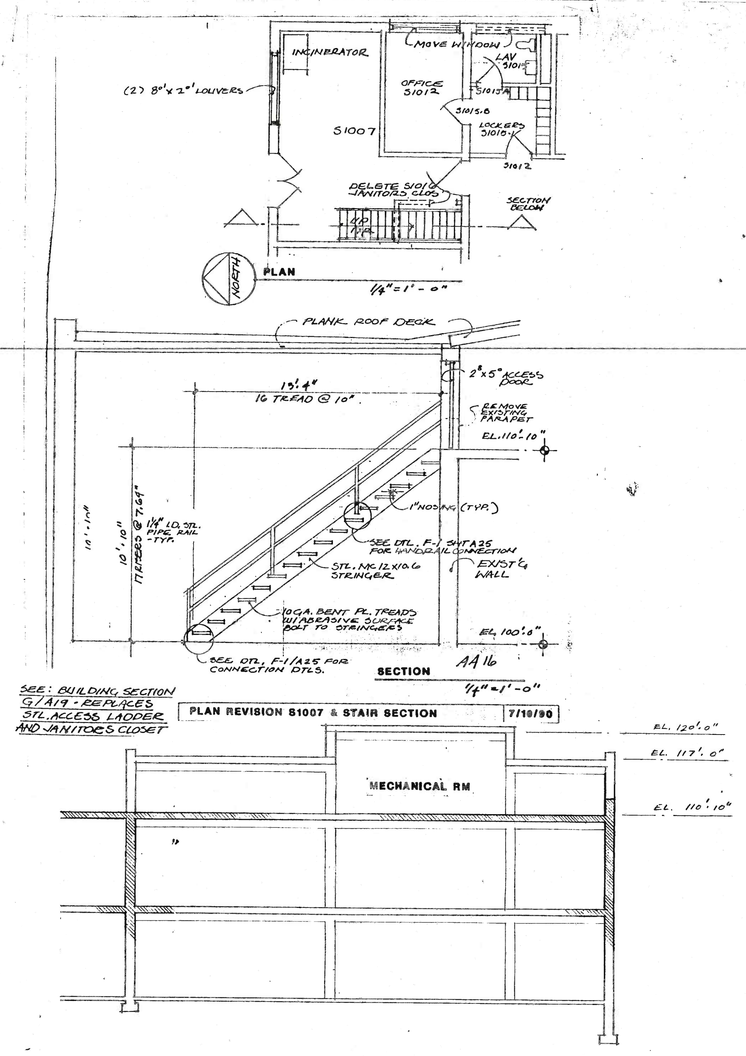



PLAN REVISION S1007 & STAIR SECTION 7/18/90


H PARTIAL BUILDING SECTION
1/8" = 1'-0"

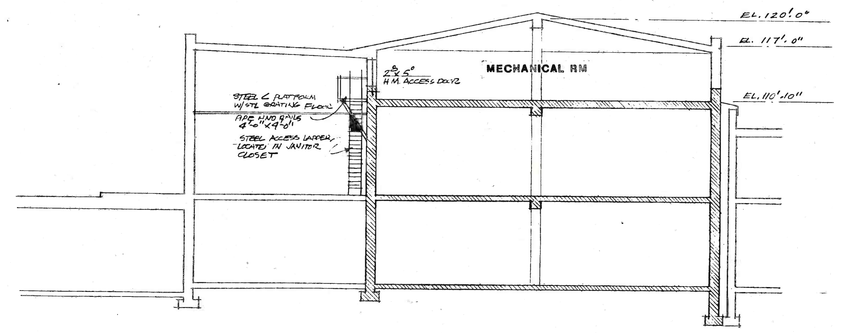

G PARTIAL BUILDING SECTION
1/8" = 1'-0"

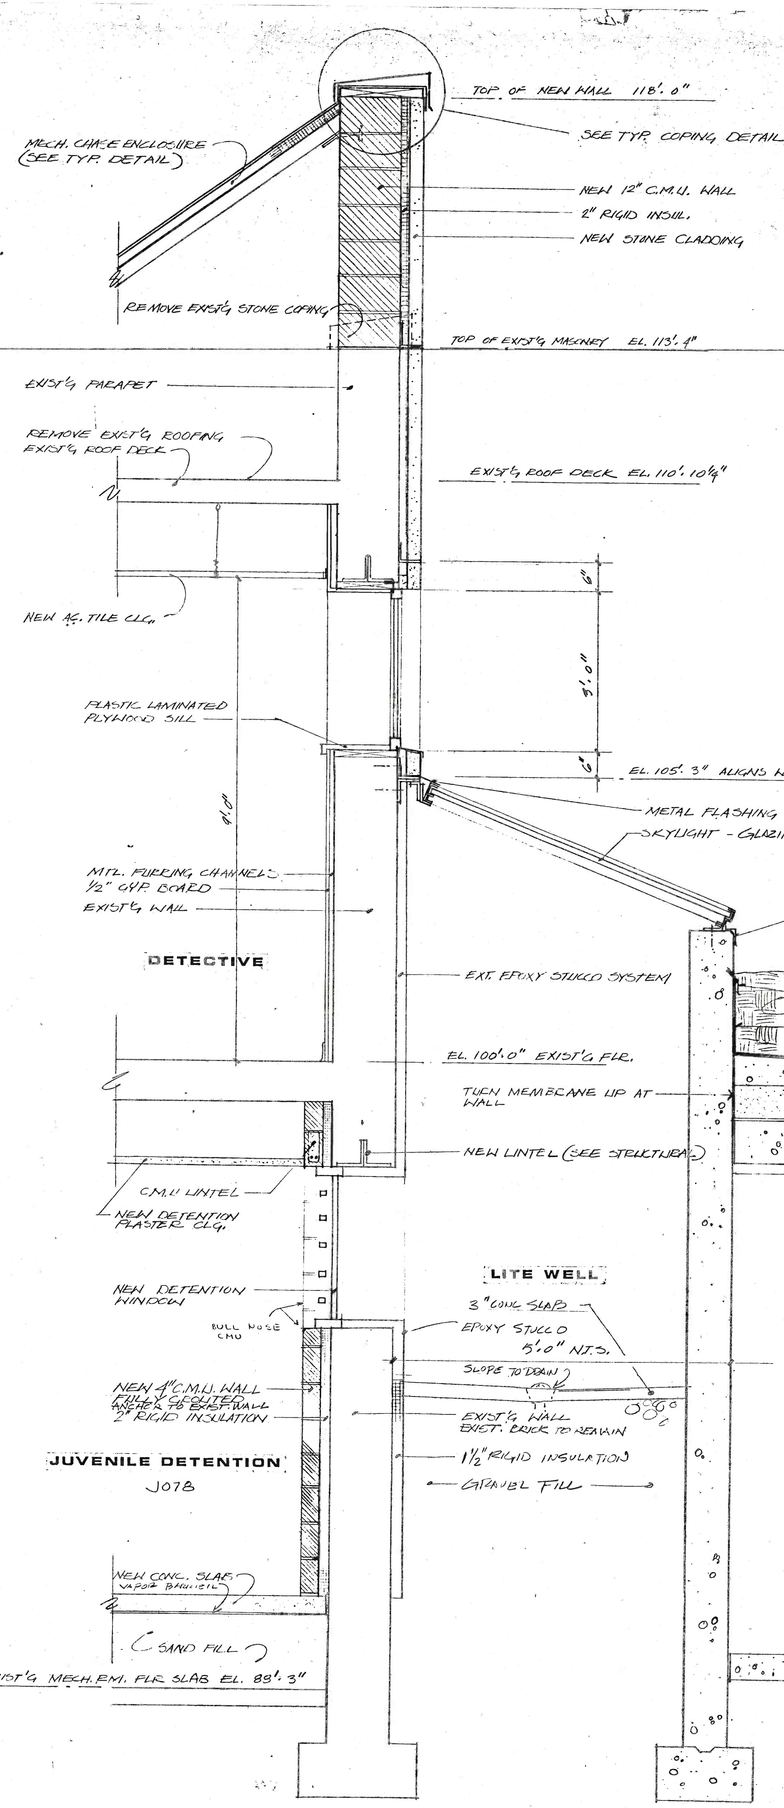

A WALL SECTION
THRU LITE WELL 3/4" = 1'-0"

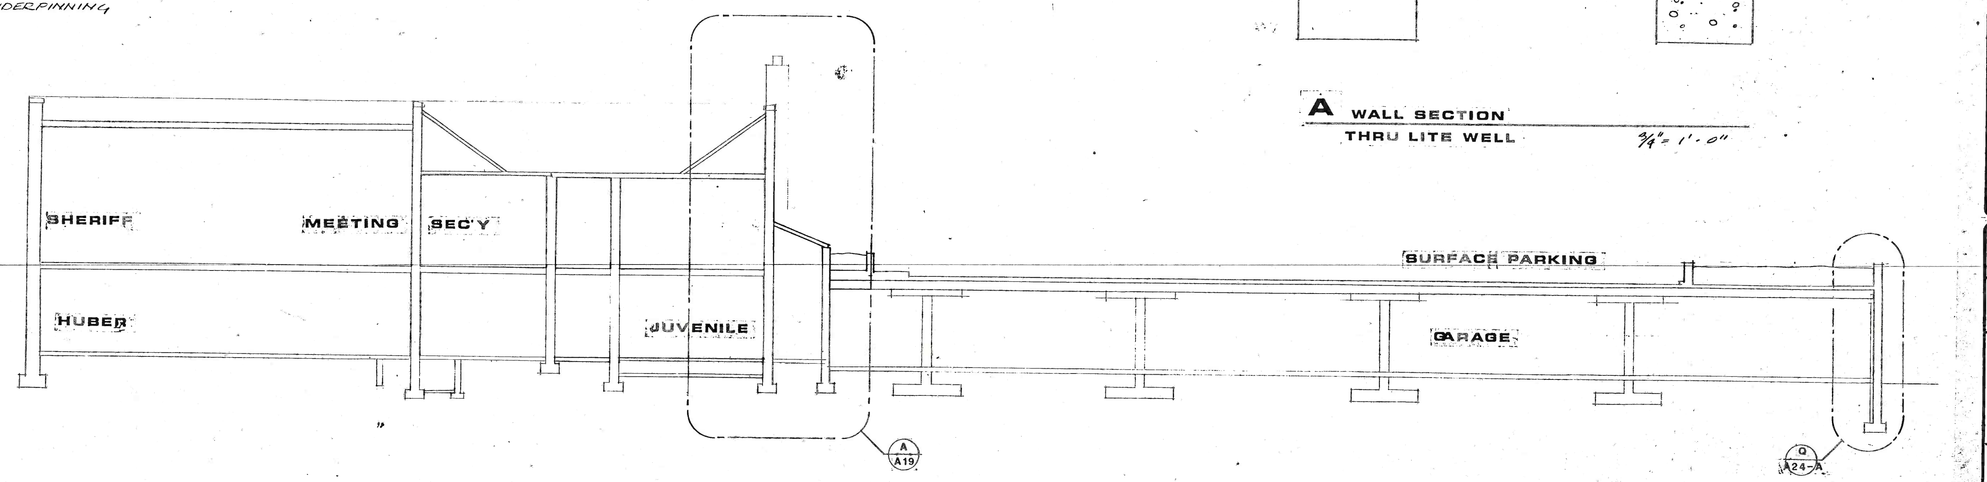

BUILDING SECTION F
SCALE: 1/8"=1'-0"

AS BUILT
DEC 6, 1994

DATE	REVISION

STRUCTURAL CONSULTANT

MECHANICAL CONSULTANT

ARCHITECT
KENTON PETERS + ASSOC., INC.
44 E MIFFLIN
MADISON, WISCONSIN 53703
(608) 255-5656

JEFFERSON COUNTY LAW ENFORCEMENT
JEFFERSON, WISCONSIN

BUILDING SECTION
WALL SECTIONS & DETAILS
SCALE: VARIES

PROJECT NO. 9117
SHEET NO. A19