

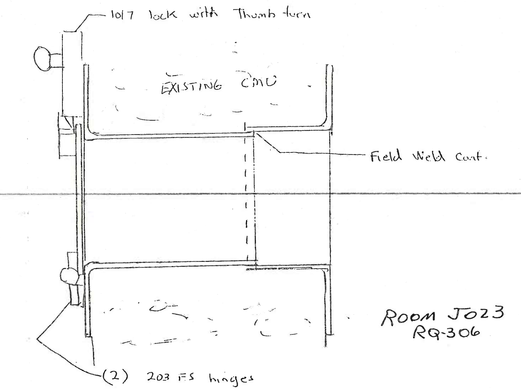



ROOM J023
RQ-306

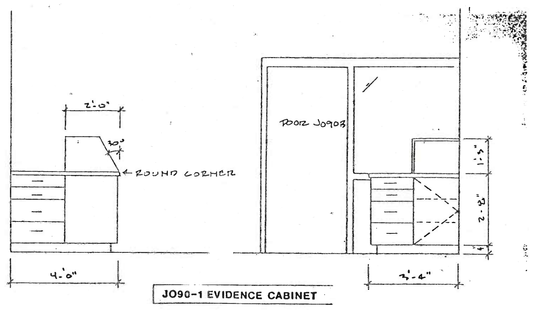

J090-1 EVIDENCE CABINET

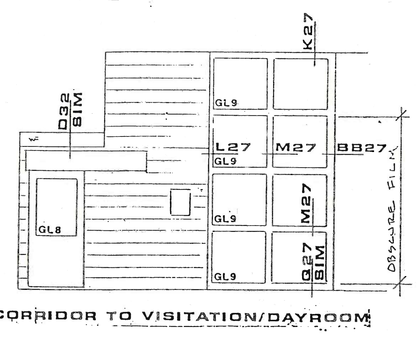


M CORRIDOR TO VISITATION/DAYROOM

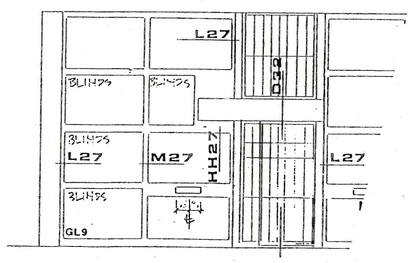



DAYROOM J141 FRONT

KENTON PETERS + ASSOC. 44 E MIFFLIN MADISON, WISCONSIN 53703 (608) 255-5656	JEFFERSON COUNTY LAW ENFORCEMENT CENTER JEFFERSON, WISCONSIN	G189

RQ321
8/30/91

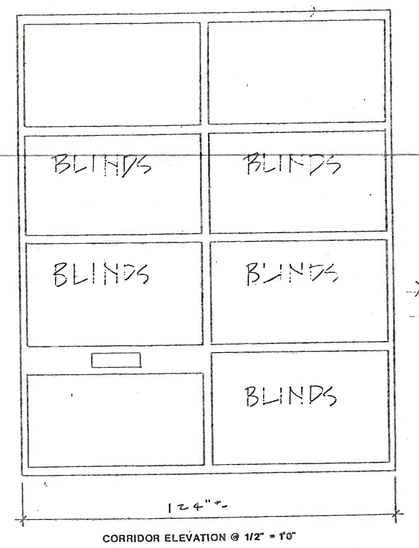

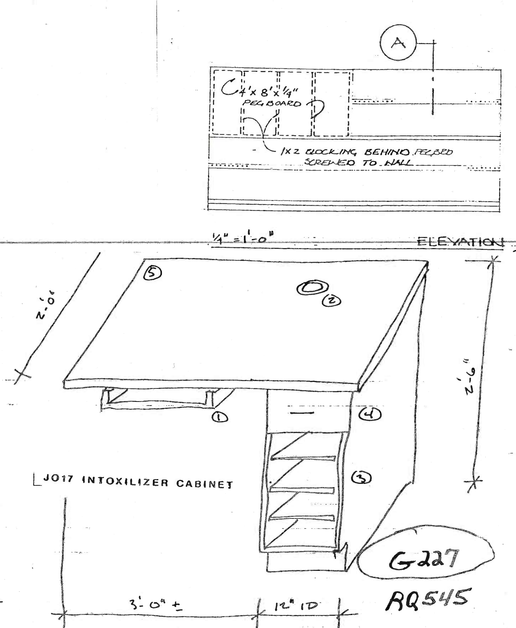

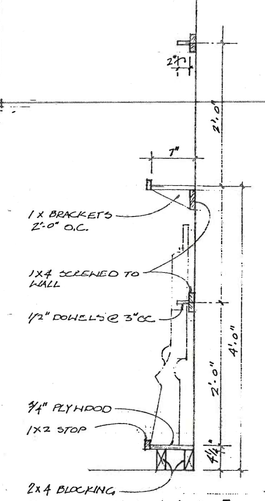

DAYROOM J100 FRONT


KENTON PETERS + ASSOC. 44 E MIFFLIN MADISON, WISCONSIN 53703 (608) 255-5656	JEFFERSON COUNTY LAW ENFORCEMENT CENTER JEFFERSON, WISCONSIN	G188

8/30/91

J089 GUN RACK

KENTON PETERS + ASSOC. 44 E MIFFLIN MADISON, WISCONSIN 53703	JEFFERSON COUNTY LAW ENFORCEMENT CENTER JEFFERSON, WISCONSIN	G183


7/23/91

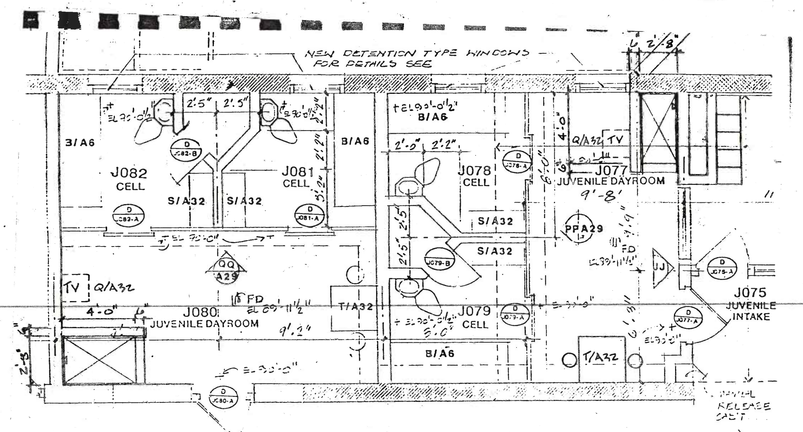



NOTE: ELEV OF TWO GUARDS TO HAVE 12"x12" CERAMIC TILE, DETENTION GRADE, AND SHOWER HEAD; GLASS & CMU: BASE HOUSE, AND 8' HIGH GLASS & CMU CUBES, SEE EL TO EL = Q/A26 FOR CONSTRUCTION DETAILS

REVISE J077 AND J088, JUVENILE DETENTION DAYROOMS, TO INCLUDE SHOWER STALLS


SHOWER STALLS IN J077 AND J080		7/10/90
KENTON PETERS + ASSOC. 44 E MIFFLIN MADISON, WISCONSIN 53703 (608) 255-5656	JEFFERSON COUNTY LAW ENFORCEMENT CENTER JEFFERSON, WISCONSIN	AA63

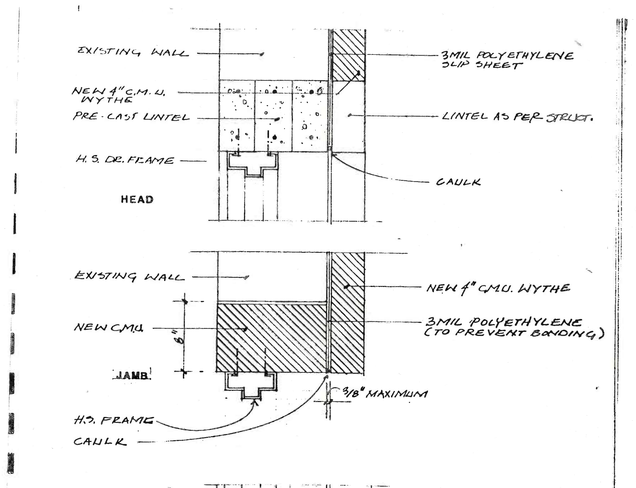


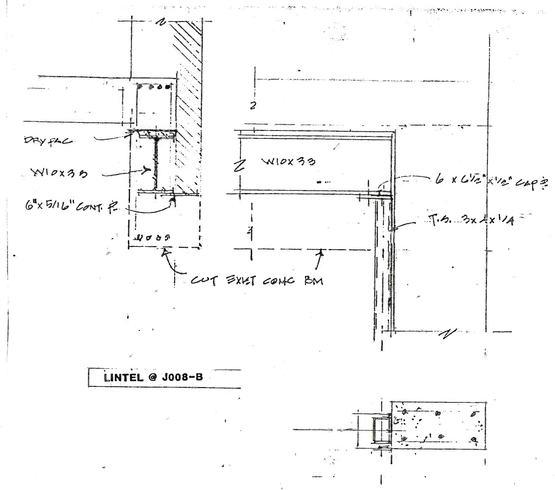


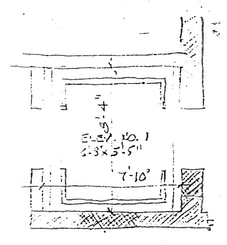


9-13-90
G8

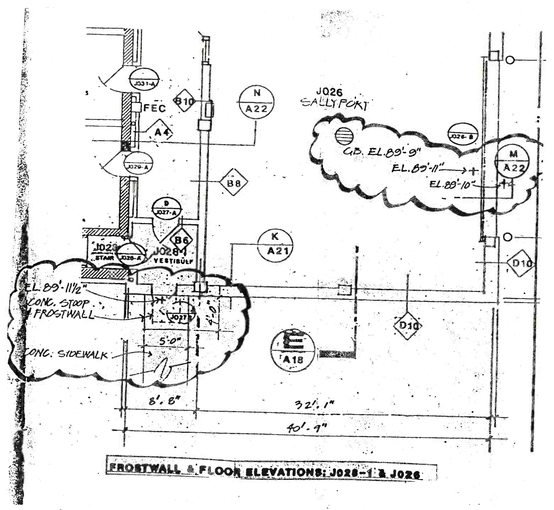


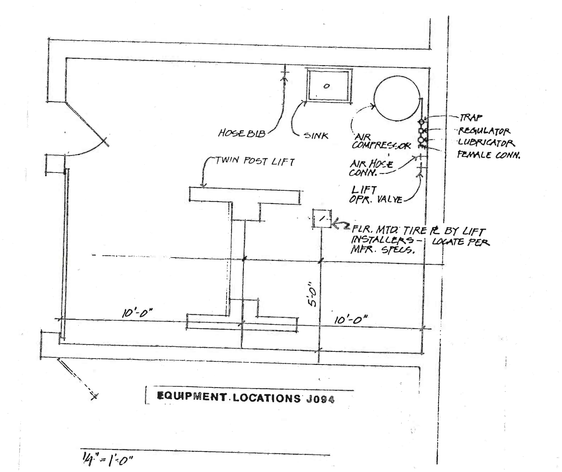


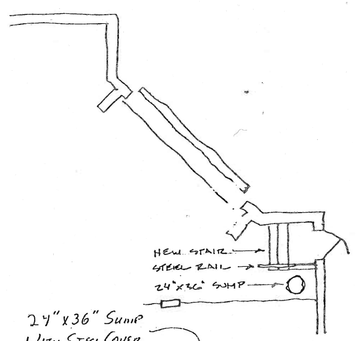


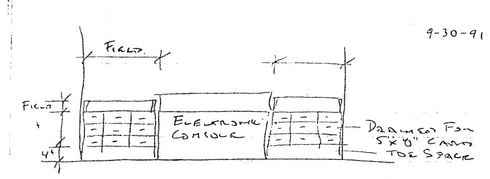



9-30-91

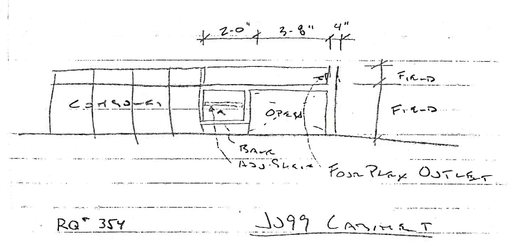

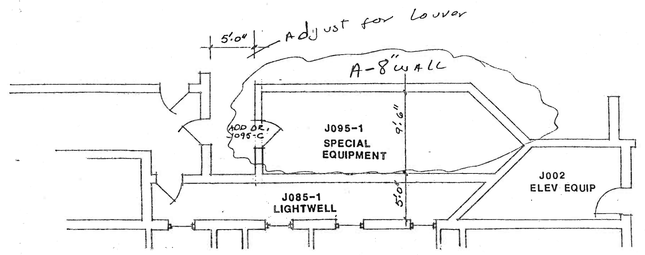


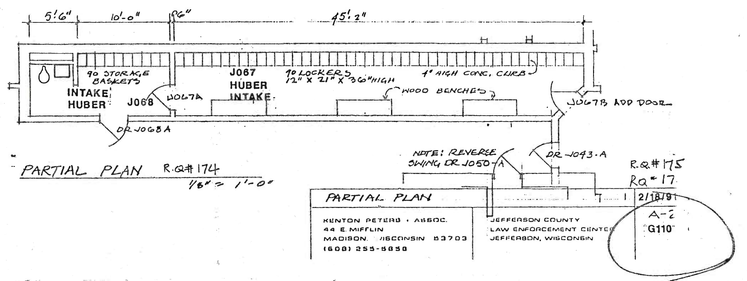

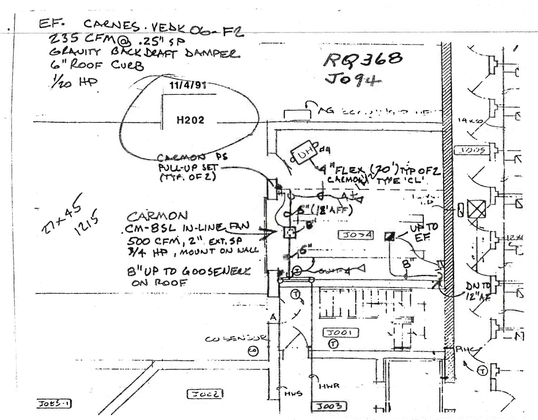

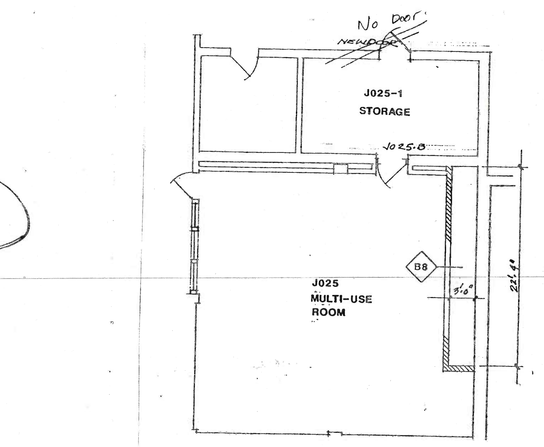

G108

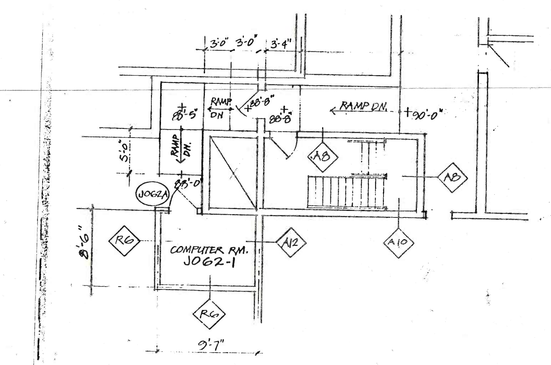

7/10/90
AA52

AS BUILT
DEC 6, 1994

KENTON PETERS + ASSOCIATES, INC. 324 SOUTH HAMILTON STREET MADISON, WI 53703 (608) 255-5656		A2 SUPPLEMENTARY DRAWINGS