


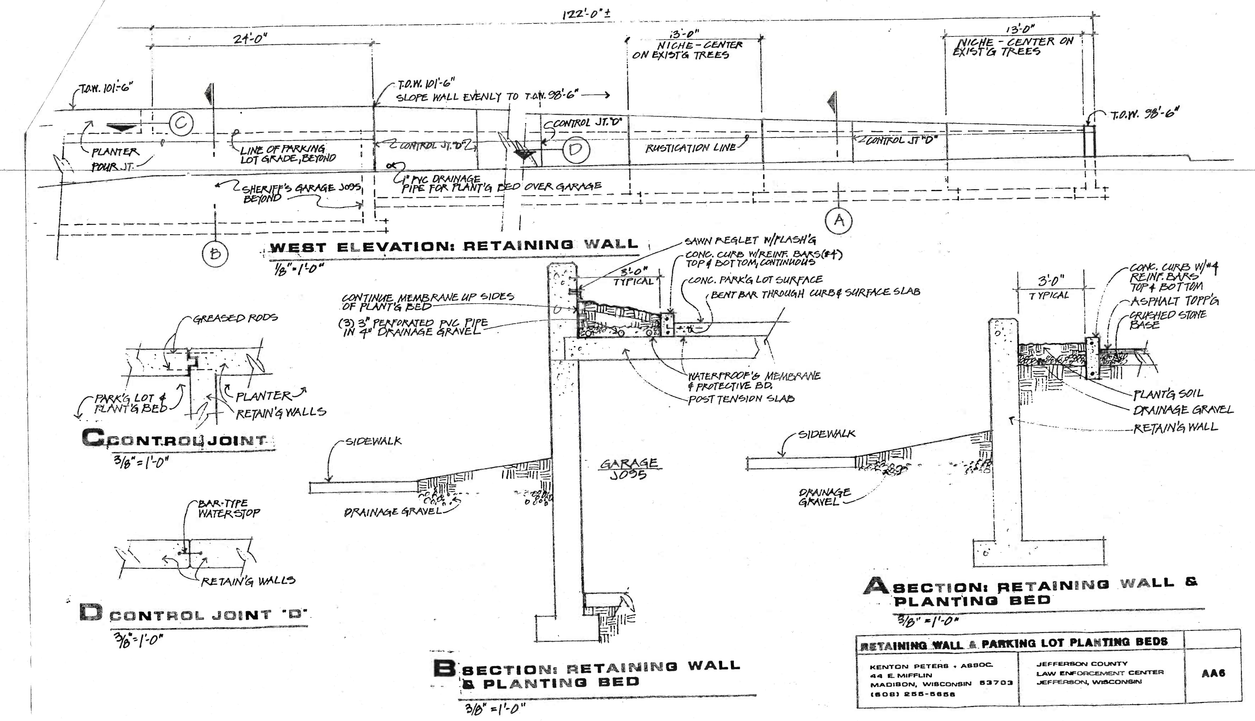


RETAINING WALL & PARKING LOT PLANTING BEDS		
KENTON PETERS + ASSOC. 44 E. MIFFLIN MADISON, WISCONSIN 53703 (608) 255-5656	JEFFERSON COUNTY LAW ENFORCEMENT CENTER JEFFERSON, WISCONSIN	AA6

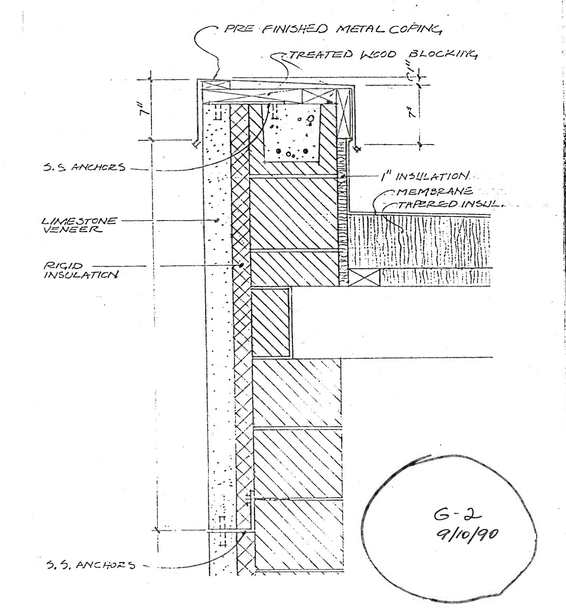

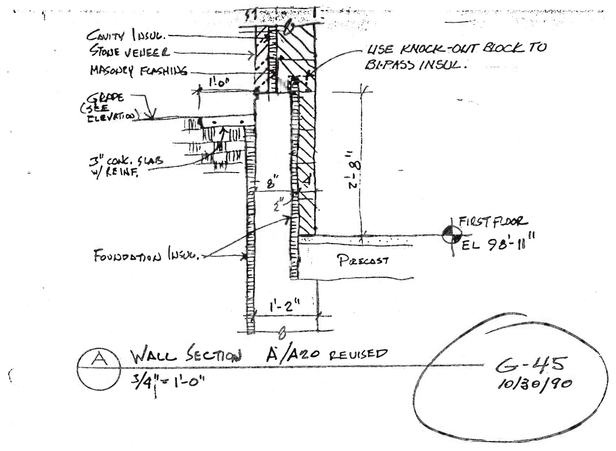

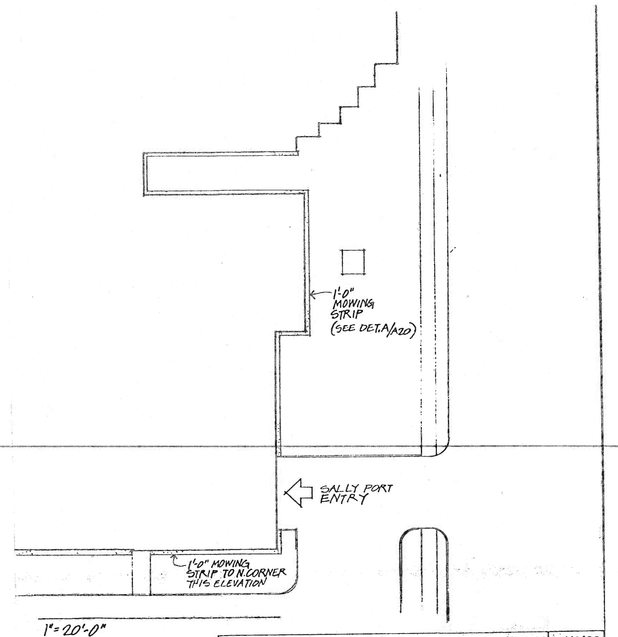

CONCRETE MOWING STRIP		7/10/90
KENTON PETERS + ASSOC. 44 E. MIFFLIN MADISON, WISCONSIN 53703 (608) 255-5656	JEFFERSON COUNTY LAW ENFORCEMENT CENTER JEFFERSON, WISCONSIN	AA48

KENTON PETERS + ASSOCIATES, INC. 324 SOUTH HAMILTON STREET MADISON, WI 53703 (608) 255-5656	A20 SUPPLEMENTARY DRAWINGS

AS BUILT
DEC 6, 1994