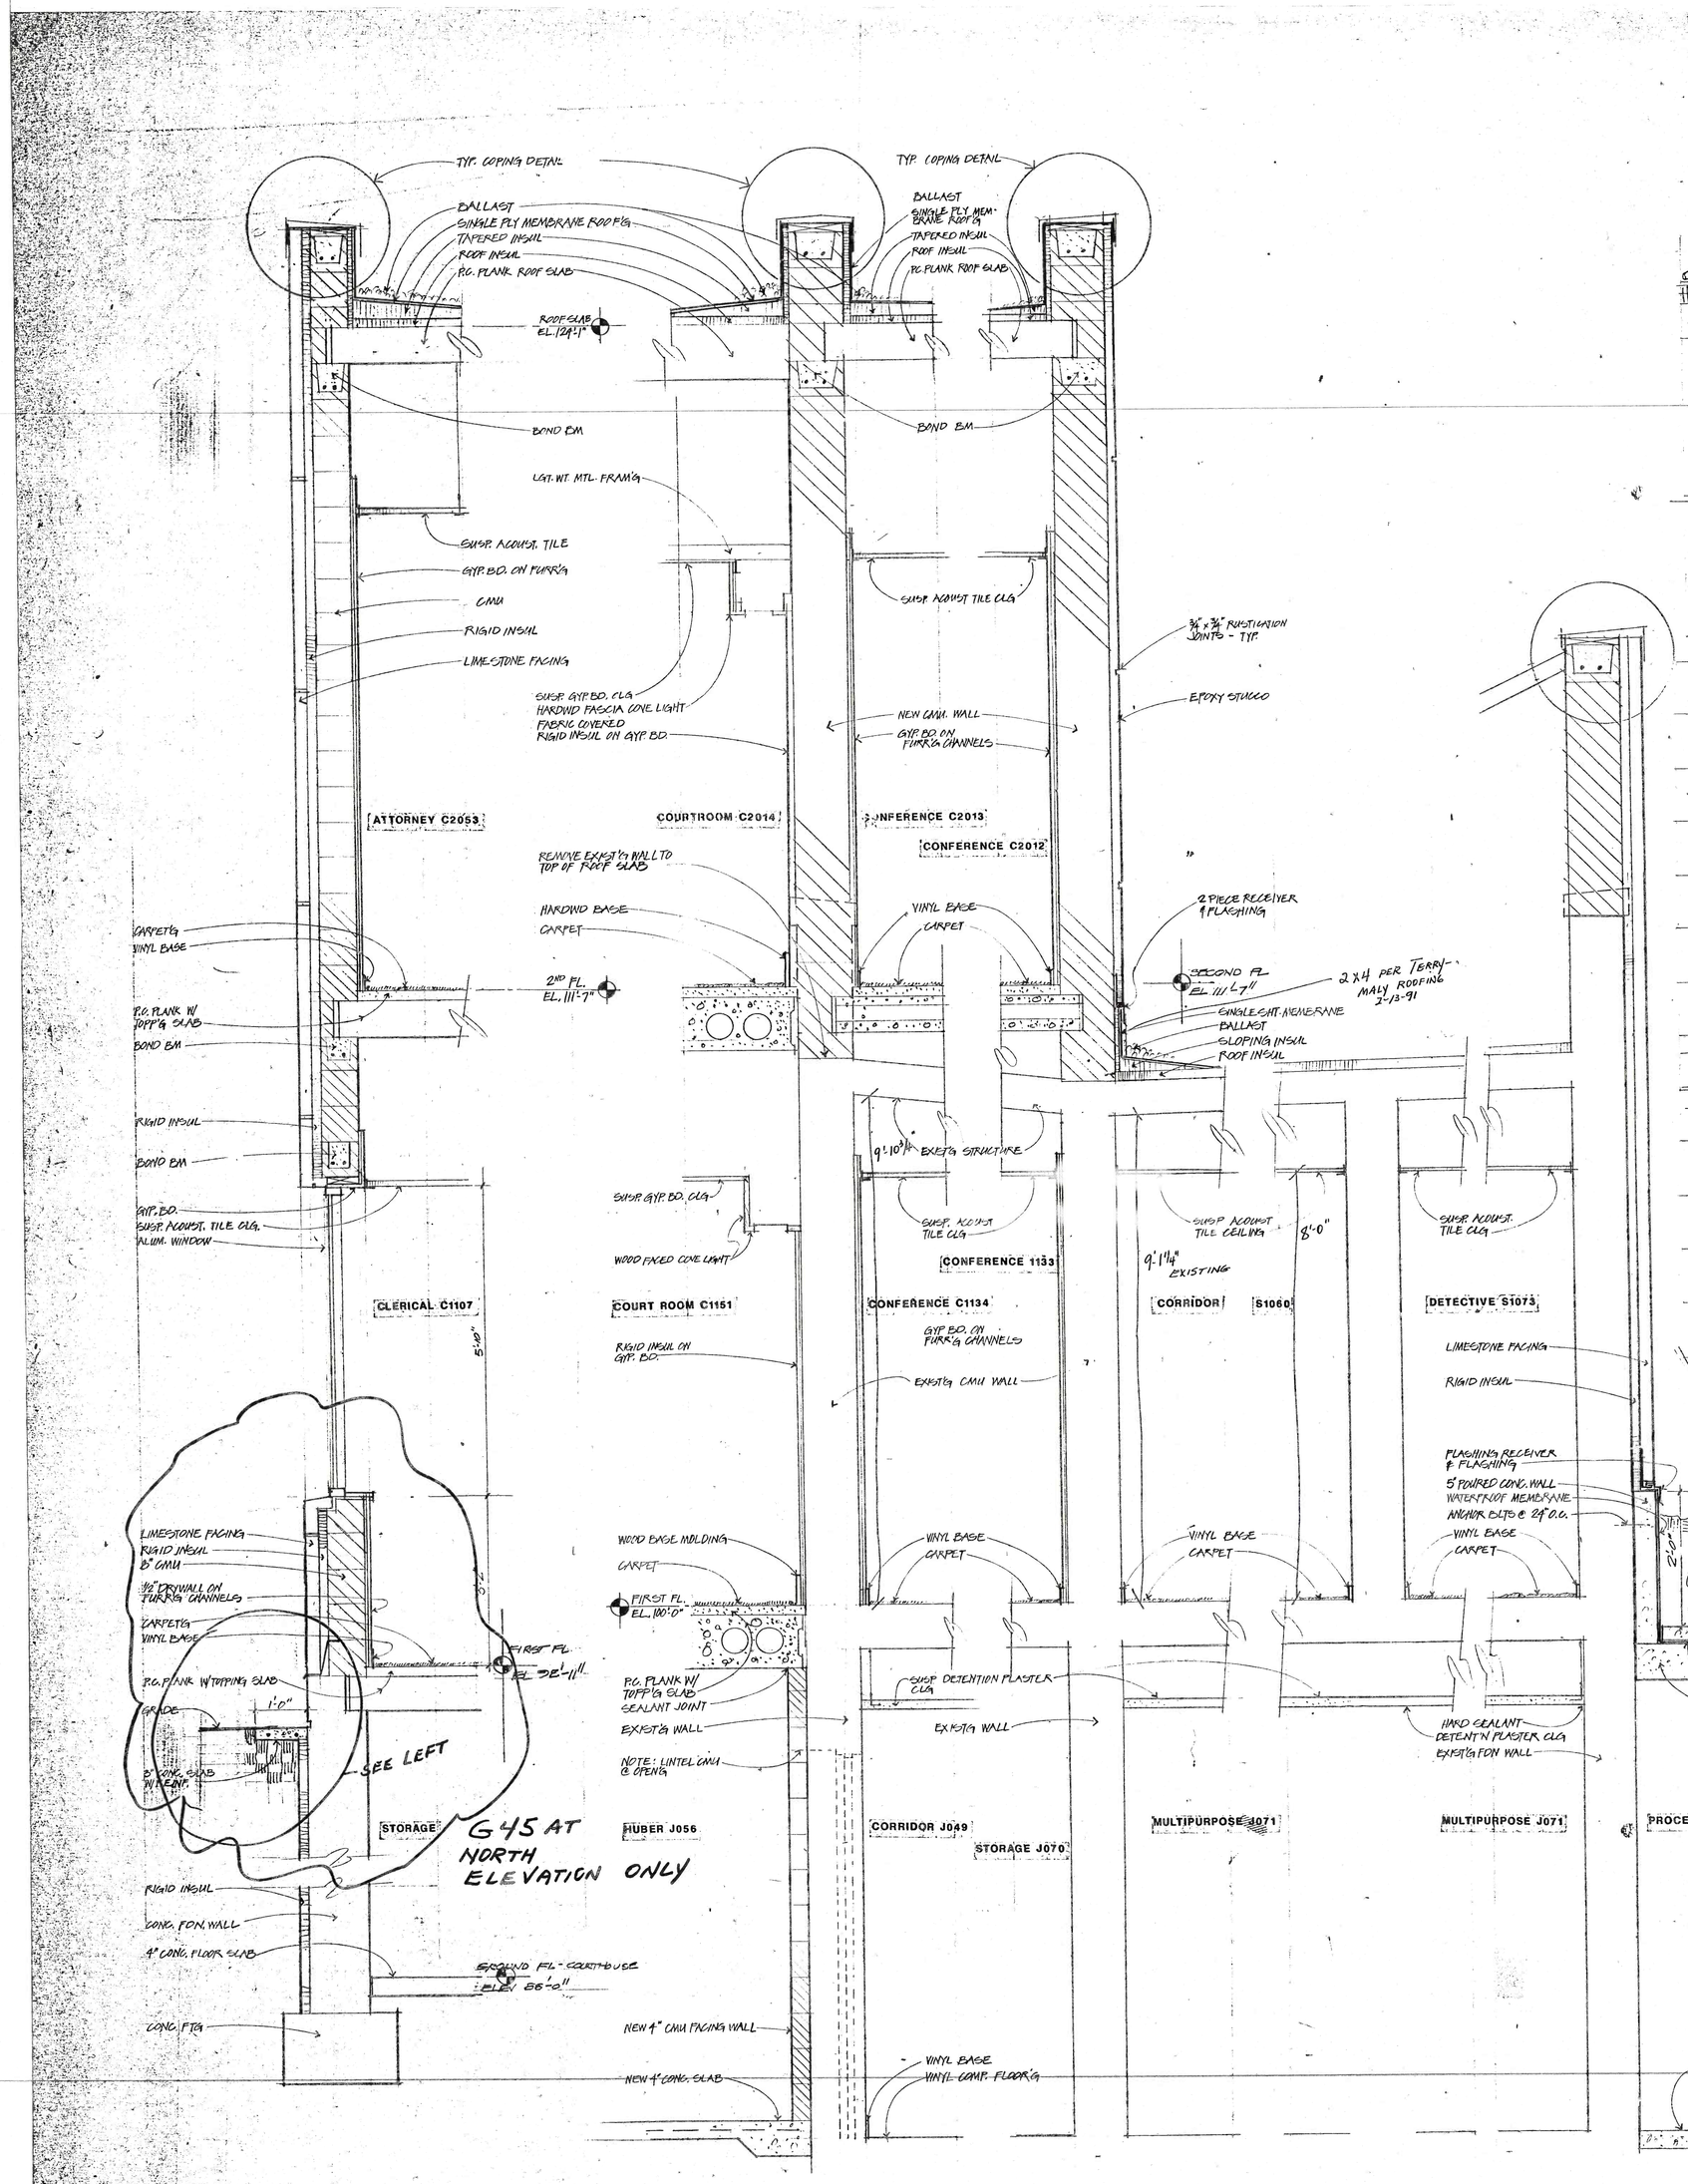


A WALL SECTION

B WALL SECTION

C WALL SECTION

D WALL SECTION

E WALL SECTION

F WALL SECTION

DATE	REVISION

STRUCTURAL CONSULTANT

MECHANICAL CONSULTANT

ARCHITECT

KENTON-PETERS + ASSOC., INC.
44 E. MIFFLIN
MADISON, WISCONSIN 53703
(608) 255-5856

JEFFERSON COUNTY
LAW ENFORCEMENT CENTER
JEFFERSON, WISCONSIN

P-11-90

WALL SECTIONS
3/4"=1'-0"
STUCCO DETAILS

A20

AS BUILT
DEC 6, 1994