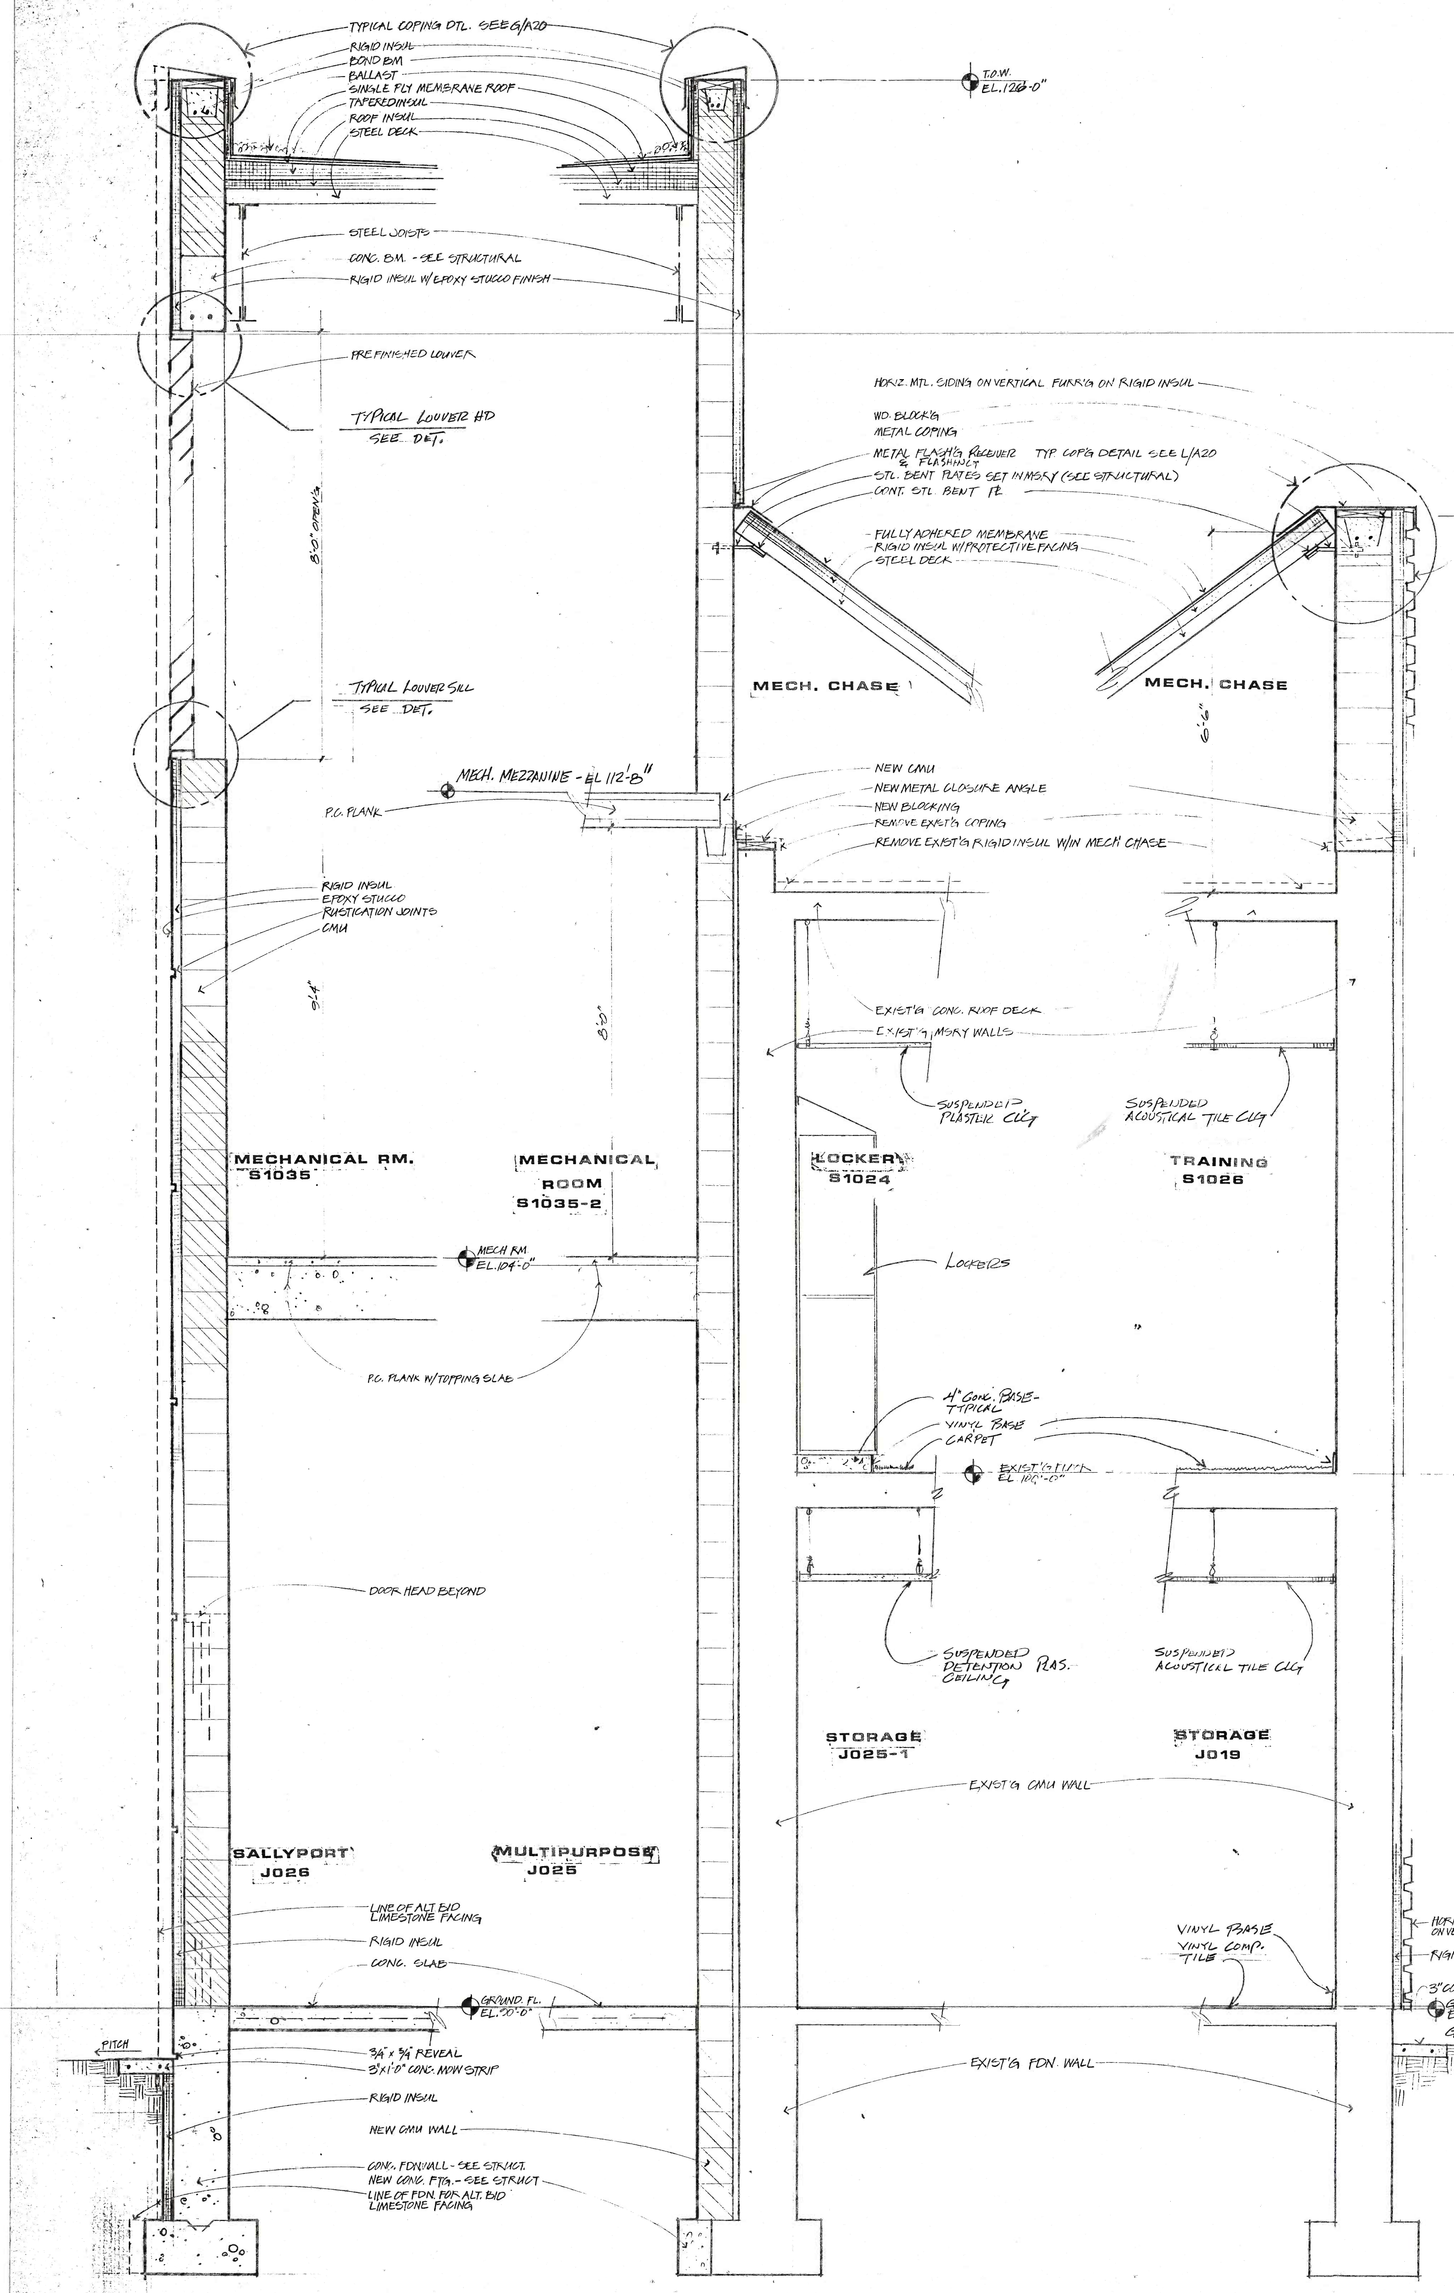



AS BUILT
DEC 6, 1994

| DATE | REVISION |
|---|---|
| | |

STRUCTURAL CONSULTANT

MECHANICAL CONSULTANT

ARCHITECT

KENTON PETERS + ASSOC., INC.
44 E MIFFLIN
MADISON, WISCONSIN 53703
(608) 255-5656

JEFFERSON COUNTY

LAW ENFORCEMENT CENTER

JEFFERSON, WISCONSIN

WALL SECTIONS

3/4" = 1'-0"

8-11-00

A21