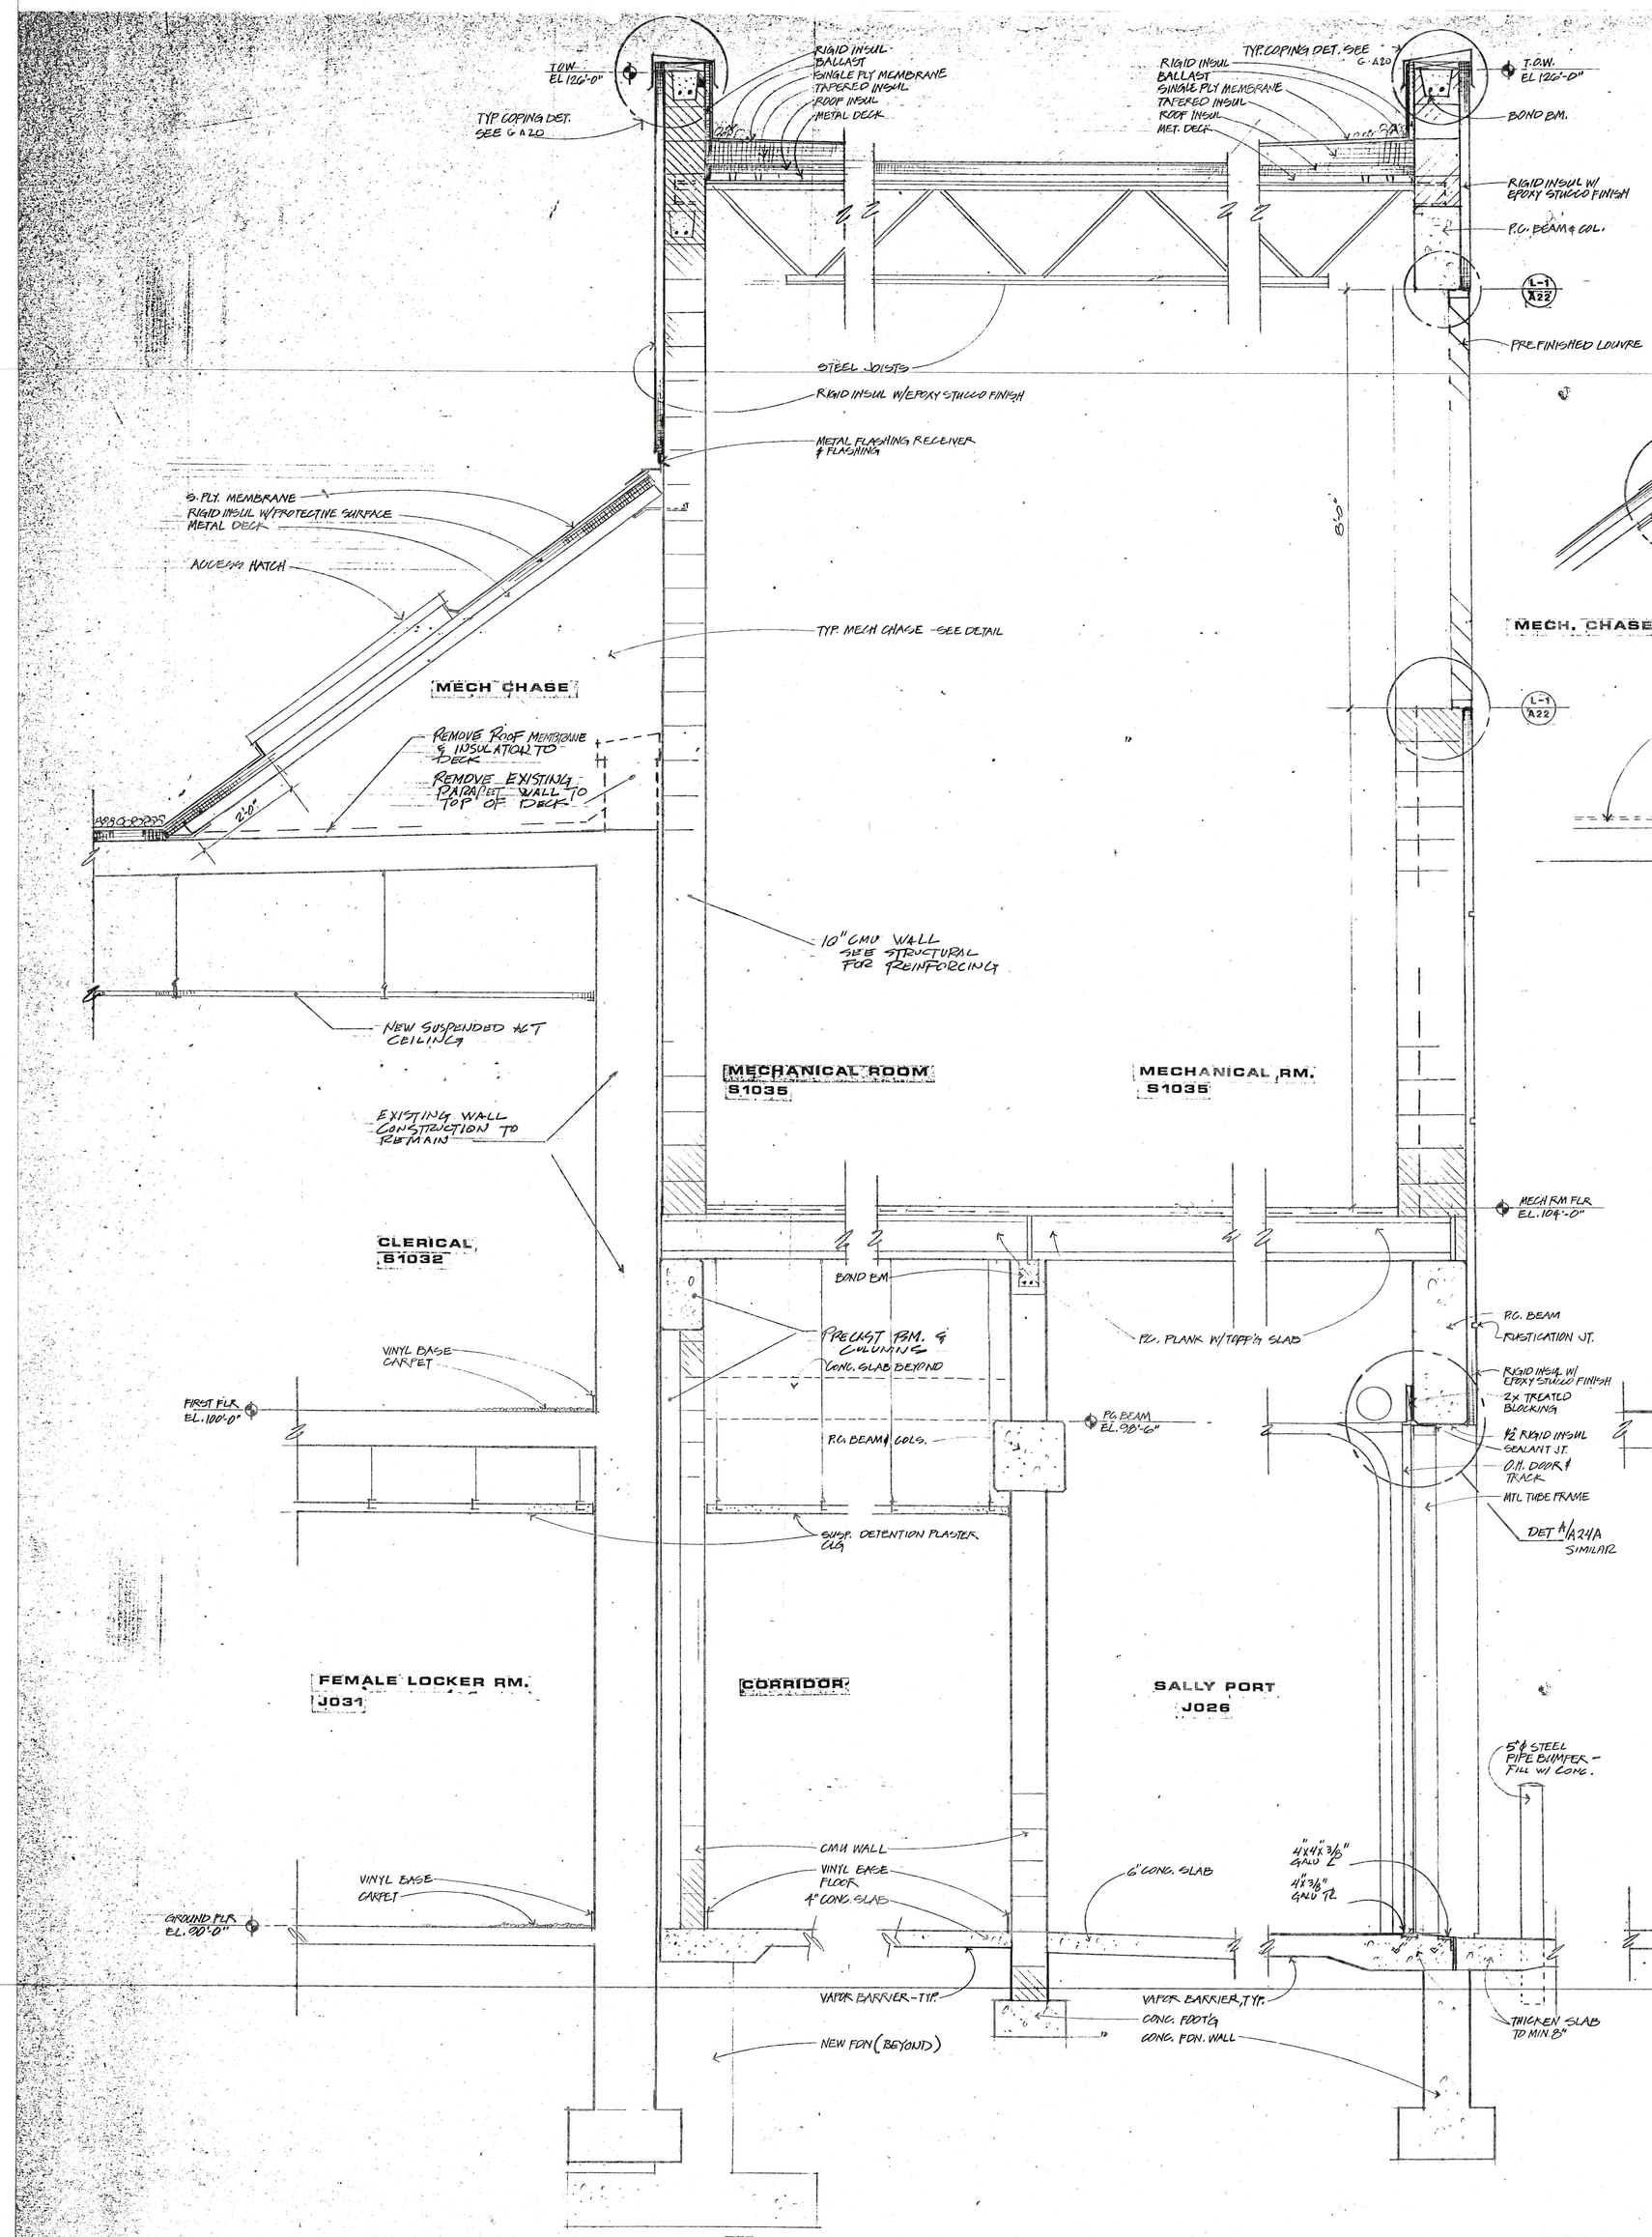


DATE	REVISION

STRUCTURAL CONSULTANT

MECHANICAL CONSULTANT

ARCHITECT
KENTON PETERS + ASSOC., INC.
44 E MIFFLIN
MADISON, WISCONSIN 53703
(608) 255-5656

JEFFERSON COUNTY
LAW ENFORCEMENT CENTER
JEFFERSON, WISCONSIN

WALL SECTIONS

8/74 - 4'-0"

A22

AS BUILT
DEC 6, 1994