
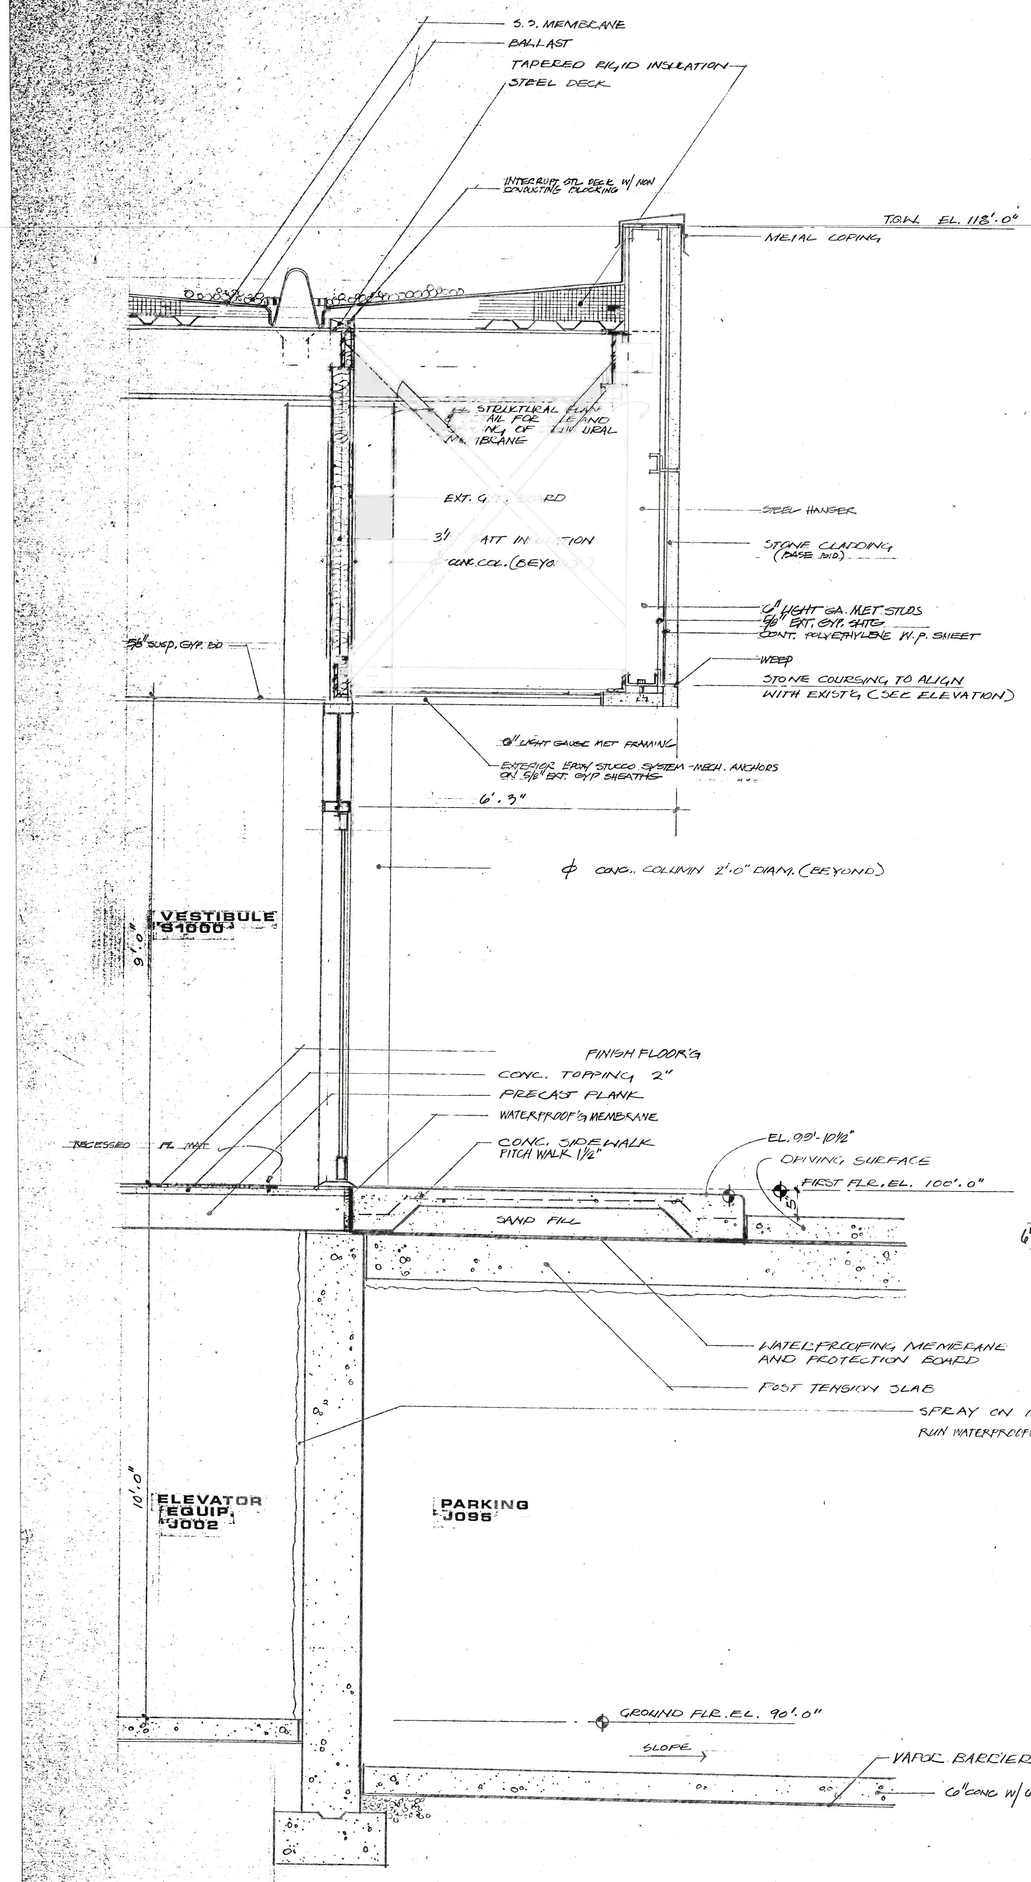


D SECTION THRU ENTRANCE SHERIFF'S DEPARTMENT 3/4" = 1'-0"

C SECTION THRU NORTH WALL PARKING GARAGE 3/4" = 1'-0"

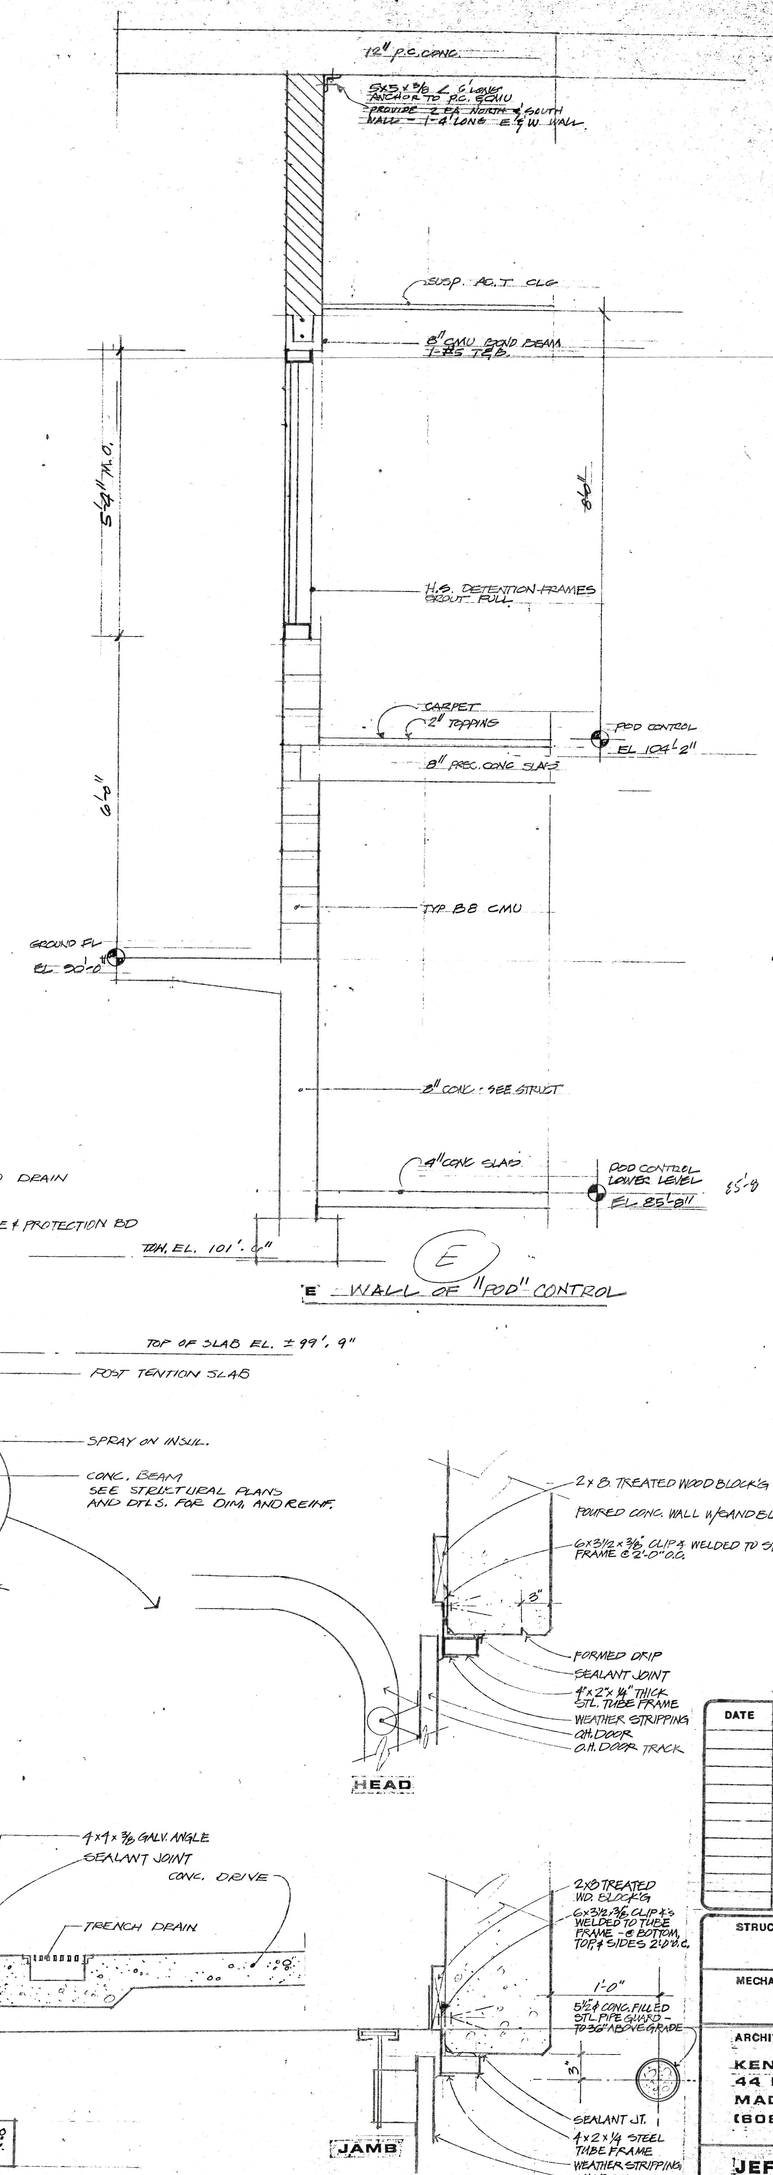

E WALL OF "ROD" CONTROL

HEAD

JAMB

B SECTION THRU ENTRANCE PARKING GARAGE 3/4" = 1'-0"

A OVERHEAD DOOR DETAILS 1-1/2" = 1'-0"

AS BUILT
DEC 6, 1994

DATE	REVISION

STRUCTURAL CONSULTANT

MECHANICAL CONSULTANT

ARCHITECT
KENTON PETERS + ASSOC., INC.
44 E MIFFLIN
MADISON, WISCONSIN 53703
(608) 255-5656

JEFFERSON COUNTY
LAW ENFORCEMENT CENTER
JEFFERSON, WISCONSIN

WALL SECTIONS

6-1-93
A24
A
A24A