



A GROUND FLOOR SHOWER STALL CEILING
1/2" = 1'-0"

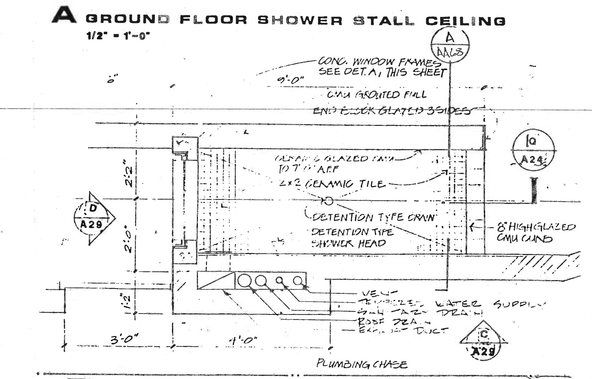

D SHOWER - PLAN
1/2" = 1'-0"


SHOWER STALL CEILING CONSTRUCTION		7/19/90
KENTON PETERS + ASSOC. 44 E MIFFLIN	JEFFERSON COUNTY LAW ENFORCEMENT CENTER	AA68

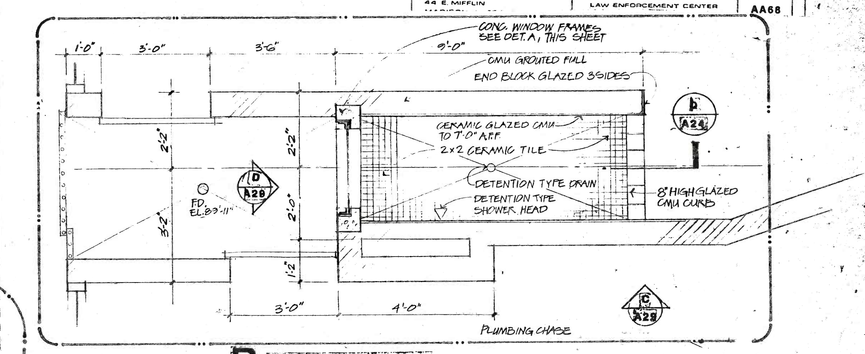


D SHOWER - PLAN
1/2" = 1'-0"




A SILL DETAIL (JAMB & HEAD SIM.)
1-1/2" = 1'-0"

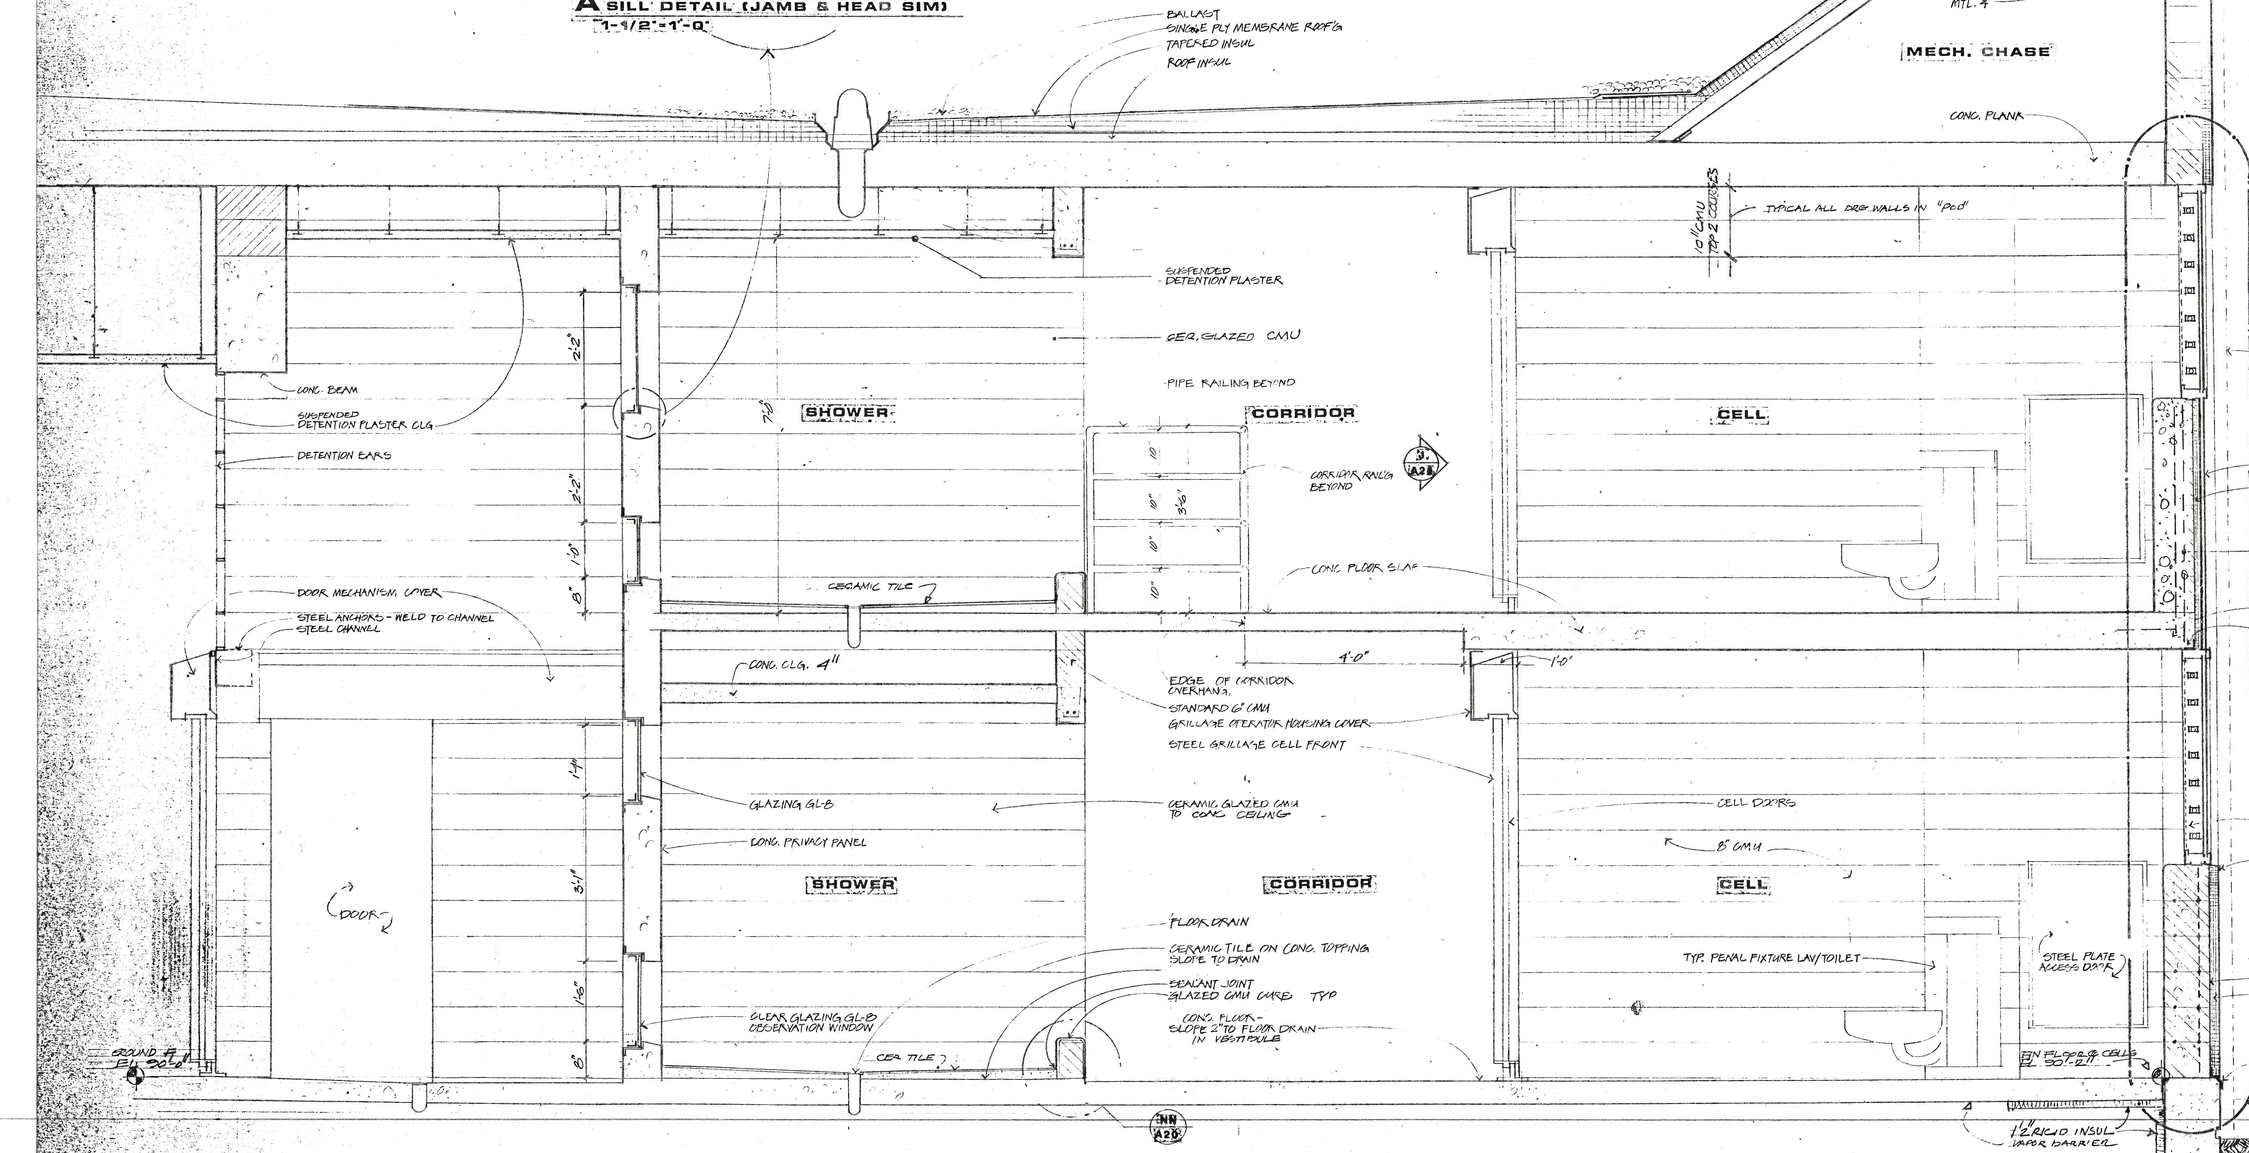

Q WALL SECTION
3/4" = 1'-0"

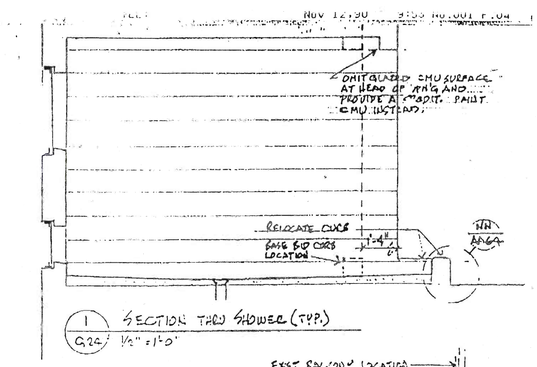

1 SECTION THRU SHOWER (TYP.)
Q24 1/4" = 1'-0"

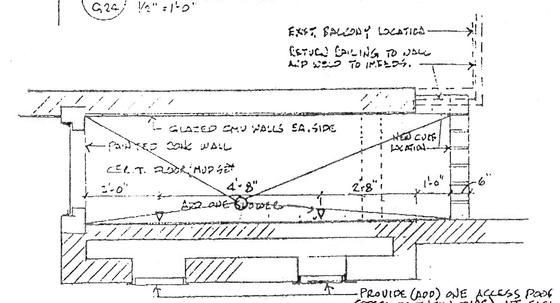

2 PLAN OF JAIL SHOWER (TYP.)
Q24 1/4" = 1'-0"

JAIL SHOWER REVISIONS		11/9/90
KENTON PETERS + ASSOC. 44 E MIFFLIN MADISON, WISCONSIN 53703	JEFFERSON COUNTY LAW ENFORCEMENT CENTER JEFFERSON, WISCONSIN	064

STRUCTURAL CONSULTANT

MECHANICAL CONSULTANT

ARCHITECT
KENTON PETERS + ASSOC., INC.
44 E MIFFLIN
MADISON, WISCONSIN 53703
(608) 255-5656

JEFFERSON COUNTY
LAW ENFORCEMENT CENTER
JEFFERSON, WISCONSIN

WALL SECTIONS — 5-11-90
3/4" = 1'-0" — A24

AS BUILT
DEC 6, 1994