

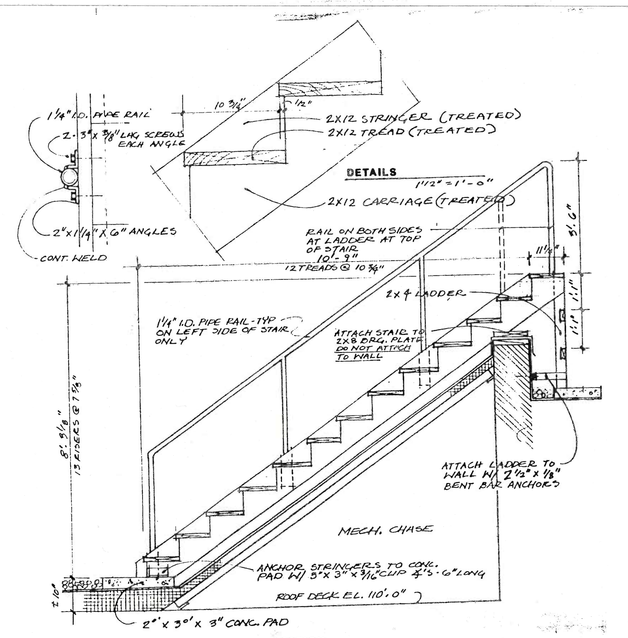


ROOF ACCESS STEPS – SECTION & DETAILS		7/10/90
KENTON PETERS + ASSOC. 44 E. MIFFLIN MADISON, WISCONSIN 53703 (608) 255-5656	JEFFERSON COUNTY LAW ENFORCEMENT CENTER JEFFERSON, WISCONSIN	AA16

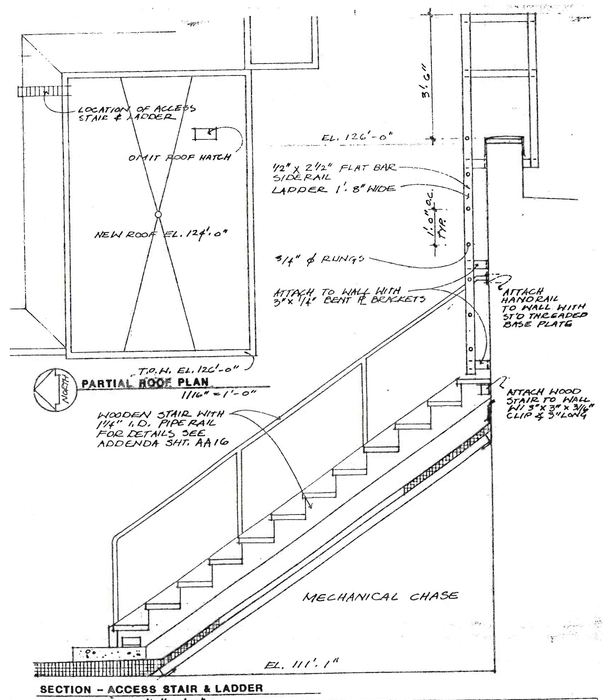


ACCESS STAIR & LADDER		7/10/90
KENTON PETERS + ASSOC. 44 E. MIFFLIN MADISON, WISCONSIN 53703	JEFFERSON COUNTY LAW ENFORCEMENT CENTER JEFFERSON, WISCONSIN	AA17

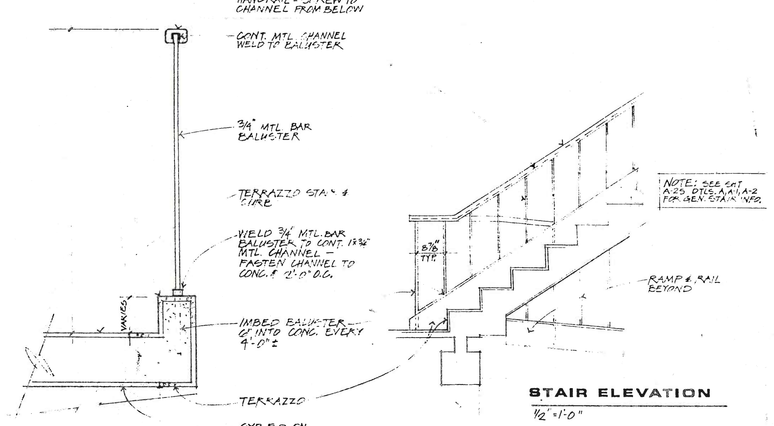

SECTION THRU STAIR & RAIL (RAMP SIMILAR)
1 1/2" = 1'-0"


STAIR RAILING DETAIL C2010		7/10/90
KENTON PETERS + ASSOC. 44 E. MIFFLIN MADISON, WISCONSIN 53703 (608) 255-5656	JEFFERSON COUNTY LAW ENFORCEMENT CENTER JEFFERSON, WISCONSIN	AA15

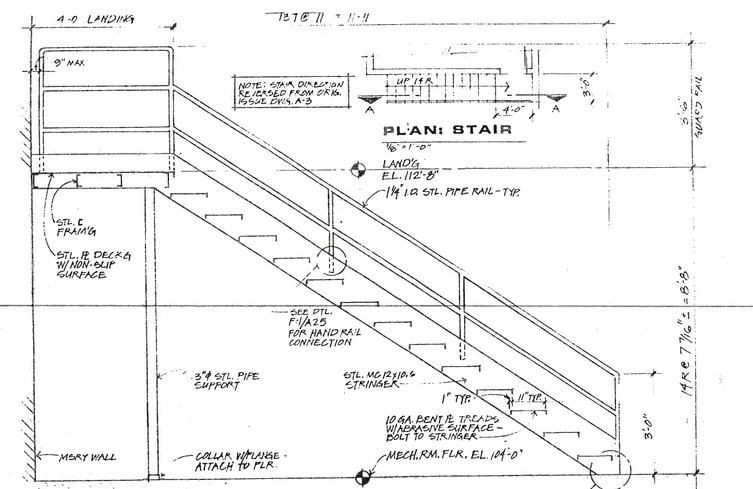


SECTION A-A: STAIR TO RM. 1035-4
SCALE: 1/2" = 1'-0"

STAIR TO RM. S1035-4		7/10/90
KENTON PETERS + ASSOC. 44 E. MIFFLIN MADISON, WISCONSIN 53703 (608) 255-5656	JEFFERSON COUNTY LAW ENFORCEMENT CENTER JEFFERSON, WISCONSIN	AA14

A25

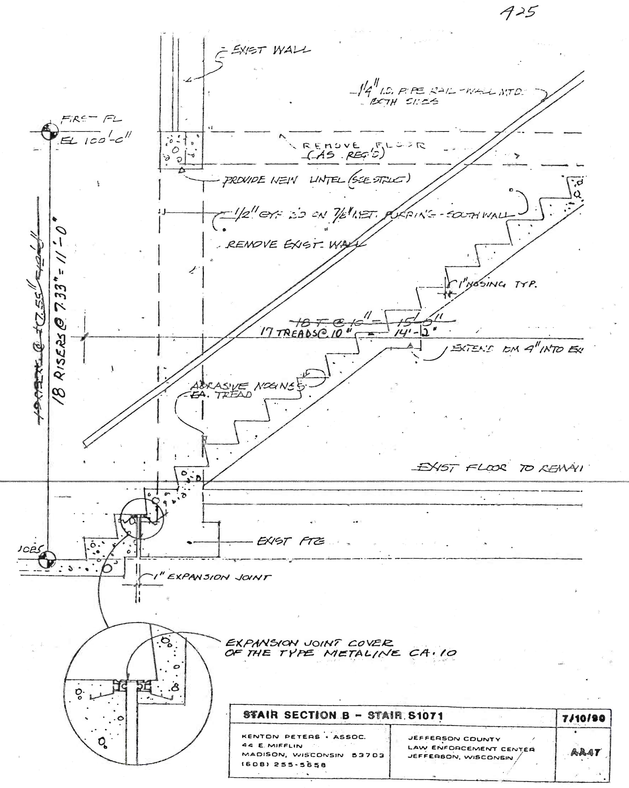

STAIR SECTION B – STAIR S1071		7/10/90
KENTON PETERS + ASSOC. 44 E. MIFFLIN MADISON, WISCONSIN 53703 (608) 255-5656	JEFFERSON COUNTY LAW ENFORCEMENT CENTER JEFFERSON, WISCONSIN	AA47

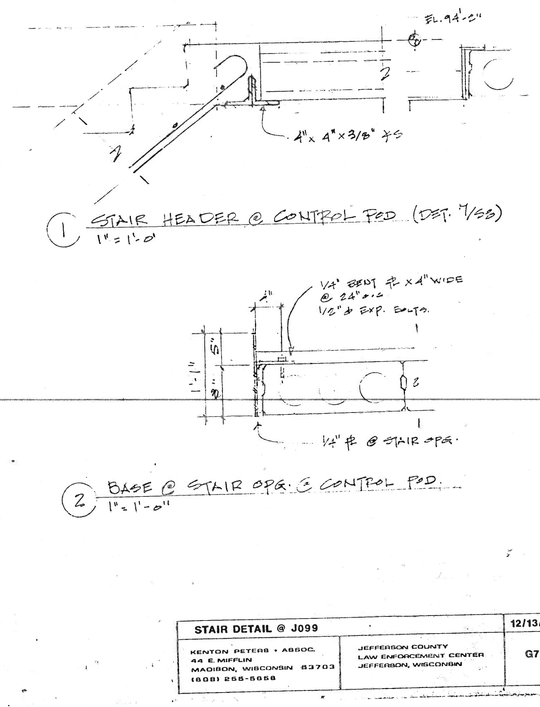

STAIR DETAIL @ J099		12/13/90
KENTON PETERS + ASSOC. 44 E. MIFFLIN MADISON, WISCONSIN 53703 (608) 255-5656	JEFFERSON COUNTY LAW ENFORCEMENT CENTER JEFFERSON, WISCONSIN	G70

KENTON PETERS + ASSOCIATES, INC.
324 SOUTH HAMILTON STREET
MADISON, WI 53703
(608) 255-5656

A25
SUPPLEMENTARY DRAWINGS

AS BUILT
DEC 6, 1994