

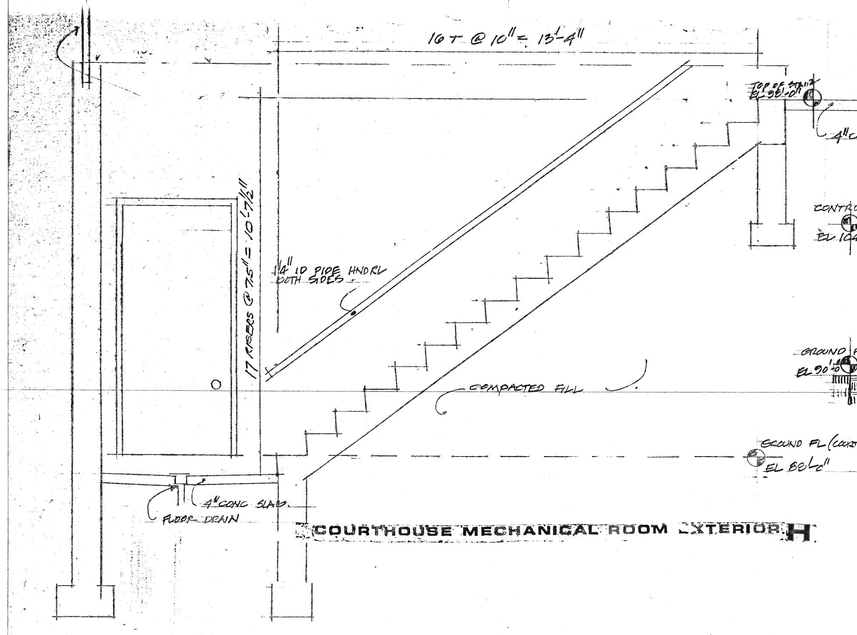



COURTHOUSE MECHANICAL ROOM EXTERIOR **H**

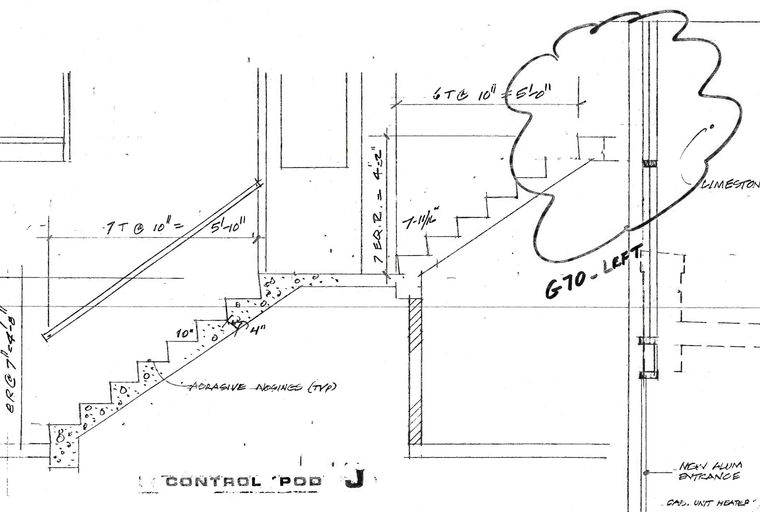

CONTROL POD **J**

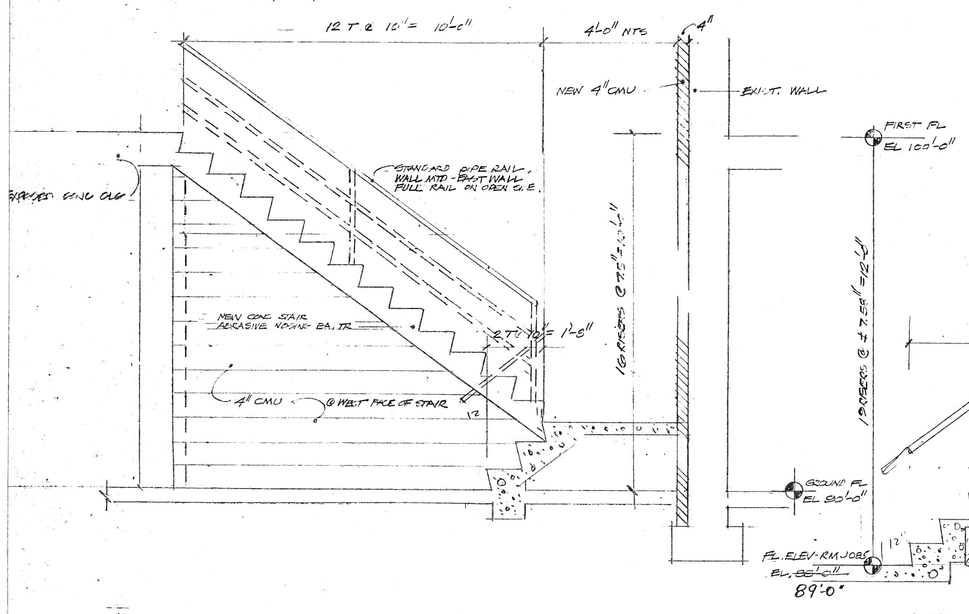


C KITCHEN AREA S 1004

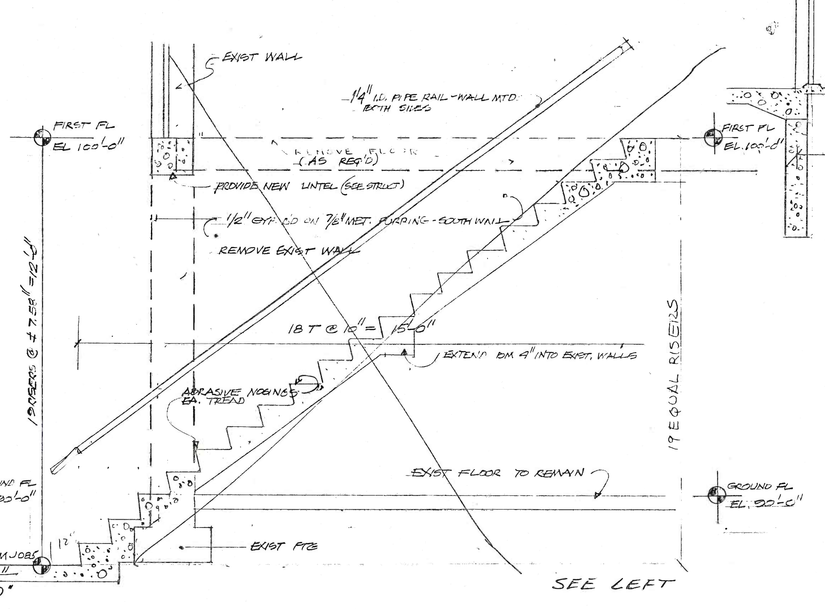


B EVIDENCE STORAGE S 1071


SEE LEFT

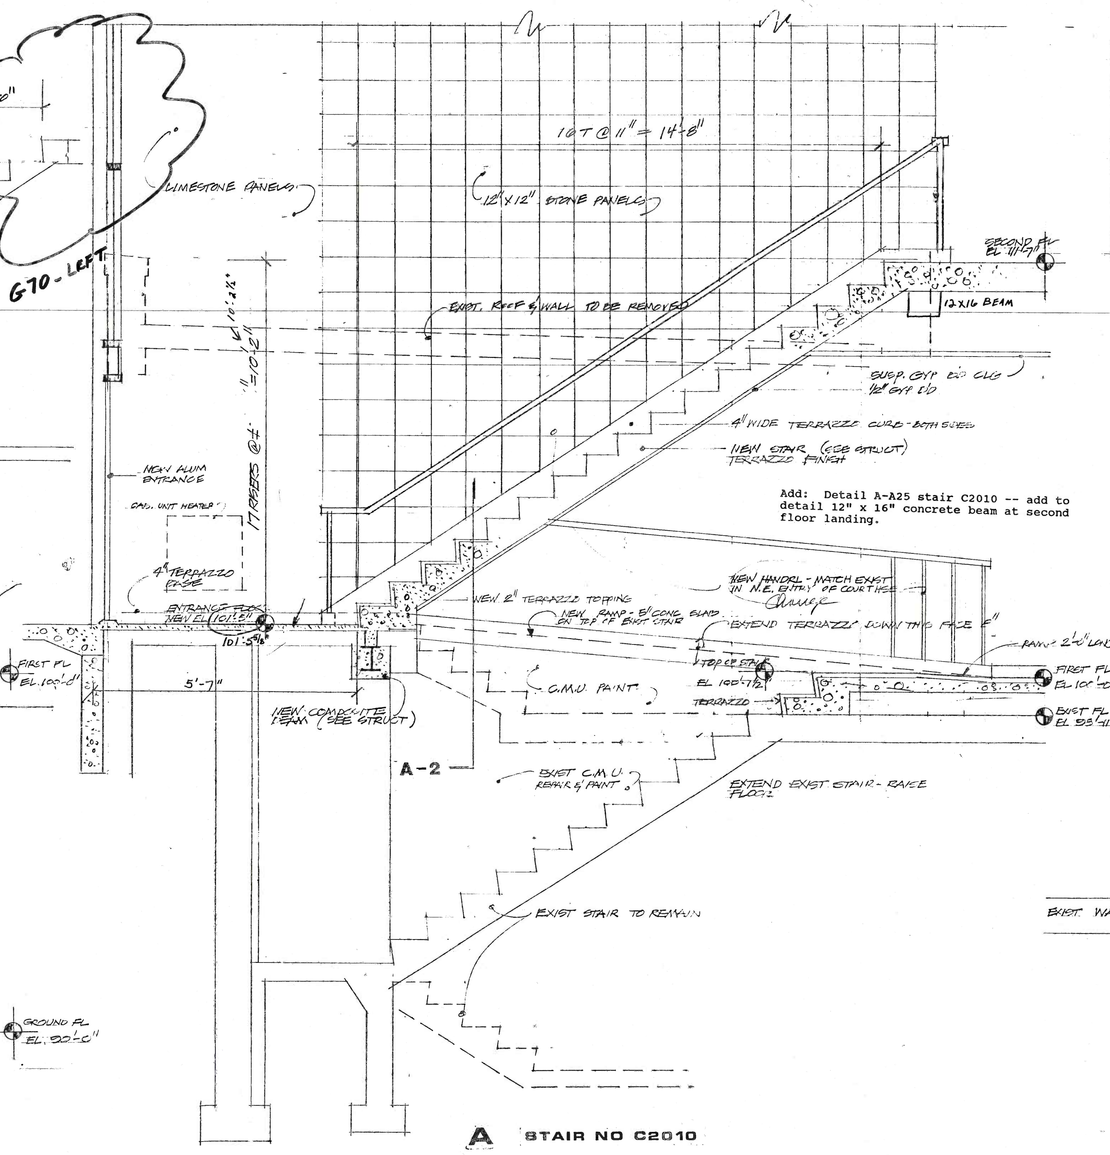


A STAIR NO C2010

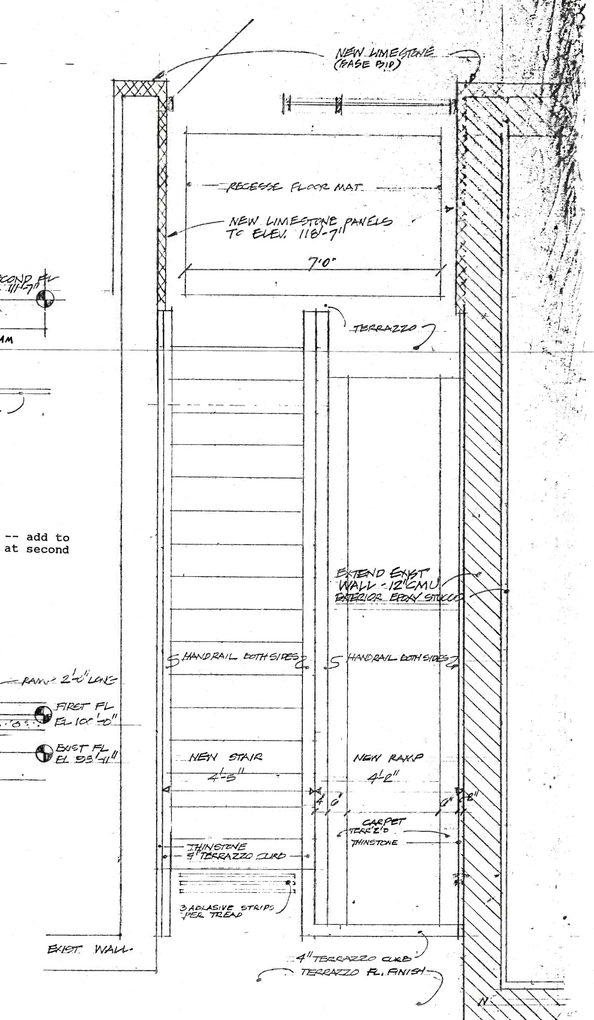

A-1 PLAN

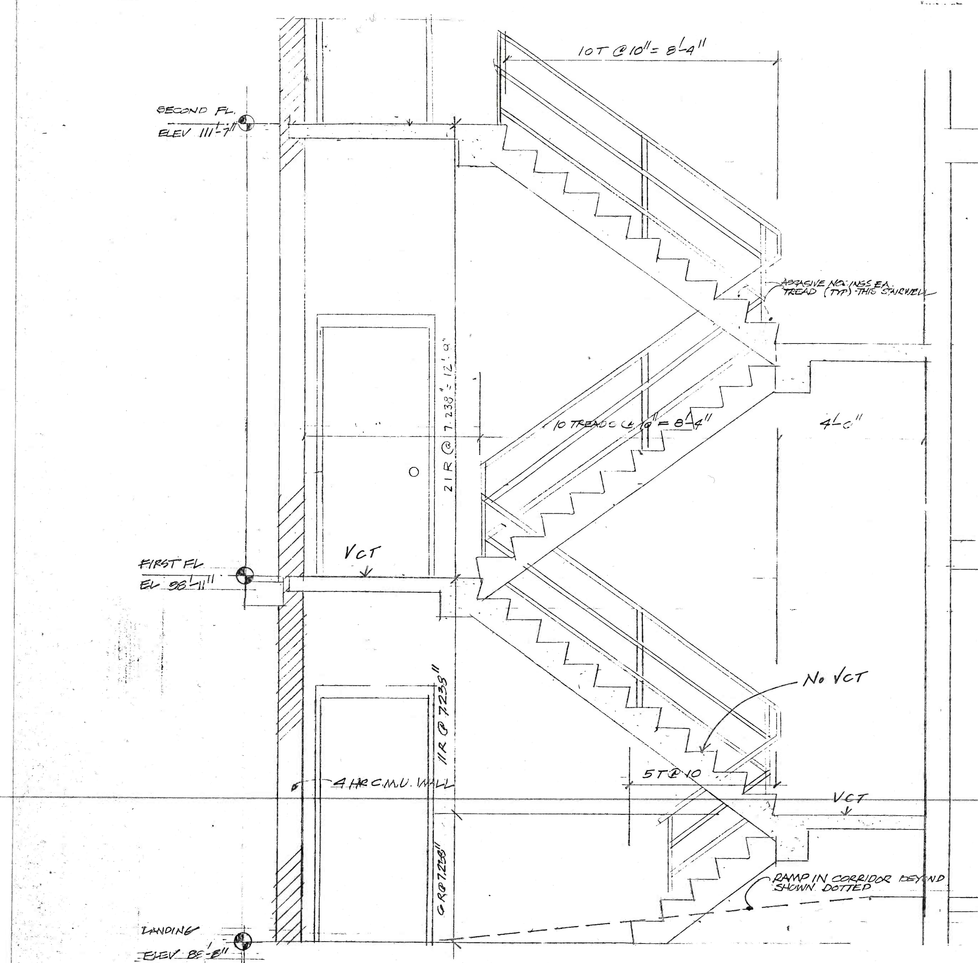


D COURTHOUSE STAIR - CENTRAL C 1043

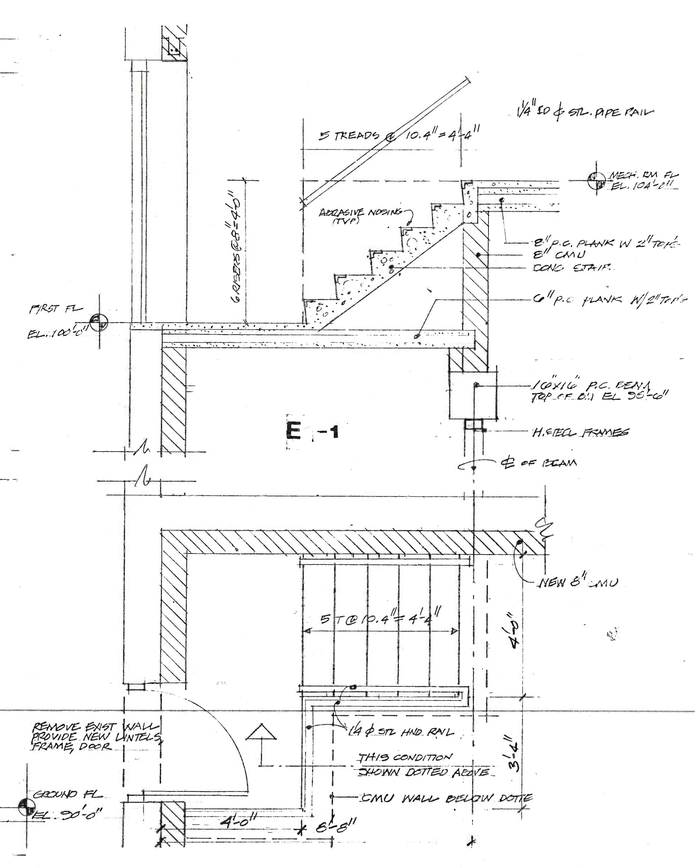


E STAIR TO ROOM S1035


PLAN

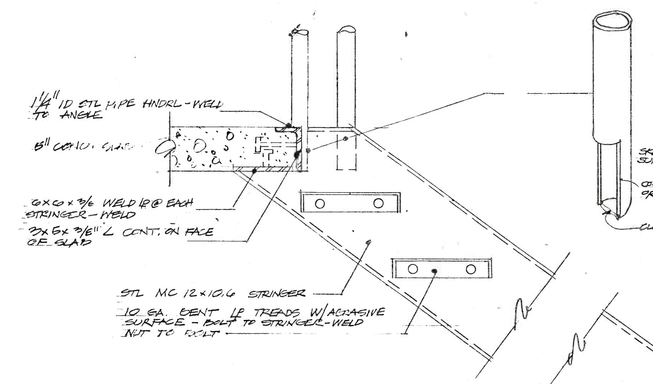

F-1
SCALE 1 1/2"=1'-0"

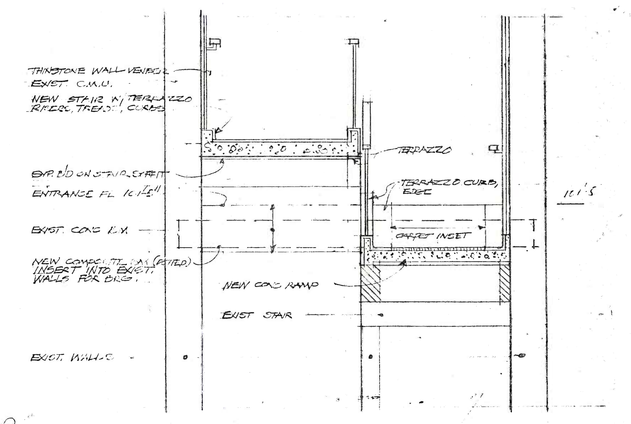

A-2

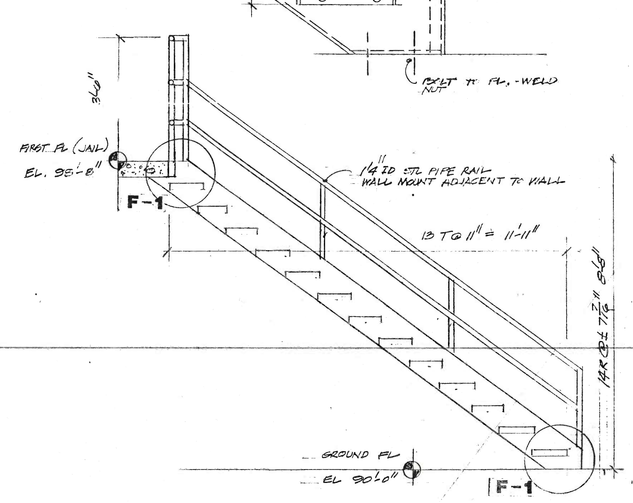

F TYPICAL DAY ROOM STAIR

STAIR SECTIONS 1/2"=1'0" EXCEPT AS SHOWN

DO NOT FABRICATE STAIRS UNTIL SHOP DRAWINGS AND SITE MEASUREMENTS

AS BUILT
DEC 6, 1994

DATE	REVISION
	See back of preceding sheet for roof access steps - Section & Details - Access Stair & Ladder Section Thru stair & rail (Ramp Similar) Section A-A stair to Room S1036 & Stair Section B - stair S1071

STRUCTURAL CONSULTANT

MECHANICAL CONSULTANT

ARCHITECT
KENTON PETERS + ASSOC., INC.
44 E MIFFLIN
MADISON, WISCONSIN 53703
(608) 255-5656

JEFFERSON COUNTY
LAW ENFORCEMENT CENTER
JEFFERSON, WISCONSIN

STAIR SECTIONS

A25