



1/A26 TOP OF WALL @ STONE VENEER (TYP.)
CLARIFIED 1½" = 1'-0"

		9-13-90
KENTON PETERS + ASSOC. 44 E MIFFLIN MADISON, WISCONSIN 53703 (608) 255-9858	JEFFERSON COUNTY LAW ENFORCEMENT CENTER JEFFERSON, WISCONSIN	G6

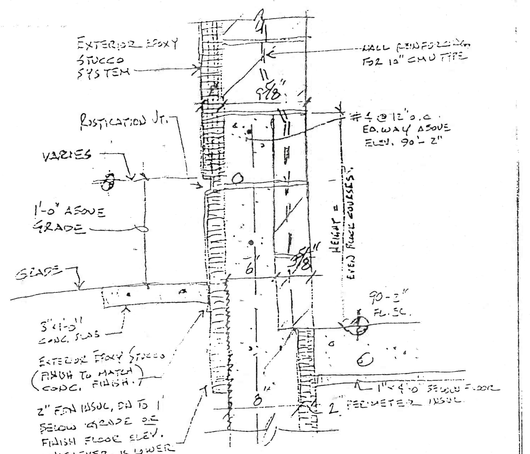


1/A26 TOP OF WALL @ EXTERIOR EPOXY STUCCO
CLARIFIED 1½" = 1'-0"

		9-13-90
KENTON PETERS + ASSOC. 44 E MIFFLIN MADISON, WISCONSIN 53703 (608) 255-9858	JEFFERSON COUNTY LAW ENFORCEMENT CENTER JEFFERSON, WISCONSIN	G5

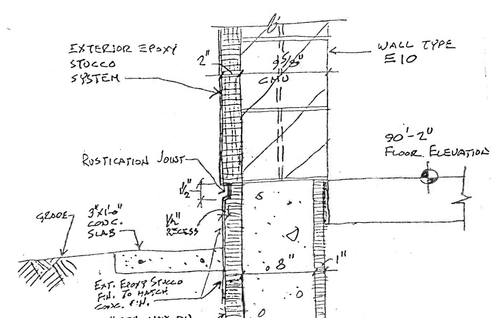


1/A26 TOP OF WALL @ EXTERIOR EPOXY STUCCO
CLARIFIED 1½" = 1'-0"

		9-10-90
KENTON PETERS + ASSOC. 44 E MIFFLIN MADISON, WISCONSIN 53703 (608) 255-9858	JEFFERSON COUNTY LAW ENFORCEMENT CENTER JEFFERSON, WISCONSIN	G-4 CD

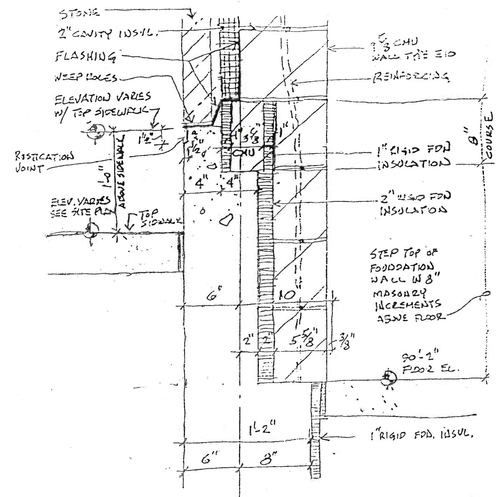

1/A26 TOP OF WALL @ STONE VENEER (TYP.)
CLARIFIED 1½" = 1'-0"

		9-10-90
KENTON PETERS + ASSOC. 44 E MIFFLIN MADISON, WISCONSIN 53703 (608) 255-9858	JEFFERSON COUNTY LAW ENFORCEMENT CENTER JEFFERSON, WISCONSIN	G-3 CD

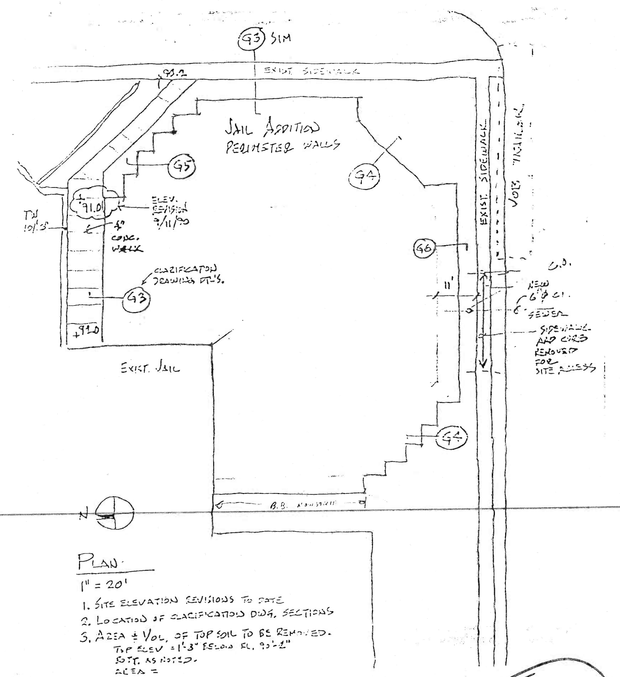


PLAN
1" = 20'

2. LOCATION OF CLARIFICATION DWG. SECTIONS
3. AREA & VOL. OF TOP SOIL TO BE REMOVED.
   AREA =
   VOL. =

		9-13-90
KENTON PETERS + ASSOC. 44 E MIFFLIN MADISON, WISCONSIN 53703 (608) 255-9858	JEFFERSON COUNTY LAW ENFORCEMENT CENTER JEFFERSON, WISCONSIN	G7 CD


A26

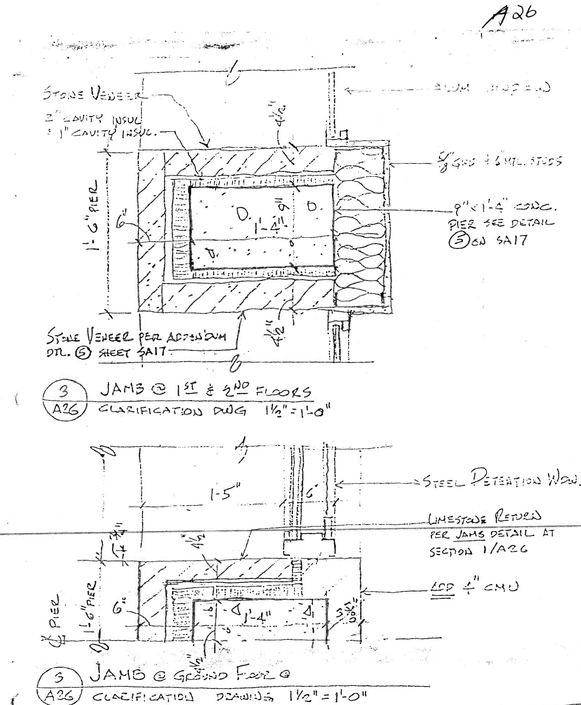

3/A26 JAMB @ 1ST & 2ND FLOORS
CLARIFICATION DWG 1½" = 1'-0"

3/A26 JAMB @ GROUND FLOOR
CLARIFICATION DRAWING 1½" = 1'-0"

		9-26-90
KENTON PETERS + ASSOC. 44 E MIFFLIN MADISON, WISCONSIN 53703 (608) 255-9858	JEFFERSON COUNTY LAW ENFORCEMENT CENTER JEFFERSON, WISCONSIN	G12 CD

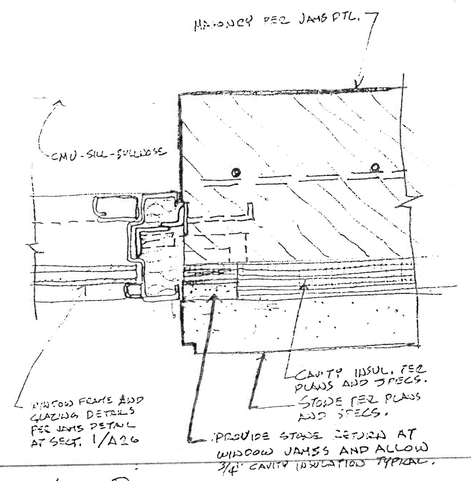

JAMB DETAIL @ WINDOW DETAIL
1/A26 3" = 1'-0" (CLARIFICATION DRAWING)

		9/26/90
KENTON PETERS + ASSOC. 44 E MIFFLIN MADISON, WISCONSIN 53703 (608) 255-9858	JEFFERSON COUNTY LAW ENFORCEMENT CENTER JEFFERSON, WISCONSIN	G10 CD

AS BUILT
DEC 6, 1994

KENTON PETERS + ASSOCIATES, INC.
324 SOUTH HAMILTON STREET
MADISON, WI 53703
(608) 255-5656

A26 SUPPLEMENTARY DRAWINGS