

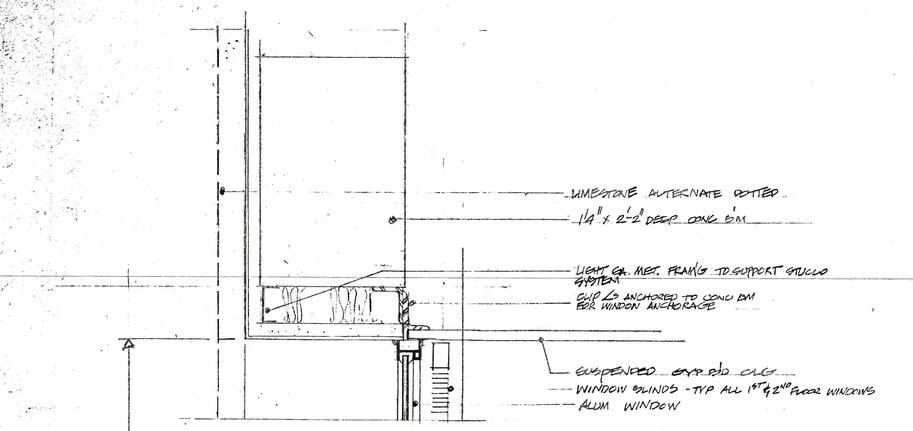


HEAD


Clarification: Section 3 head detail all first and second floor windows will receive blinds.

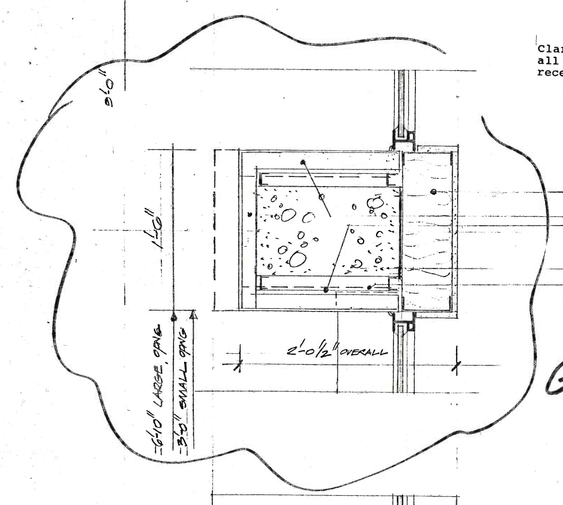


JAMB

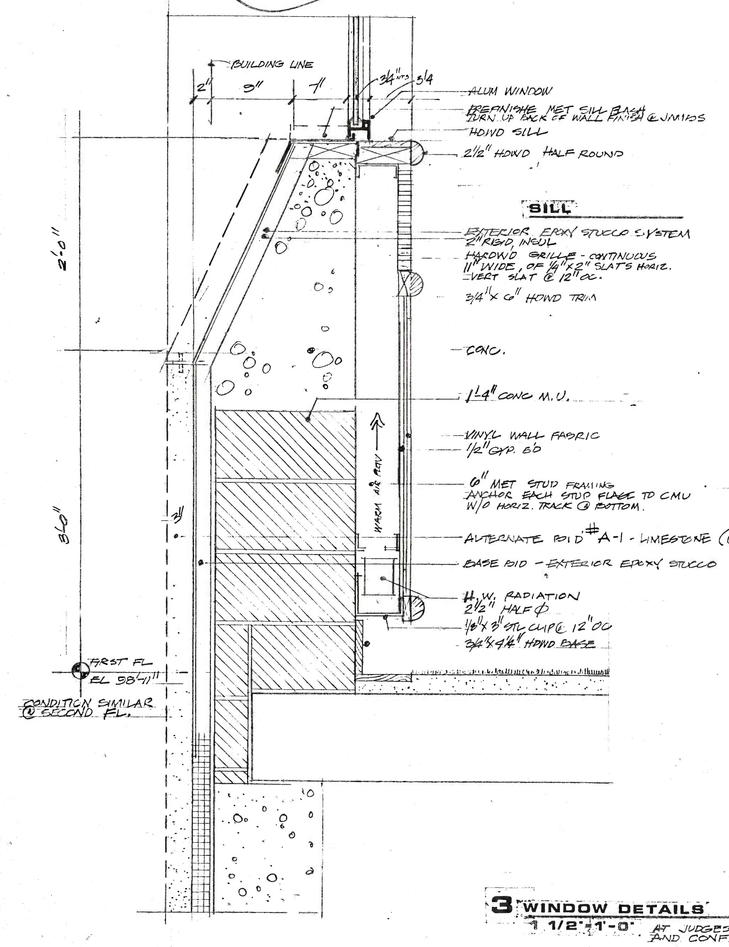


3 WINDOW DETAILS

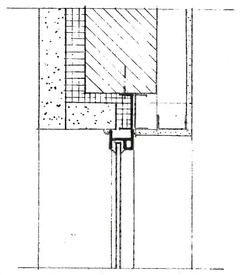

JAMB

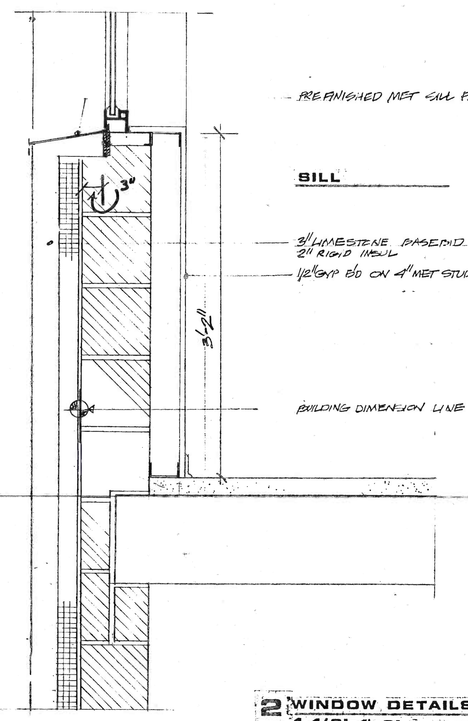

2 WINDOW DETAILS
1 1/2"=1'-0" NORTH & NORTHWEST ELEV. CONTROL ADDITION

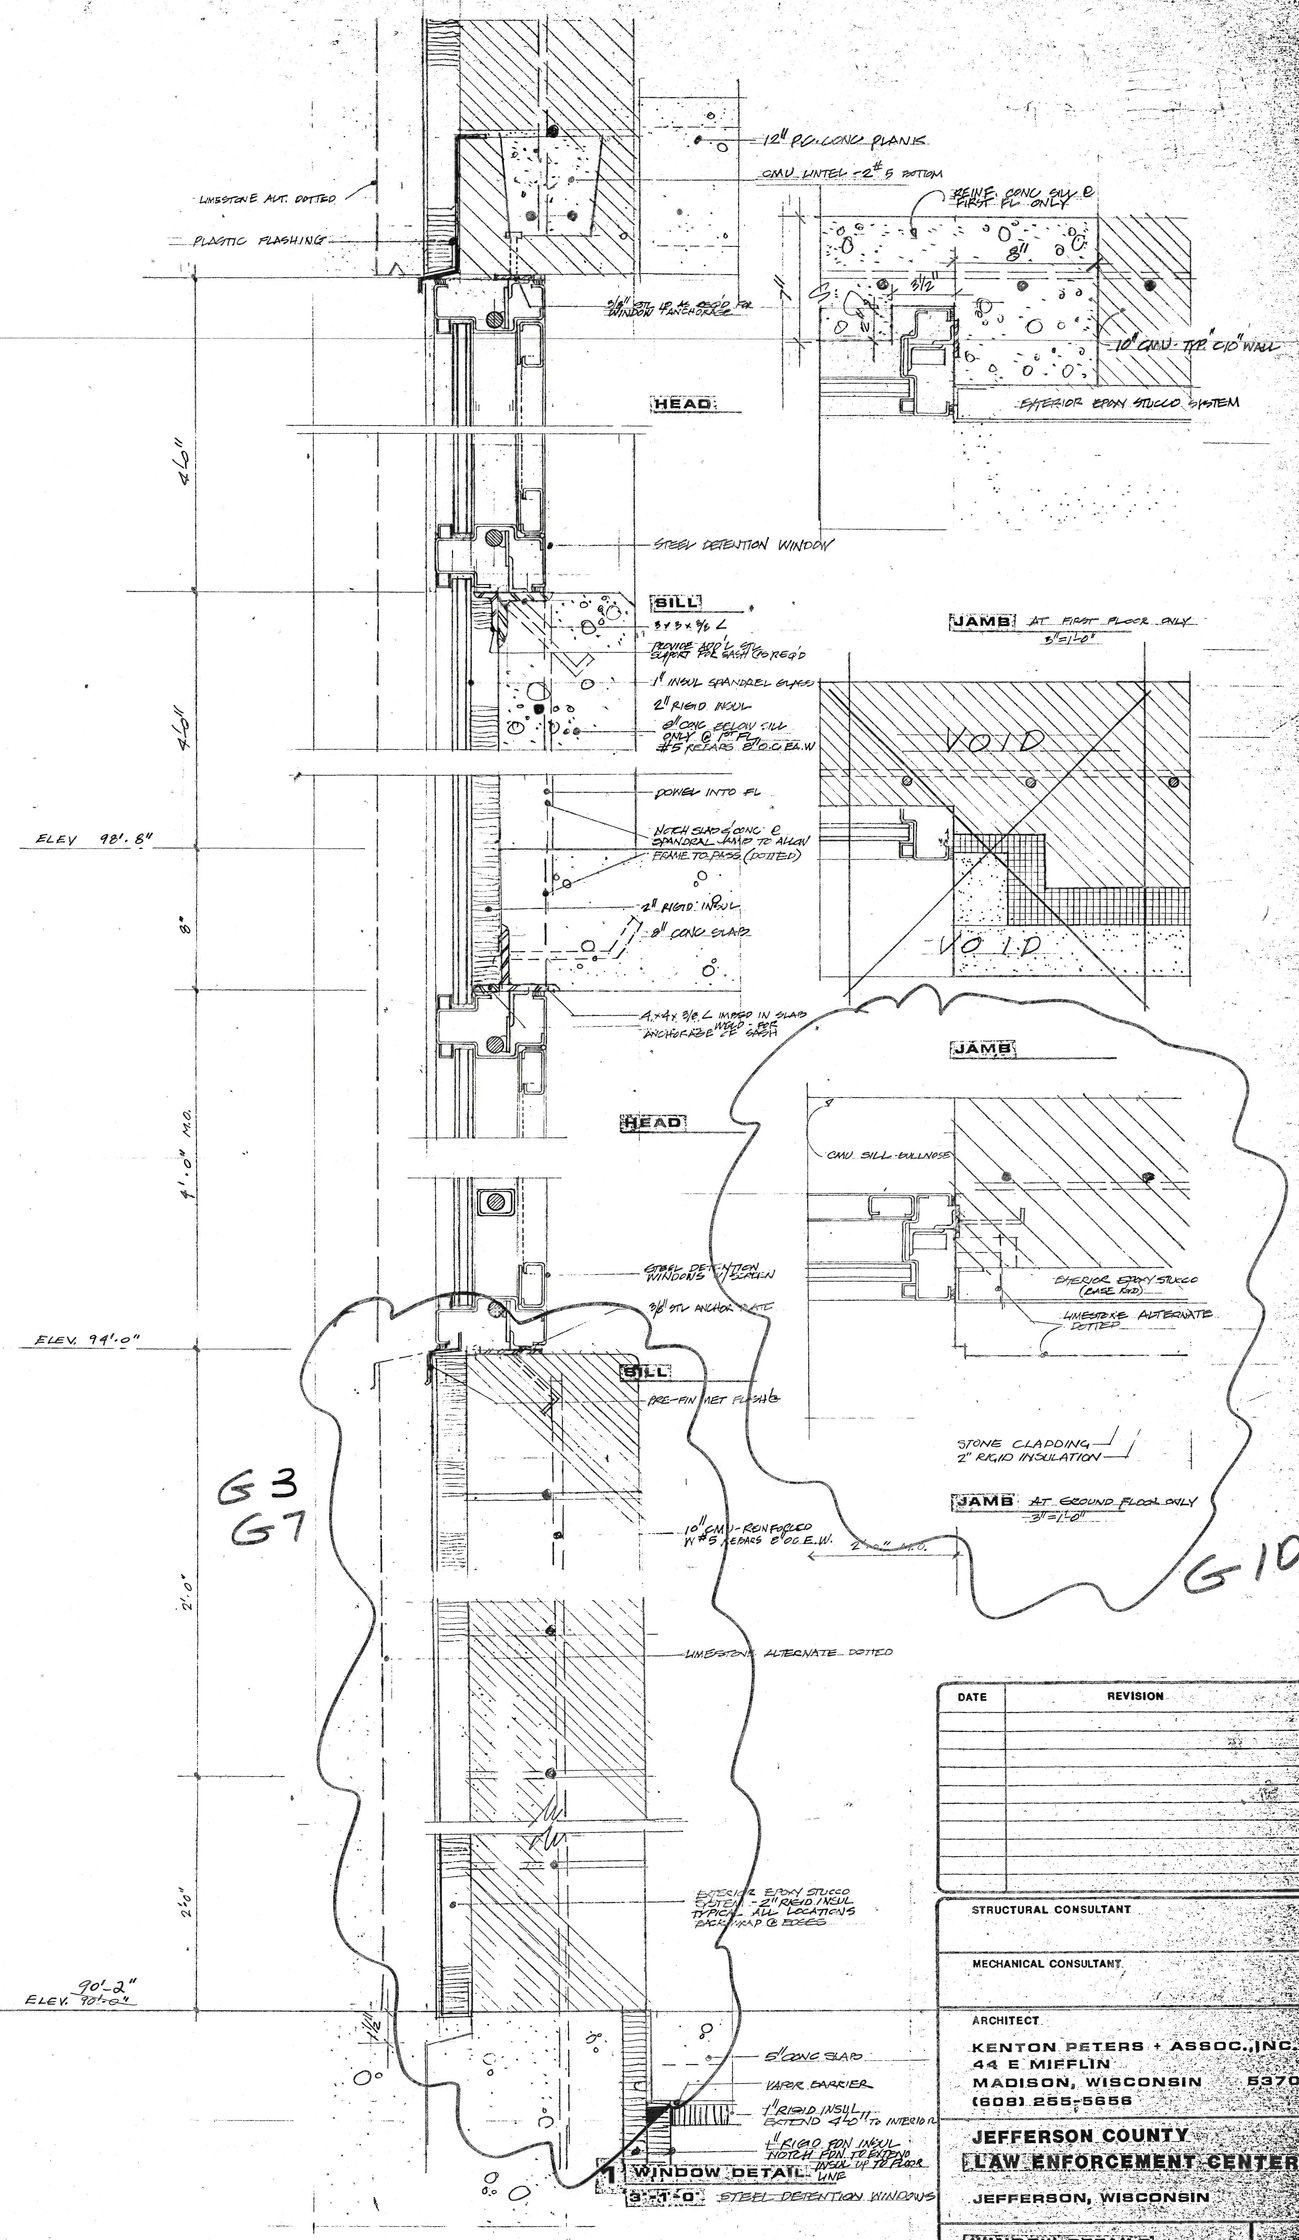

DATE	REVISION

STRUCTURAL CONSULTANT

MECHANICAL CONSULTANT

ARCHITECT
KENTON PETERS + ASSOC., INC.
44 E MIFFLIN
MADISON, WISCONSIN 53703
(608) 255-5856

JEFFERSON COUNTY
LAW ENFORCEMENT CENTER
JEFFERSON, WISCONSIN

WINDOW DETAILS
MISC. DETAILS

A26

AS BUILT
DEC 6, 1994