


FRAME ELEVATIONS

3/8"=1'-0"

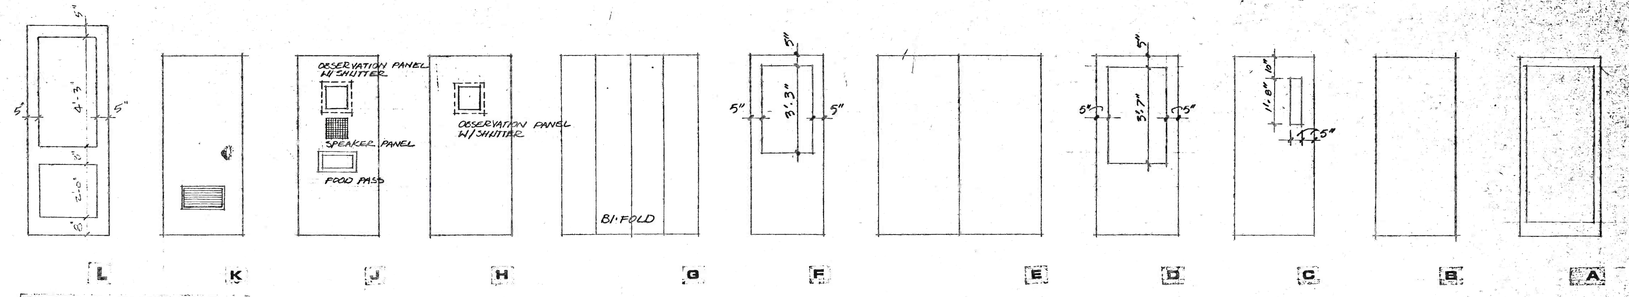


DOOR ELEVATIONS

HOLLOW METAL DOORS, HOLLOW STEEL DOORS, ALUMINIUM DOORS, SOLID CORE WOOD DOORS


NOTE: SEE DOOR SCHEDULE FOR GLASS TYPE

3/8"=1'-0"

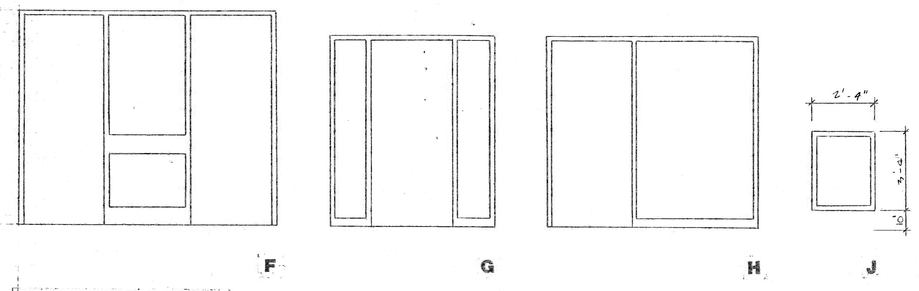


FRAME ELEVATIONS

3/8"=1'-0"

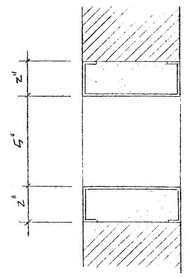


KK FOOD PASS

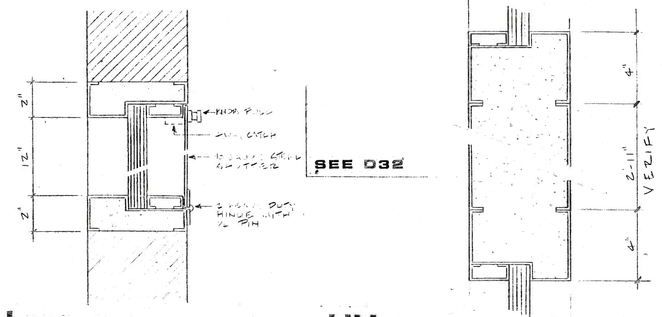


JJ OBSERVATION PANEL


HH SLIDING DOOR HEAD

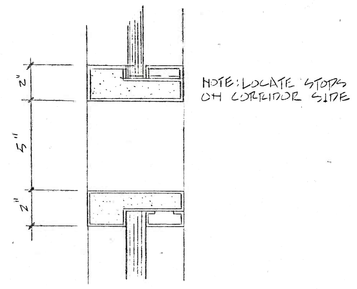


EE FOOD PASS

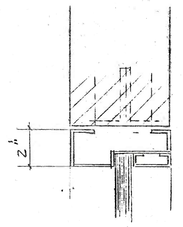

FF 2' WINDOW HEAD

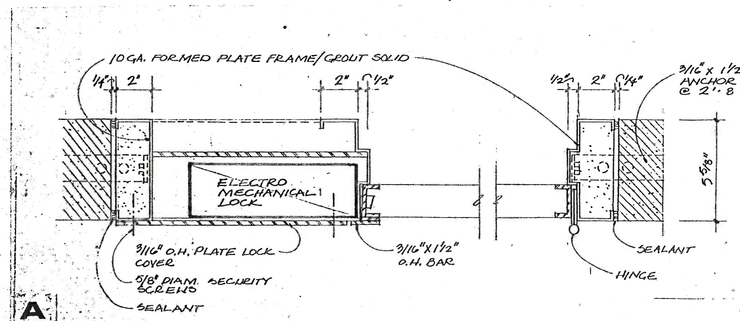


A JAMB SECURE VESTIBULE/CONTROL

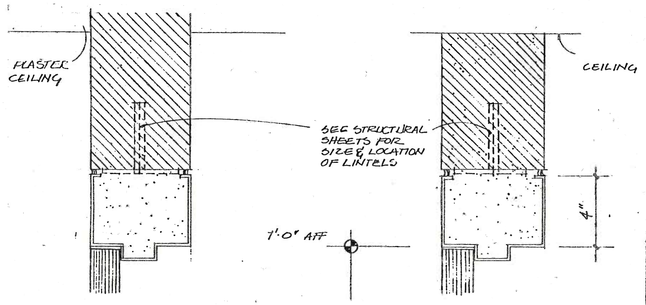


C TYPICAL HEAD

B TYPICAL HEAD

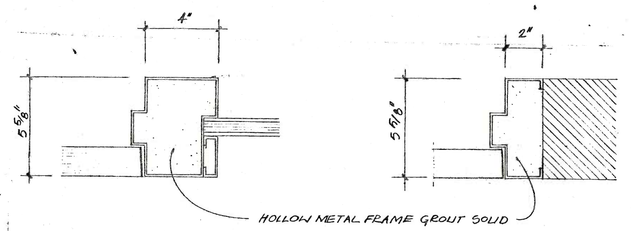


E JAMB DETAIL


D JAMB DETAIL

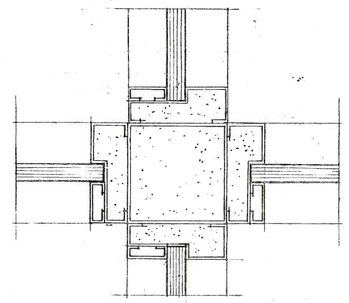

F INTERSECTION

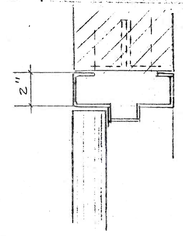


GG 2' DOOR HEAD

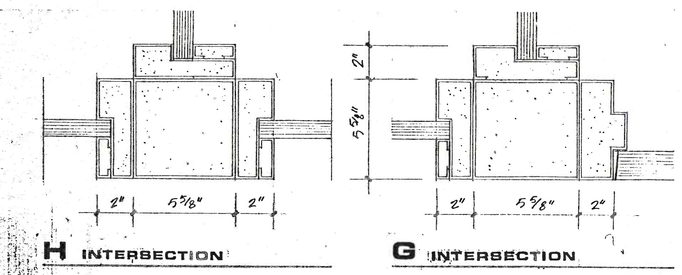


H INTERSECTION

G INTERSECTION

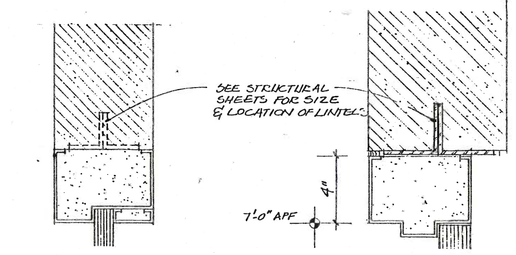

K WINDOW HEAD


J EXTERIOR HEAD

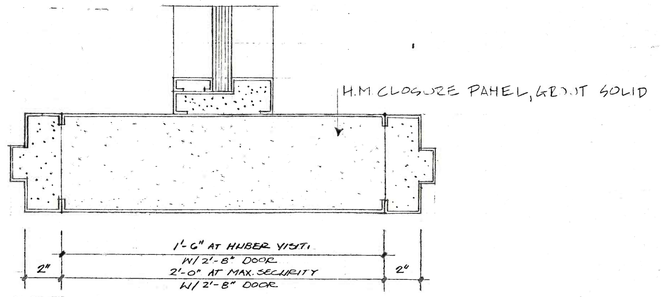

M MULLION


L JAMB DETAIL

N INTERSECTION

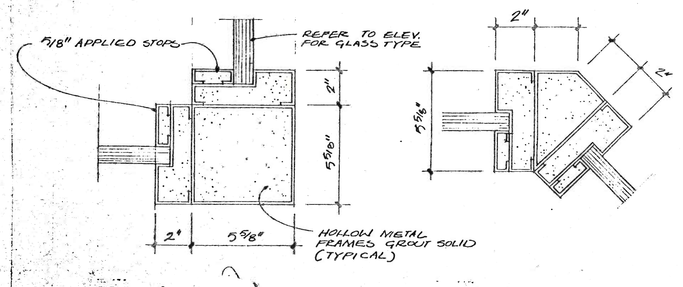


P 90° CORNER

O 45° CORNER

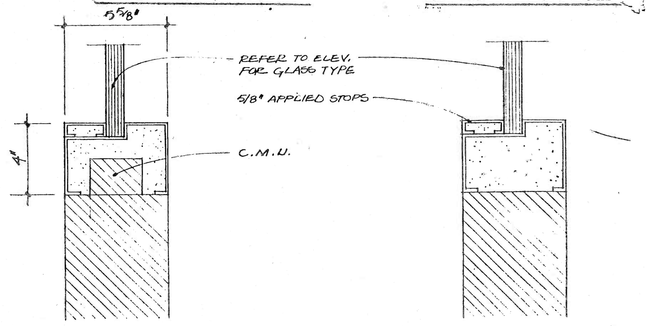


R SILL CONTROL


Q SILL TYPICAL

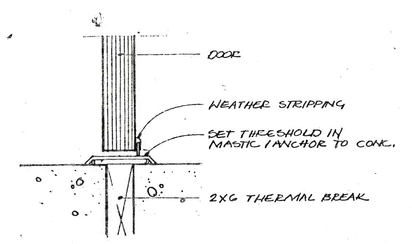


T SILL EXTERIOR DOOR

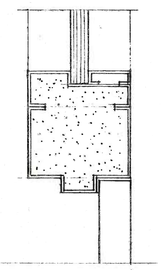

DD HEAD

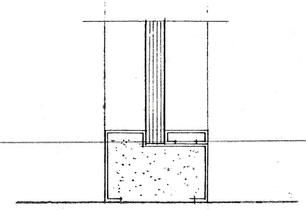

CC SILL

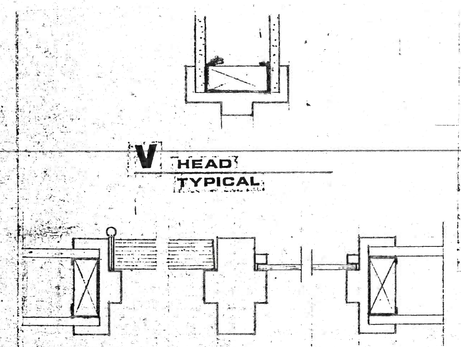


V HEAD TYPICAL


Y JAMB TYPICAL

X MULLION TYPICAL


W JAMB TYPICAL

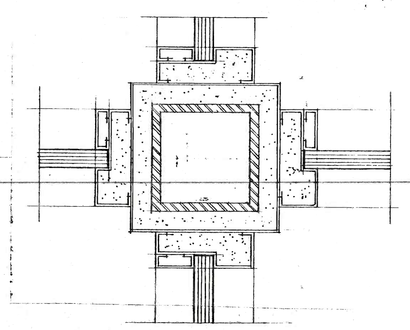


U MULLION AT COL. ENCLOSURE

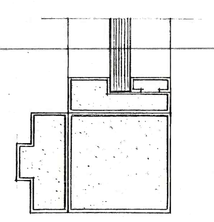

Z CORNER

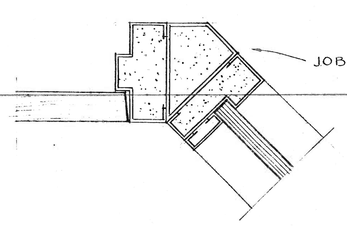

AA CORNER

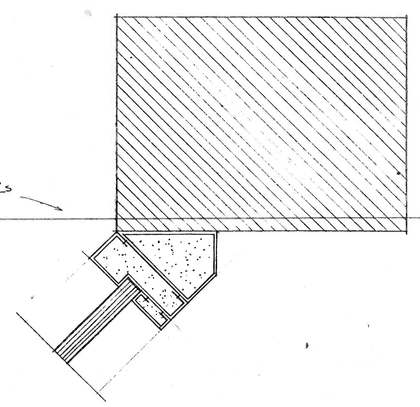

BB JAMB

STOPS ON NON HAZARD SIDE

DOOR DETAILS

3"=1'-0"

AS BUILT
DEC 6, 1994

DATE	REVISION
	Details this sheet with the exception of V,W, X, Y referred to as "hollow metal details" are hollow steel 12GA. Detention frames see 11880-8 2.06C
	All details on this sheet referred to as "hollow metal" are "hollow steel" with the exception of V, W, X, Y. Refer to 11880-8 2.06.c. "Steel frames for masonry walls"

STRUCTURAL CONSULTANT

MECHANICAL CONSULTANT

ARCHITECT.

KENTON PETERS + ASSOC., INC.
44 E MIFFLIN
MADISON, WISCONSIN 53703
(608) 255-5656

JEFFERSON COUNTY
LAW ENFORCEMENT CENTER
JEFFERSON, WISCONSIN

DOOR ELEVATIONS & DETAILS HOLLOW METAL DETAILS

SCALE VARIES

8-11-94

A27