




M REAR ELEVATION
1½"=1'-0"

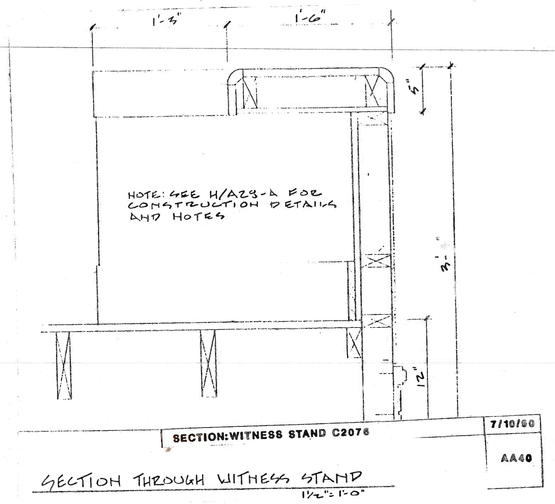


SECTION THROUGH WITNESS STAND
1½"=1'-0"

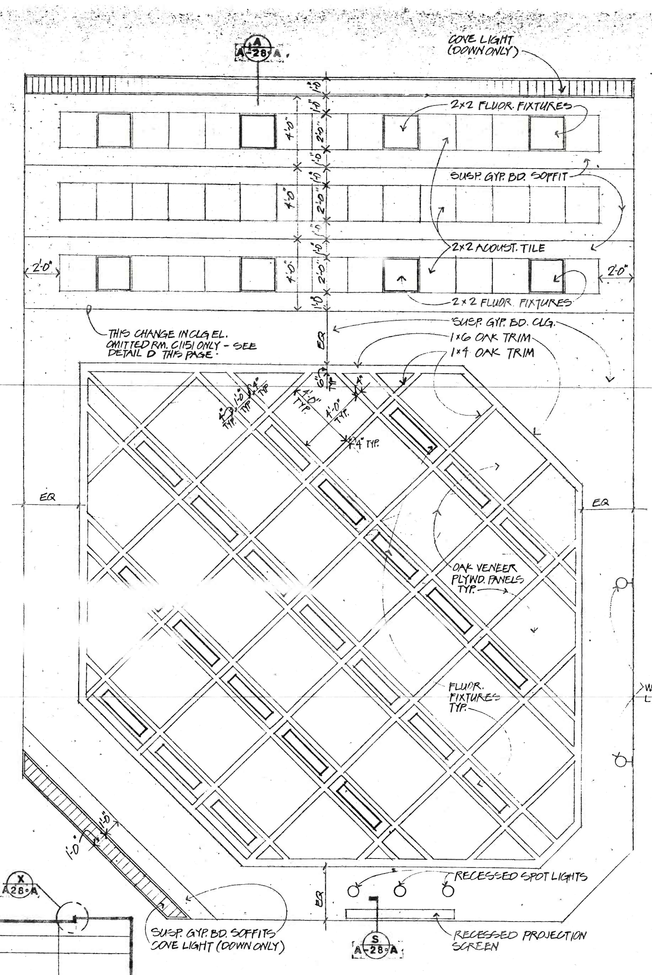


C REFLECTED CEILING PLAN
COURTROOM (C2014 SHOWN)
1/4"=1'-0" SEE LEFT

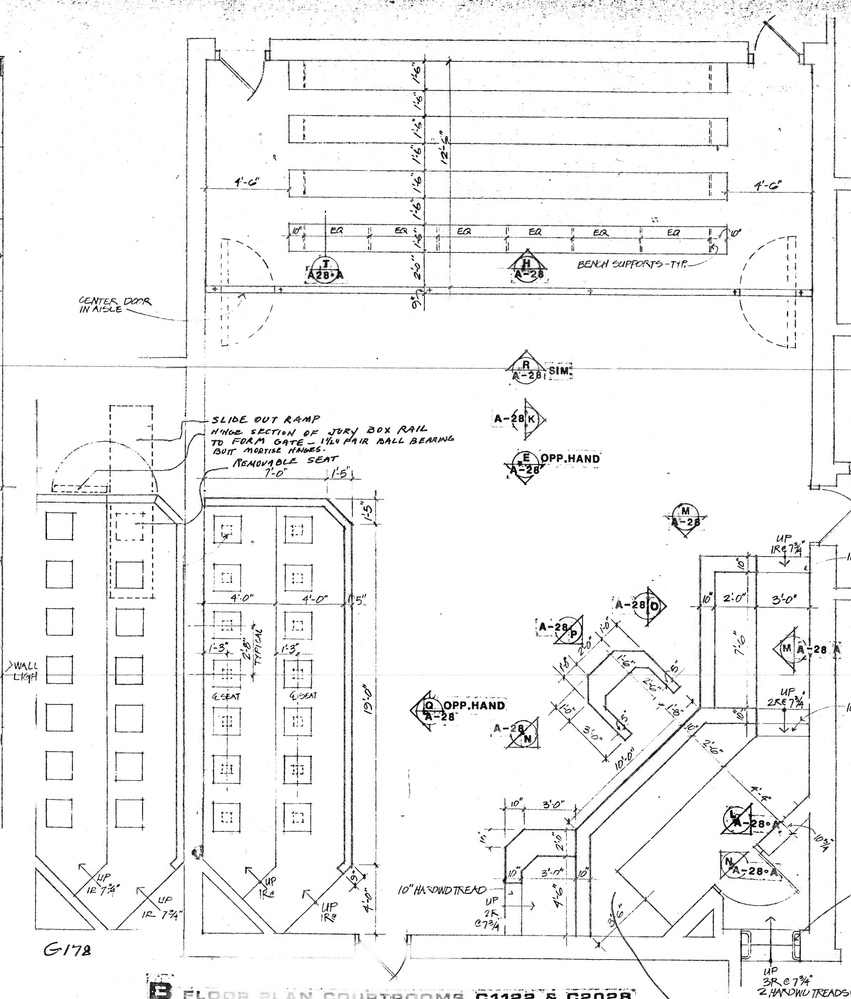


B FLOOR PLAN COURTROOMS C1122 & C2028
1/4"=1'-0"

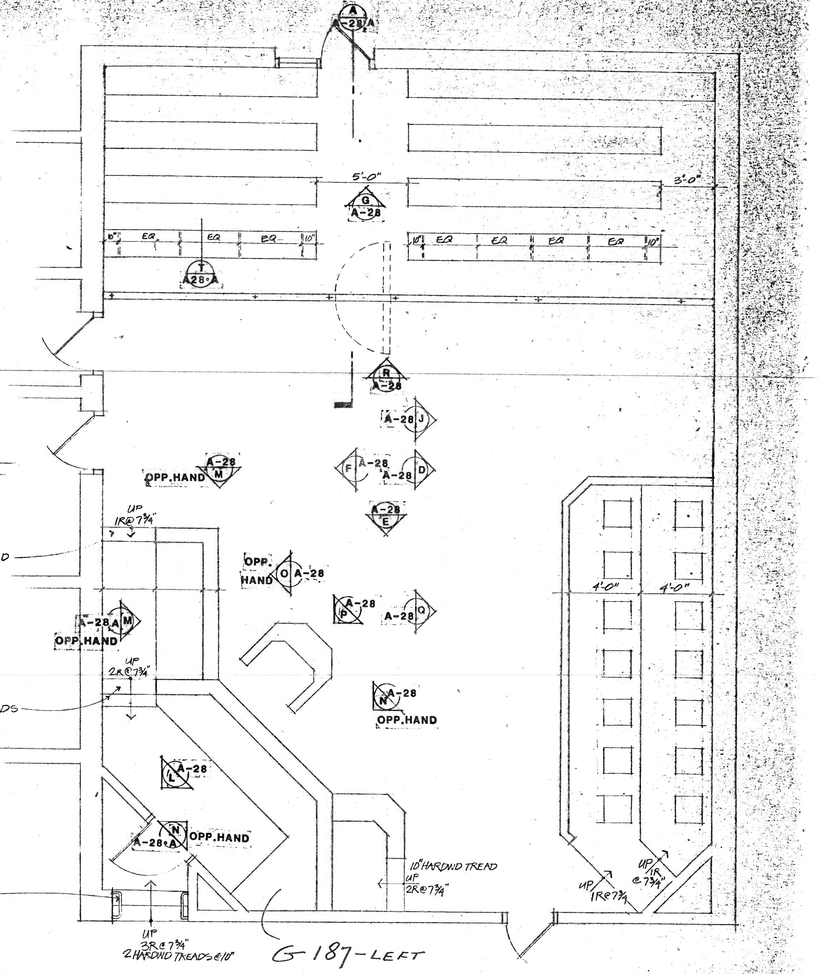


A FLOOR PLAN COURTROOM C1151 & 2014
1/4"=1'-0"

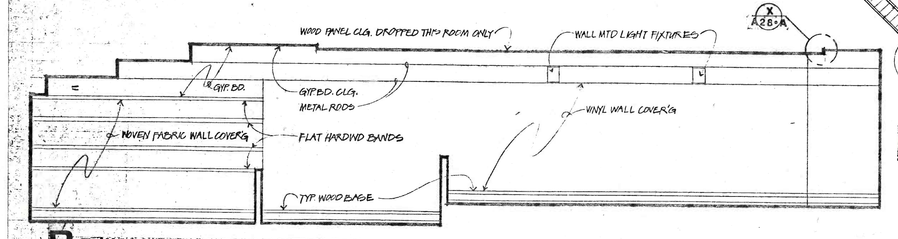


D S. WALL COURTROOM C1151
1/4"=1'-0"

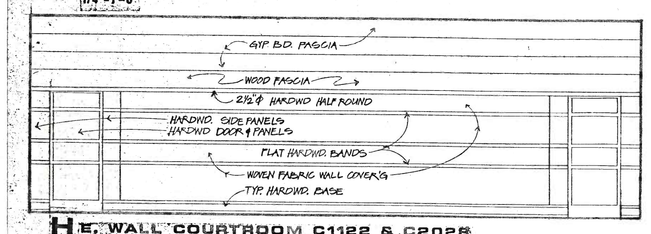


H E. WALL COURTROOM C1122 & C2028
1/4"=1'-0"

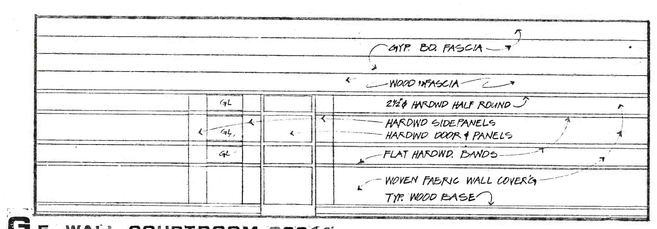


G E. WALL COURTROOM C2014
1/4"=1'-0"

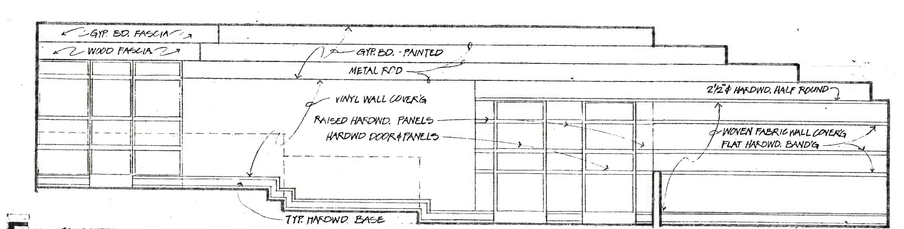


F N. WALL COURTROOM C2014
1/4"=1'-0"

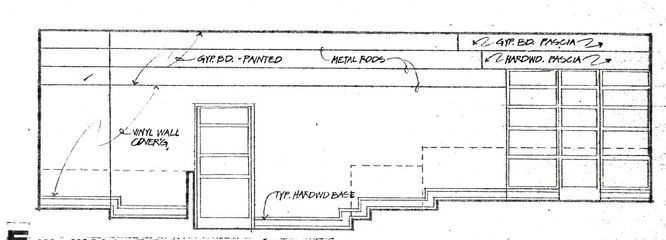


E W. WALL COURTROOM C2014
1/4"=1'-0"

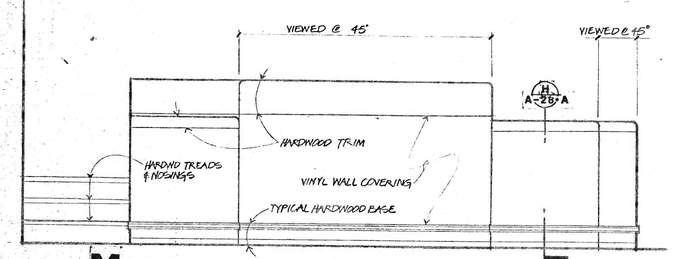


M CLERK JUDGE'S BENCH WITNESS STAND
1/2"=1'-0"

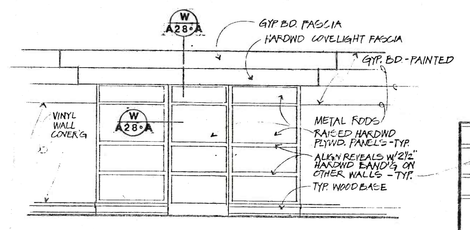


L NW WALL RM C2014
SW WALL RM C1122 & C2028
1/4"=1'-0"

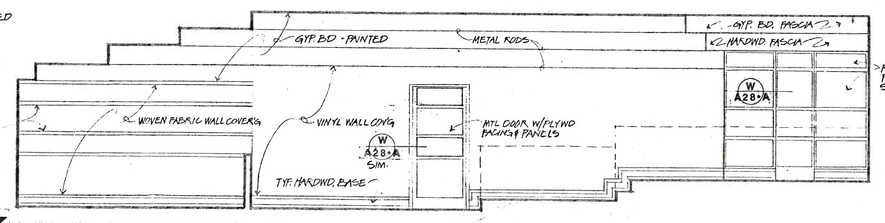


K S. WALL COURTROOM C1122 & C2028
1/4"=1'-0"

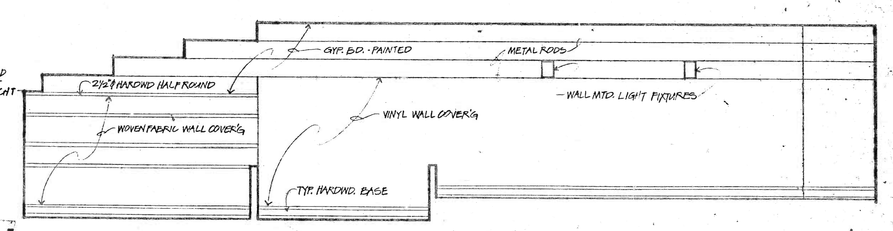


J S. WALL COURTROOM 2014
1/4"=1'-0"

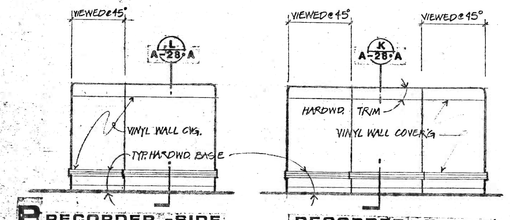


R RECORDER - SIDE RECORDER - FRONT
1/2"=1'-0"

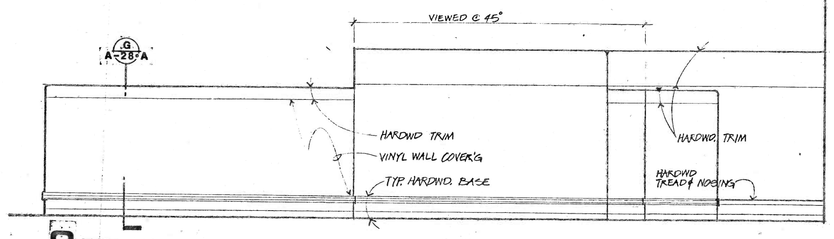


O CLERK JUDGE'S BENCH WITNESS STAND
1/2"=1'-0"

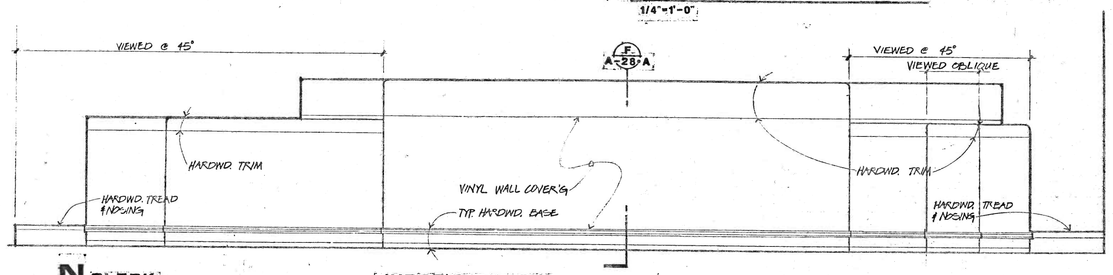

N CLERK JUDGE'S BENCH WITNESS STAND
1/2"=1'-0"

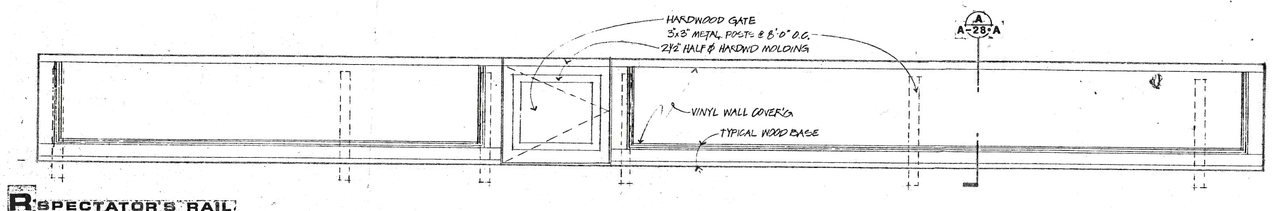

R SPECTATOR'S RAIL
1/2"=1'-0"

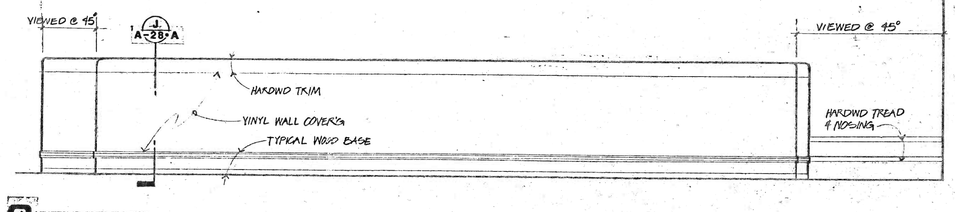

G JURY BOX
1/2"=1'-0"

DATE	REVISION

STRUCTURAL CONSULTANT

MECHANICAL CONSULTANT

ARCHITECT
KENTON PETERS + ASSOC., INC.
44 E. MIFFLIN
MADISON, WISCONSIN 53703
(608) 255-5858

JEFFERSON COUNTY
LAW ENFORCEMENT CENTER
JEFFERSON, WISCONSIN

COURTROOM DETAILS
SCALE VARIES

11-89

A25

AS BUILT
DEC 6, 1994