


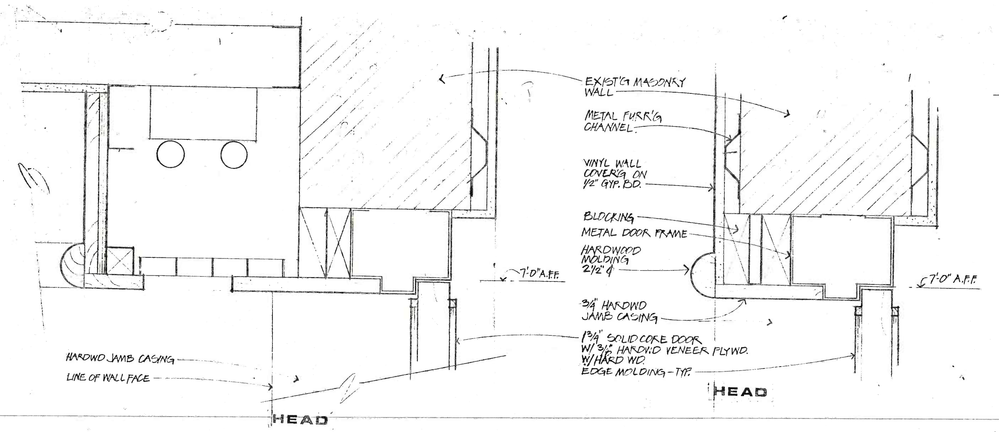


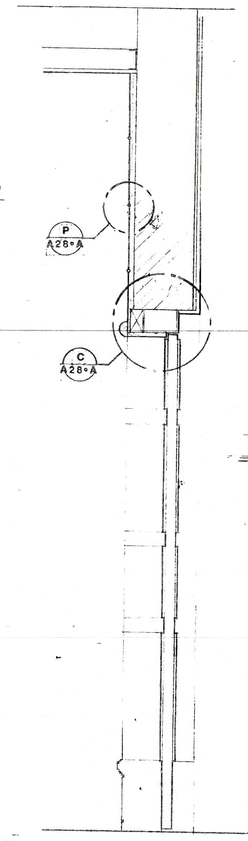


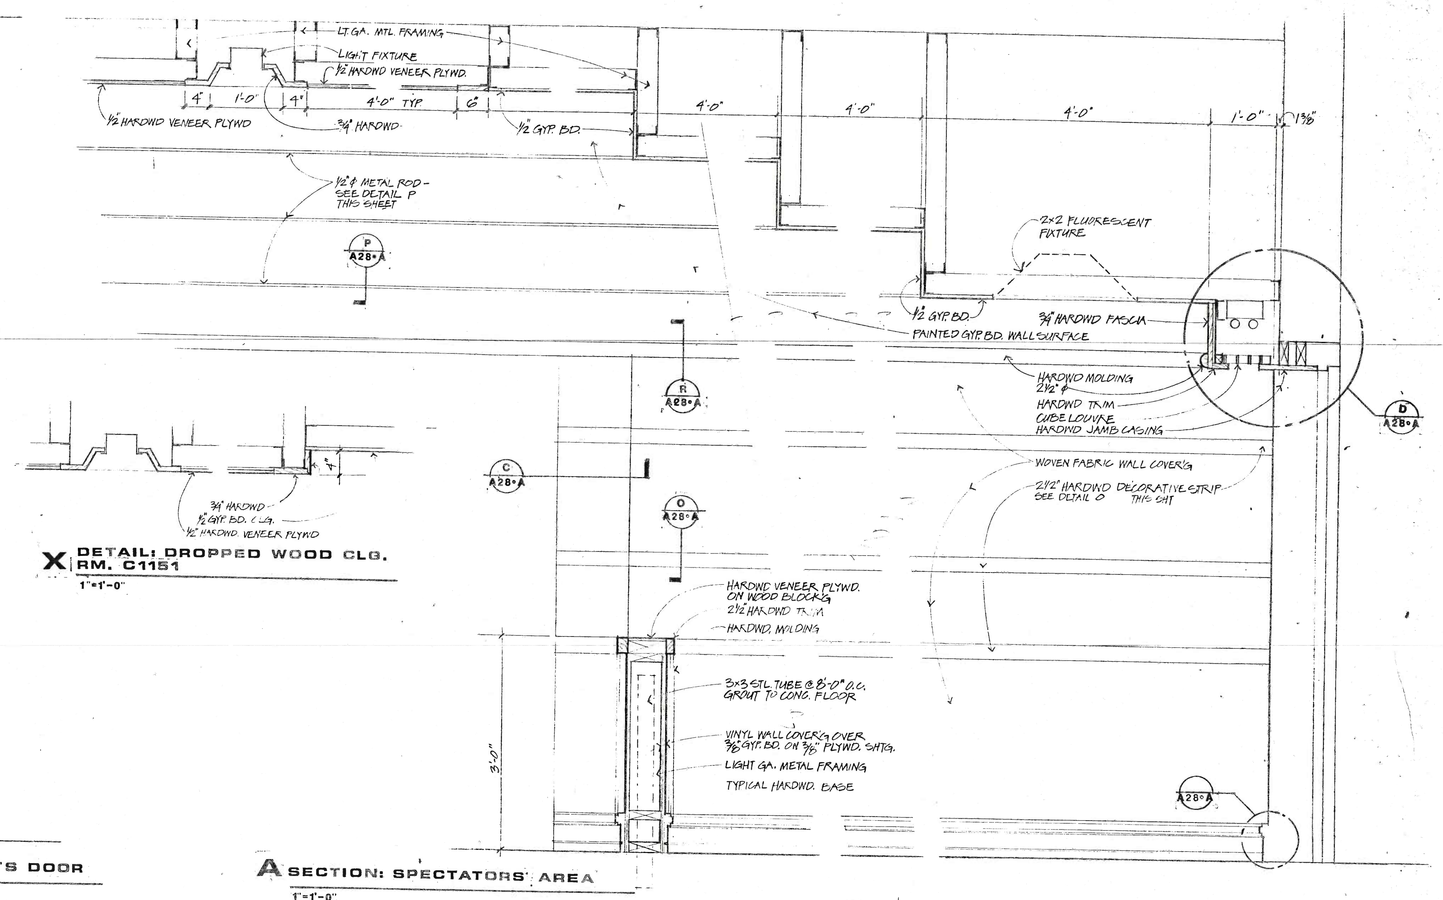


X DETAIL: DROPPED WOOD CLG. RM. C1151
1"=1'-0"

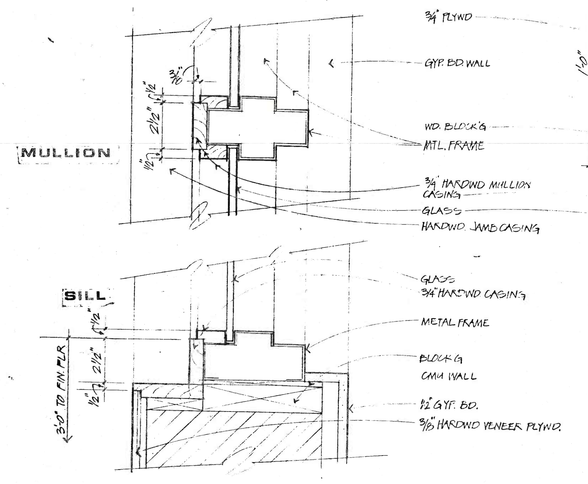

E SIDELIGHT DETAILS
3"=1'-0"

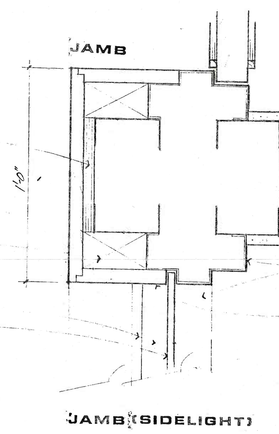


D DOOR DETAILS
3"=1'-0"

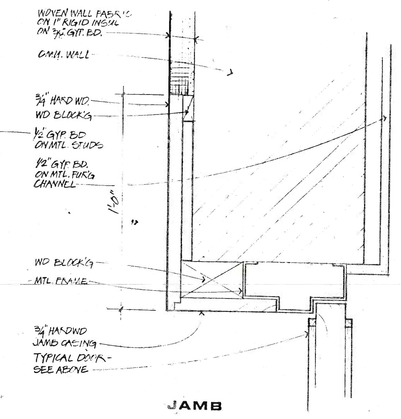


C DOOR DETAILS
3"=1'-0"

B SECTION: BAILIFF'S DOOR
1"=1'-0"

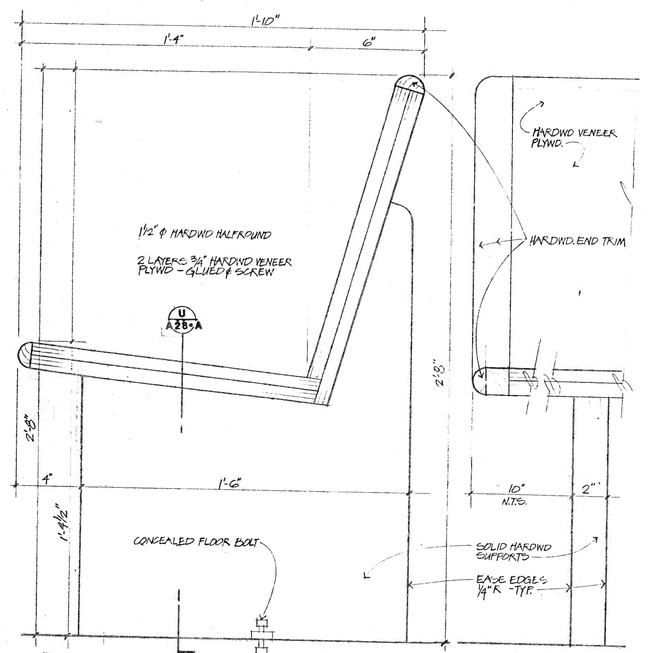


T SECTION: SPECTATOR'S BENCH
3"=1'-0"


U SPECTATOR SEATING
3"=1'-0"

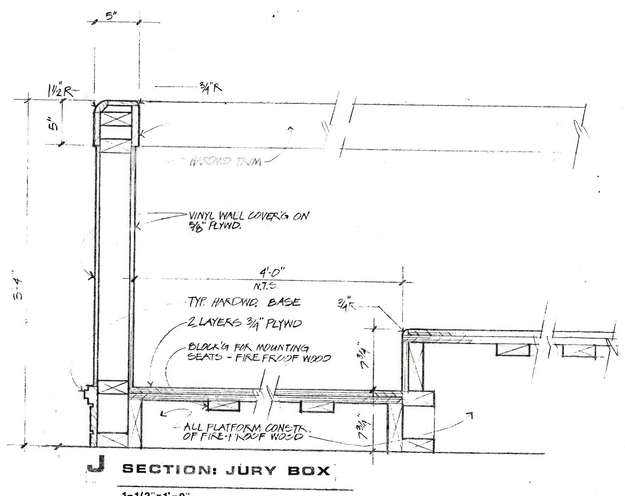


J SECTION: JURY BOX
1-1/2"=1'-0"

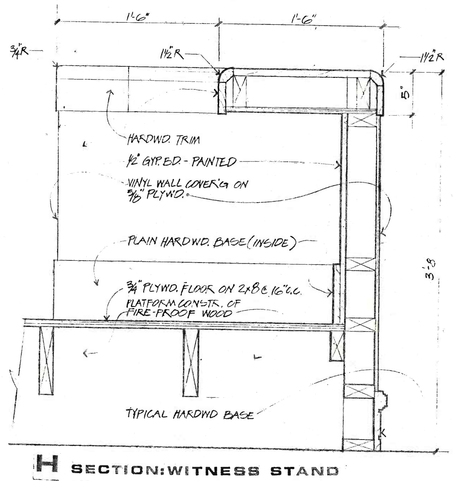


H SECTION: WITNESS STAND
1-1/2"=1'-0"

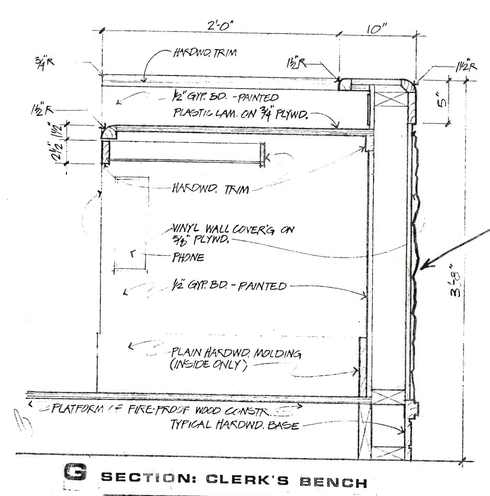


G SECTION: CLERK'S BENCH
1-1/2"=1'-0"

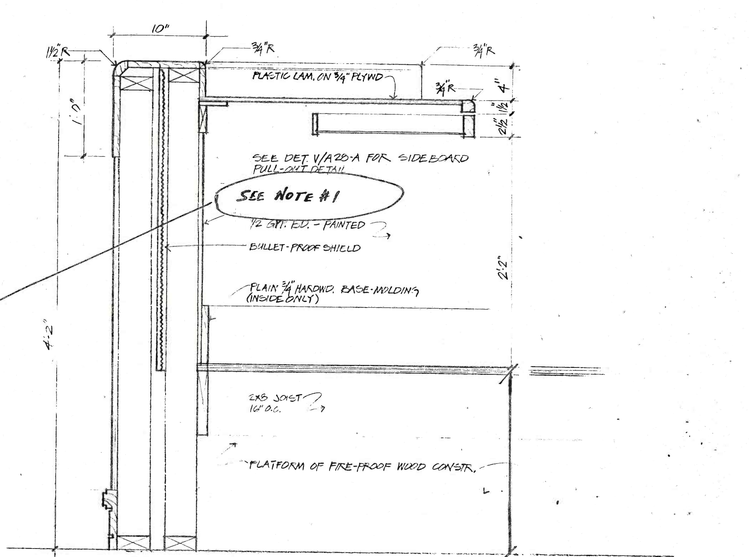


F SECTION: JUDGE'S BENCH
1-1/2"=1'-0"

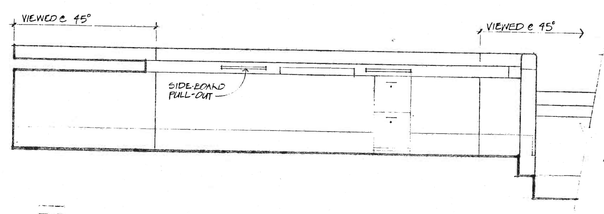

N REAR EL.: JUDGE'S BENCH
1-1/2"=1'-0"

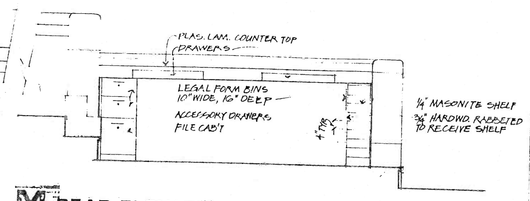


M REAR ELEVATION
1½"=1'-0"

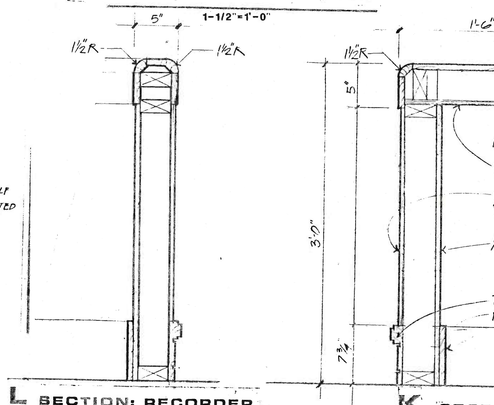


L SECTION: RECORDER
1-1/2"=1'-0"


K SECTION: RECORDER
1-1/2"=1'-0"

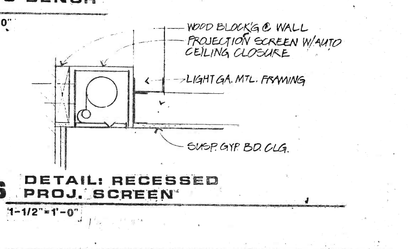


S DETAIL: RECESSED PROJ. SCREEN
1-1/2"=1'-0"

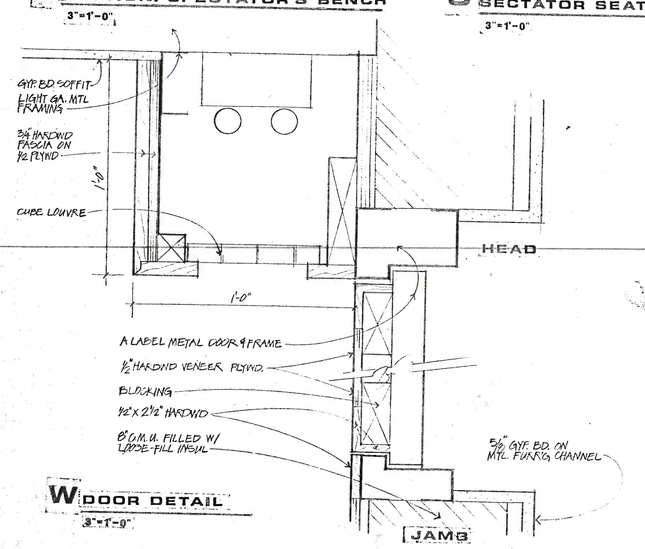

W DOOR DETAIL
3"=1'-0"

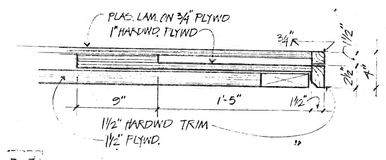


V DETAIL: SIDEBOARD PULL-OUT
1-1/2"=1'-0"

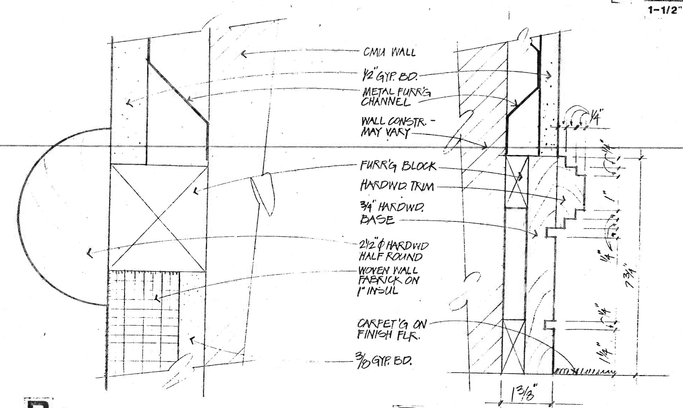


R JOINT DETAIL
FULL SCALE

Q TYPICAL HARDWOOD BASE
6"=1'-0"

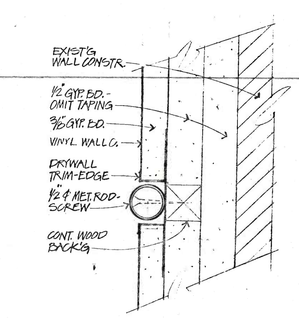

P JOINT DETAIL
FULL SCALE

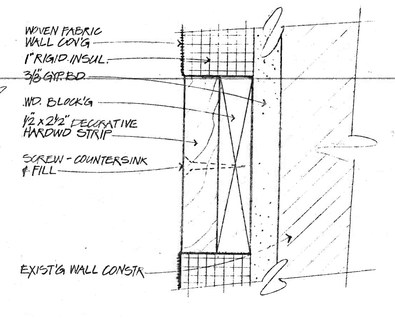

O JOINT DETAIL
FULL SCALE

AS BUILT
DEC 6, 1994

DATE	REVISION
	SEE BACK OF PRECEDING SHEET FOR:
	SECTION: COMMISSIONERS, BENCH & CLERKS BENCH
1.	DETAIL F BULLET-PROOF SHIELD TO BE BULLET RESISTANT FIBERGLASS BALLISTICS RATED FOR .357 MAGNUM AS BY ARMORTEX OR POINT BLANK.
2.	bullet-proof shield to Detail C Clerk's Bench; similar to Detail F

STRUCTURAL CONSULTANT

MECHANICAL CONSULTANT

ARCHITECT
KENTON PETERS + ASSOC., INC.
44 E. MIFFLIN
MADISON, WISCONSIN 53703
(608) 255-5656

JEFFERSON COUNTY
LAW ENFORCEMENT CENTER
JEFFERSON, WISCONSIN

COURTROOM DETAILS

SCALE VARIES

6-11-90

A28 A