
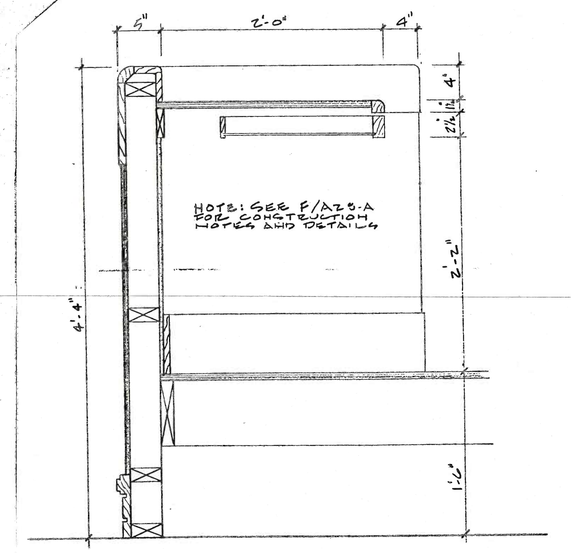



SECTION THROUGH COMMISOHER'S BENCH
1½"=1'-0"

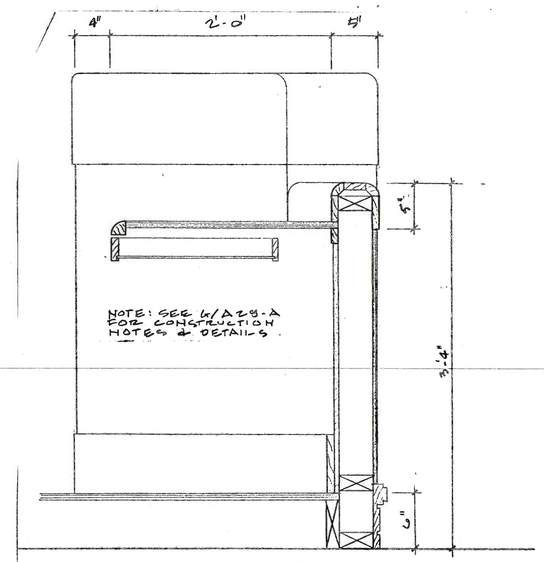

SECTION: CLERK'S BENCH
1½"=1'-0"


SECTION: COMMISSIONER'S BENCH C2075		7/10/90
KENTON PETERS + ASSOC. 44 E. MIFFLIN MADISON, WISCONSIN 53703 (608) 255-5656	JEFFERSON COUNTY LAW ENFORCEMENT CENTER JEFFERSON, WISCONSIN	AA41

SECTION: CLERK'S BENCH C2075		7/10/90
KENTON PETERS + ASSOC. 44 E. MIFFLIN MADISON, WISCONSIN 53703 (608) 255-5656	JEFFERSON COUNTY LAW ENFORCEMENT CENTER JEFFERSON, WISCONSIN	AA42

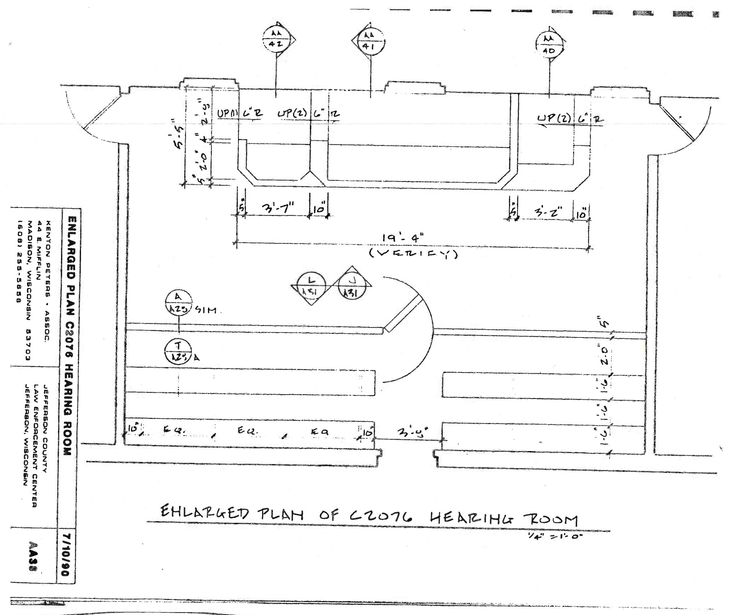


ENLARGED PLAN OF C2076 HEARING ROOM

ENLARGED PLAN C2076 HEARING ROOM		7/10/90
KENTON PETERS + ASSOC. 44 E. MIFFLIN MADISON, WISCONSIN 53703 (608) 255-5656	JEFFERSON COUNTY LAW ENFORCEMENT CENTER JEFFERSON, WISCONSIN	AA39

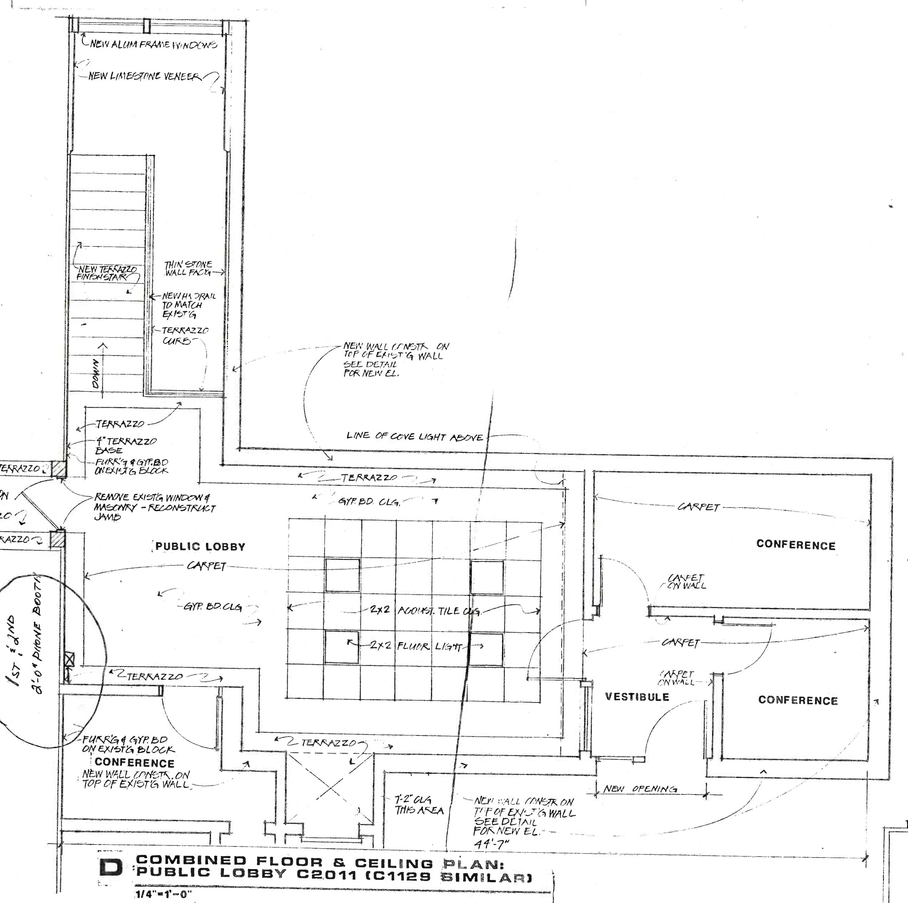


D COMBINED FLOOR & CEILING PLAN: PUBLIC LOBBY C2011 (C1129 SIMILAR)
1/4"=1'-0"

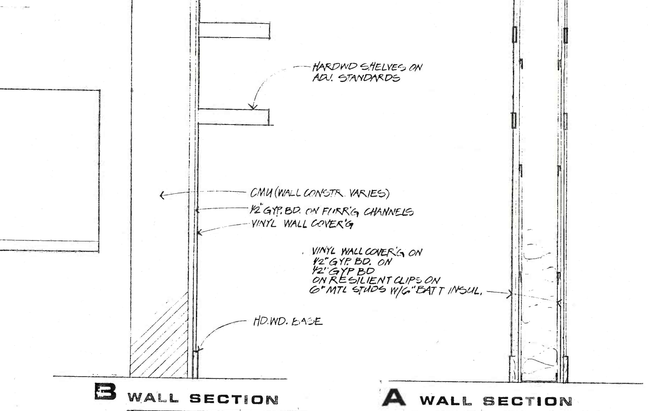


C W WALL EL.: JUDGE'S RECEPTION C2031
1/4"=1'-0"

B WALL SECTION
1"=1'-0"


A WALL SECTION

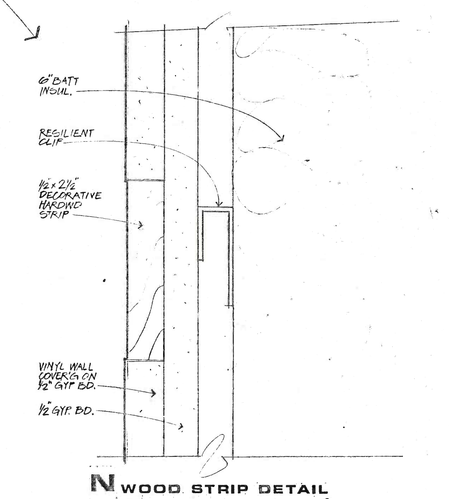

N WOOD STRIP DETAIL
FULL SCALE

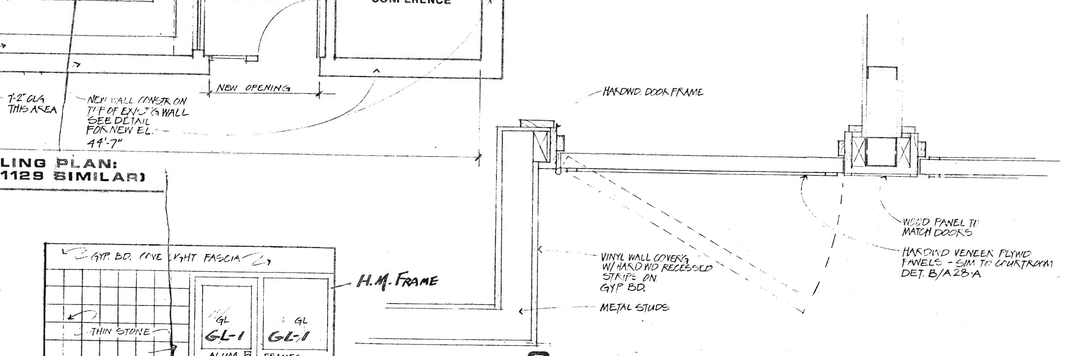


G DOOR DETAIL (RM C2032 SHOWN)
1-1/2"=1'0"

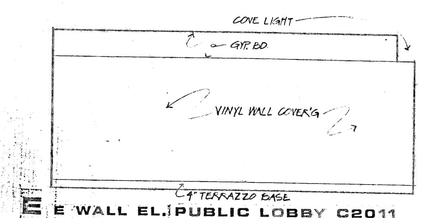


E E WALL EL. PUBLIC LOBBY C2011
1/4"=1'-0"


F S WALL EL. PUBLIC LOBBY C2011
1/4"=1'-0"

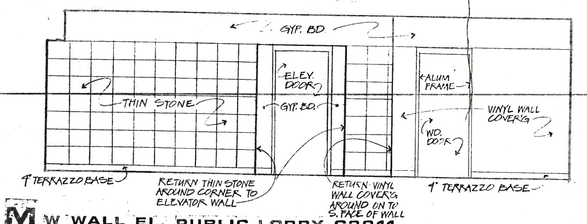


M W WALL EL. PUBLIC LOBBY C2011
1/4"=1'-0"

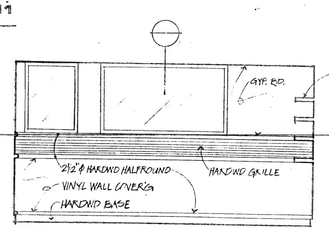


L W. ELEVATION: JUDGE'S CHAMBER
1/4"=1'-0"

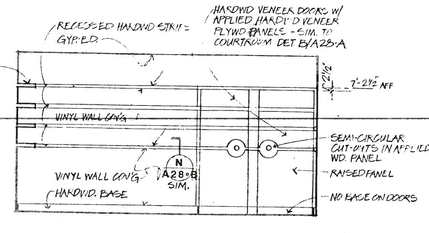

K E. ELEVATION: JUDGE'S CHAMBER
1/4"=1'-0"

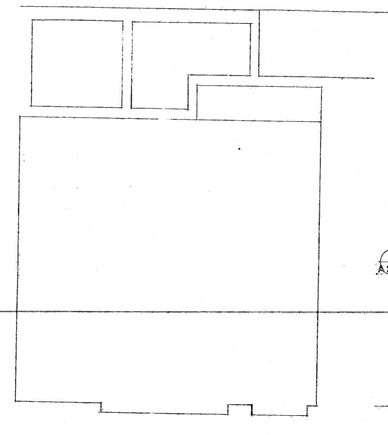

J REFLECTED CEILING PLAN: JUDGE'S CHAMBER (RM C2032 & C1115 SHOWN)
1/4"=1'-0"

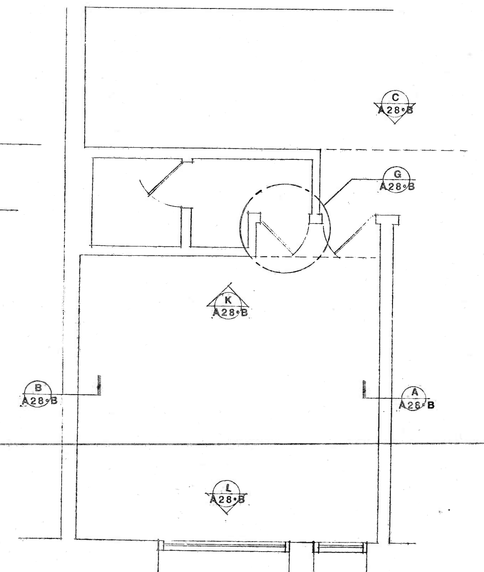

H FLOOR PLAN: JUDGE'S CHAMBER (RM C2032 & C1115 SHOWN)
1/4"=1'-0"

DATE	REVISION
	Detail 'F': Glass in Door and sidelight GL-1 Details E,F, M: Details refer to C1129 as well as C2011.
	DETAIL F: CHANG DOOR TO TYPE B WOOD DOOR: GLASS IN SIDELIGHT GL-1; FRAMES H.M.

STRUCTURAL CONSULTANT

MECHANICAL CONSULTANT

ARCHITECT
KENTON PETERS + ASSOC., INC.
44 E MIFFLIN
MADISON, WISCONSIN 53703
(608) 255-5656

JEFFERSON COUNTY
LAW ENFORCEMENT CENTER
JEFFERSON, WISCONSIN

LOBBY & JUDGE'S CHAMBERS DETAILS — 6-11-90

SCALE VARIES — A28 B

AS BUILT
DEC 6, 1994