
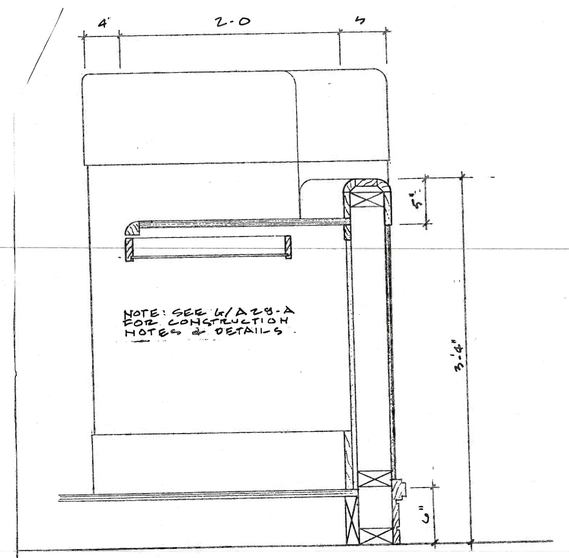



SECTION: CLERK'S BENCH
1½"=1'-0"


SECTION: CLERK'S BENCH C2075		7/10/90
KENTON PETERS + ASSOC. 44 E MIFFLIN MADISON, WISCONSIN 53703 (608) 255-5656	JEFFERSON COUNTY LAW ENFORCEMENT CENTER JEFFERSON, WISCONSIN	AA42

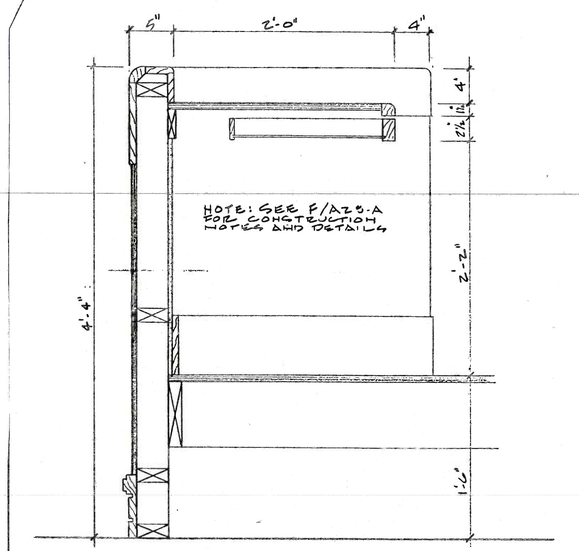

SECTION THROUGH COMMISIONER'S BENCH
1½"=1'-0"


SECTION: COMMISSIONER'S BENCH C2076		7/10/90
KENTON PETERS + ASSOC. 44 E MIFFLIN MADISON, WISCONSIN 53703 (608) 255-5656	JEFFERSON COUNTY LAW ENFORCEMENT CENTER JEFFERSON, WISCONSIN	AA41

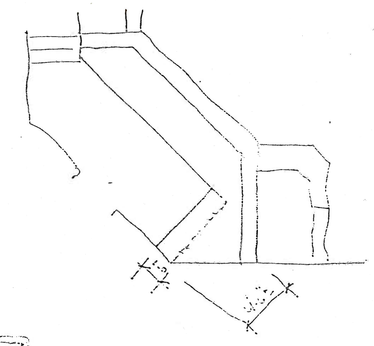


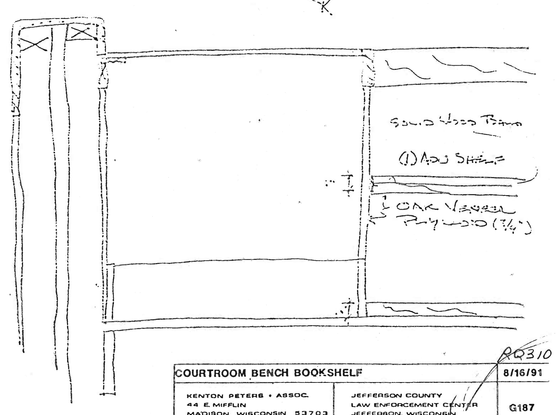

AQ310

COURTROOM BENCH BOOKSHELF		6/16/91
KENTON PETERS + ASSOC. 44 E MIFFLIN MADISON, WISCONSIN 53703 (608) 255-5656	JEFFERSON COUNTY LAW ENFORCEMENT CENTER JEFFERSON, WISCONSIN	G187

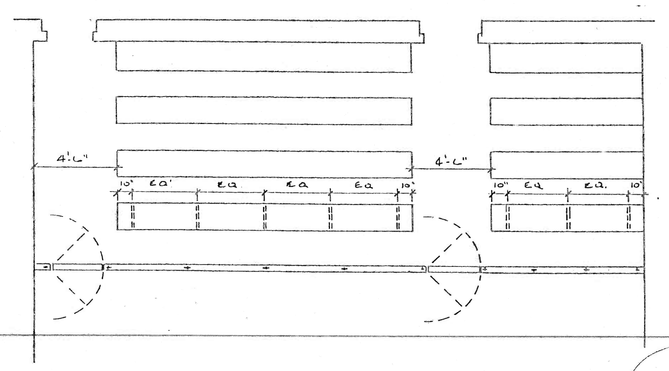

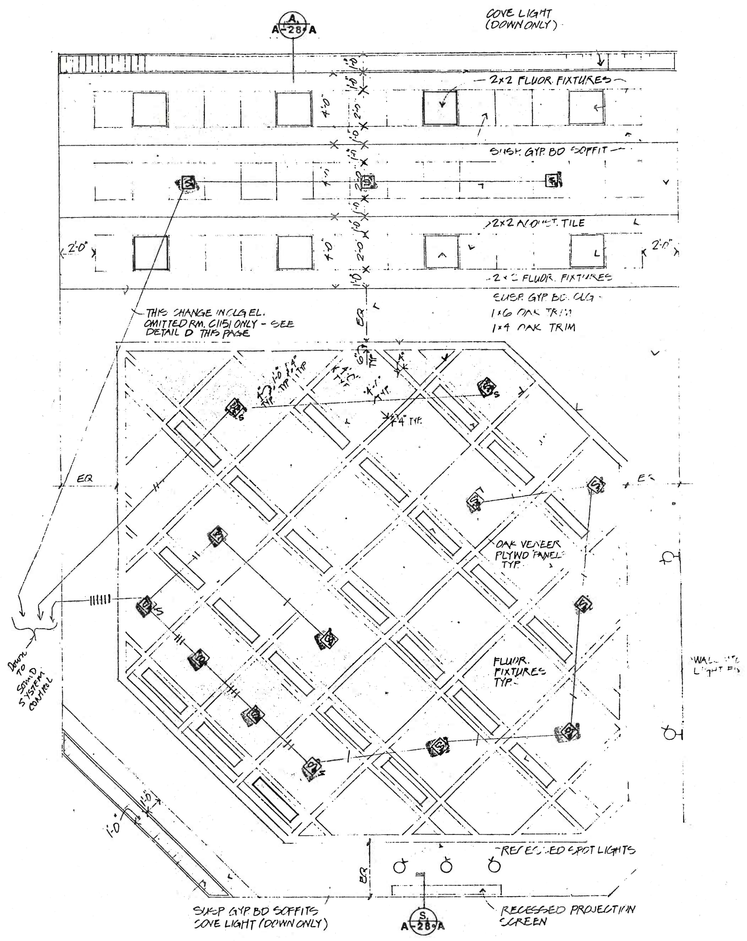

C REFLECTED CEILING PLAN
COURTROOM (C2014 SHOWN)
1/4"=1'-0"

COURTROOM C1122 AUDIENCE PLAN		6/19/91
KENTON PETERS + ASSOC. 44 E MIFFLIN MADISON, WISCONSIN 53703 (608) 255-5656	JEFFERSON COUNTY LAW ENFORCEMENT CENTER JEFFERSON, WISCONSIN	G173 A-38

SOUND SYSTEM CEILING PLAN		6/16/91
KENTON PETERS + ASSOC. 44 E MIFFLIN MADISON, WISCONSIN 53703 (608) 255-5656	JEFFERSON COUNTY LAW ENFORCEMENT CENTER JEFFERSON, WISCONSIN	G172

KENTON PETERS + ASSOCIATES, INC.
324 SOUTH HAMILTON STREET
MADISON, WI 53703
(608) 255-5656

A28
SUPPLEMENTARY DRAWINGS

AS BUILT
DEC 6, 1994