
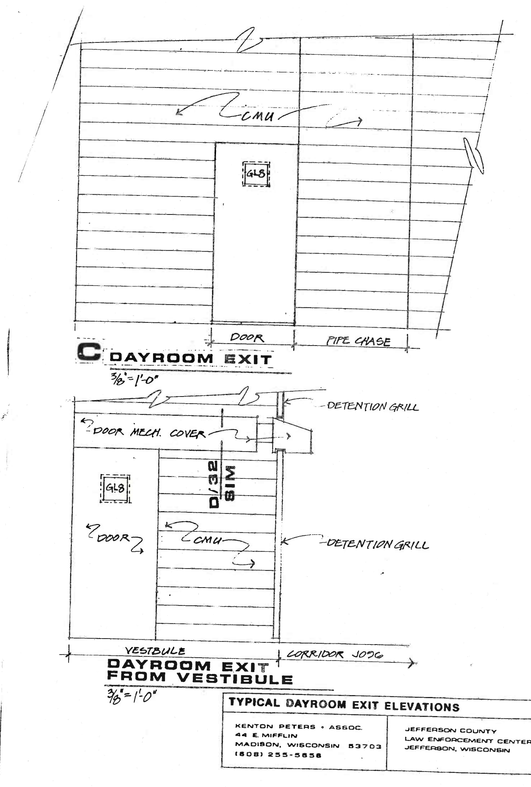


TYPICAL DAYROOM EXIT ELEVATIONS		7/10/90
KENTON PETERS + ASSOC. 44 E. MIFFLIN MADISON, WISCONSIN 53703 (608) 255-5656	JEFFERSON COUNTY LAW ENFORCEMENT CENTER JEFFERSON, WISCONSIN	AA51

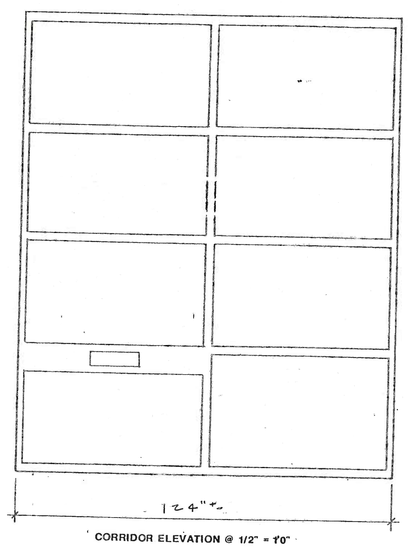

CORRIDOR ELEVATION @ 1/2" = 1'0"

DAYROOM J100 FRONT		3/14/91
KENTON PETERS + ASSOC. 44 E. MIFFLIN MADISON, WISCONSIN 53703 (608) 255-5656	JEFFERSON COUNTY LAW ENFORCEMENT CENTER JEFFERSON, WISCONSIN	GJ38

AS BUILT
DEC 6, 1994

KENTON PETERS + ASSOCIATES, INC.
324 SOUTH HAMILTON STREET
MADISON, WI 53703
(608) 255-5656