
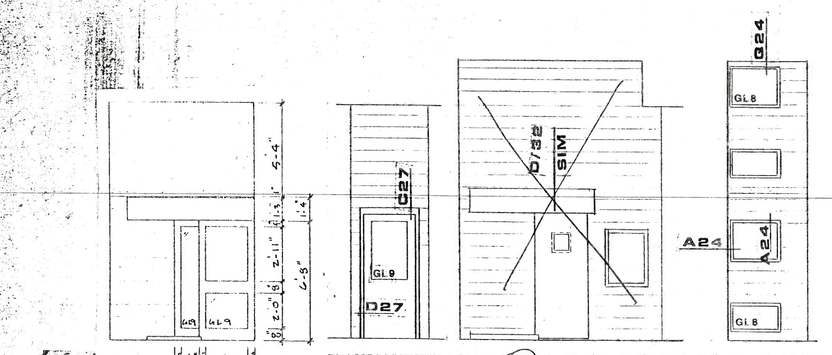


A

REPLACES A/A29

B EMERGENCY EXIT

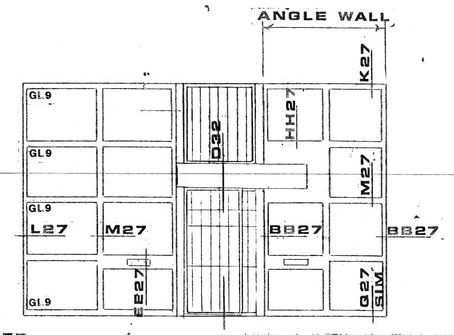


C DAYROOM EXIT


SEE BACK OF PRECEDING PAGE

D SHOWER

E CORRIDOR TO DAYROOM

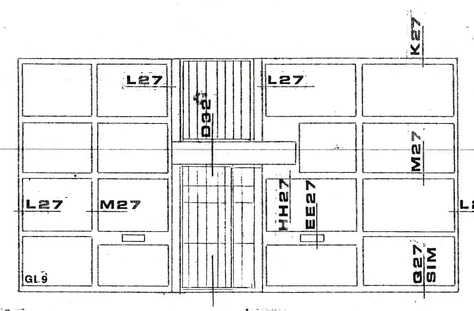


F

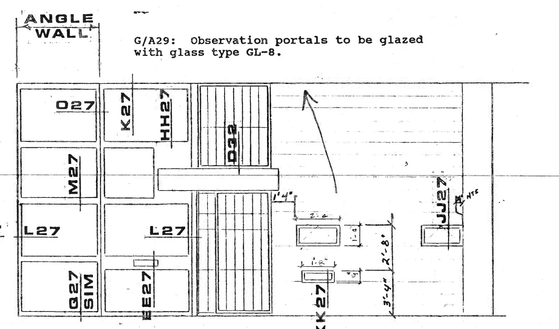



G/A29: Observation portals to be glazed with glass type GL-8.

G

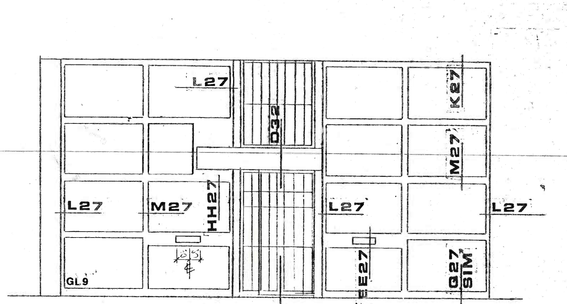


H

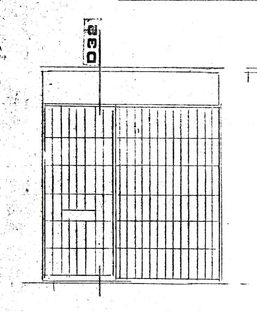


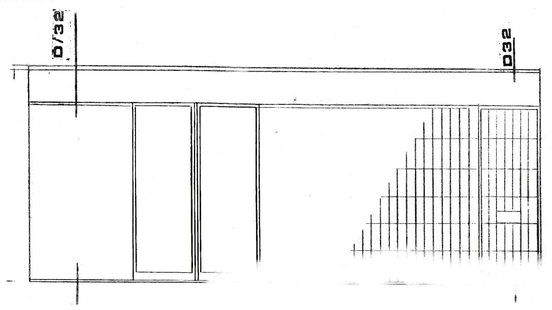


J TYPICAL CELL

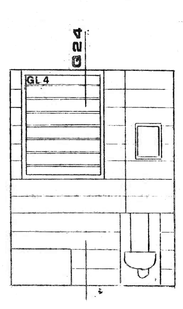

K

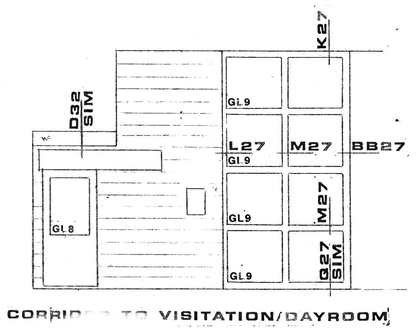

M CORRIDOR TO VISITATION/DAYROOM

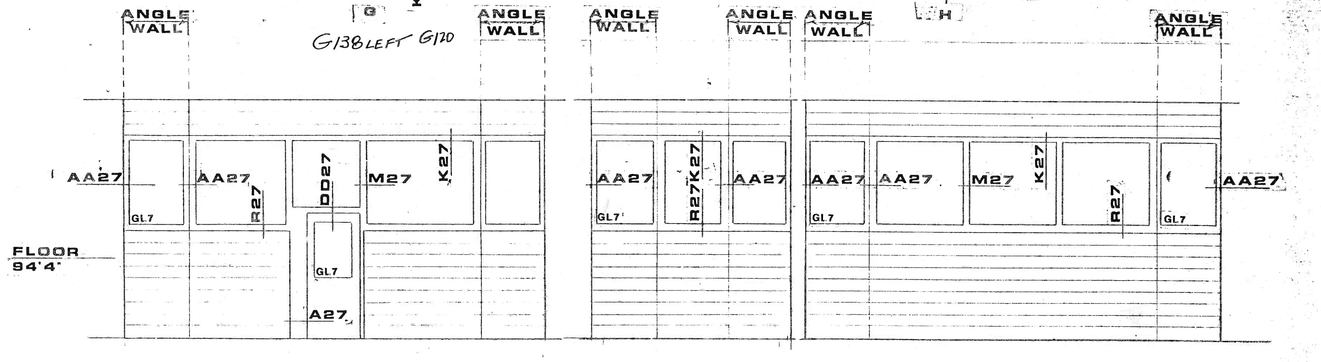


N POD CONTROL CENTER

O


P

JAIL INTERIOR ELEVATIONS

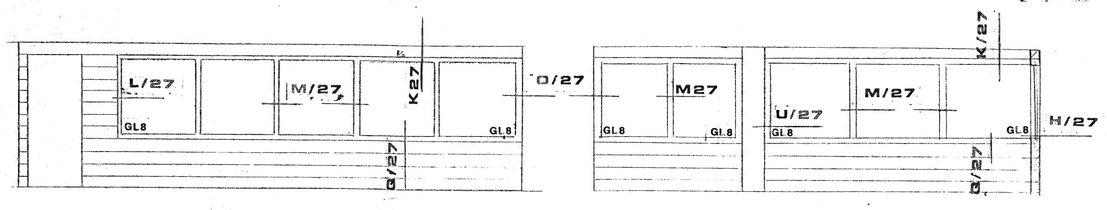


Q JAIL VISITATION

R VISITATION INTERIOR

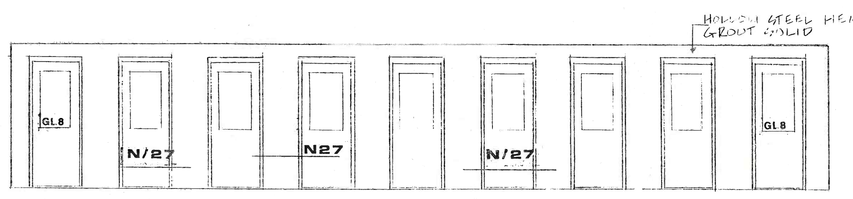


S JAIL VISITATION

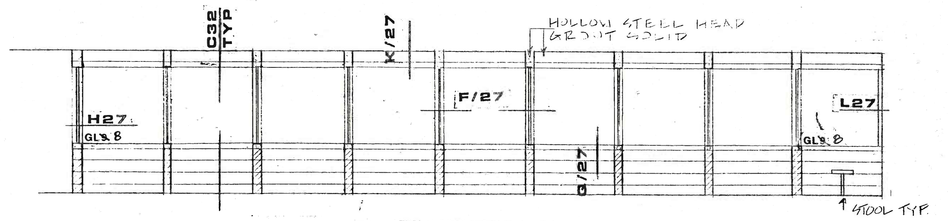


T VISITATION INTERIOR

T/A29: Visitation rooms to be glazed with glass type GL-8.


CLARIFICATION OF FRAMES SEE #1 BELOW

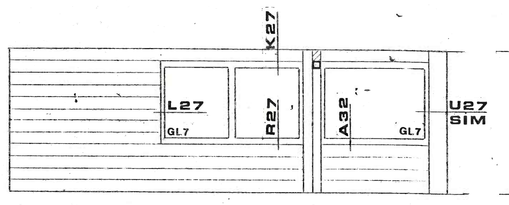


U JAIL CONTROL

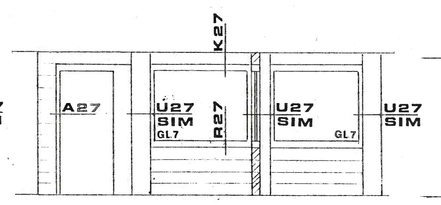

V JAIL CONTROL

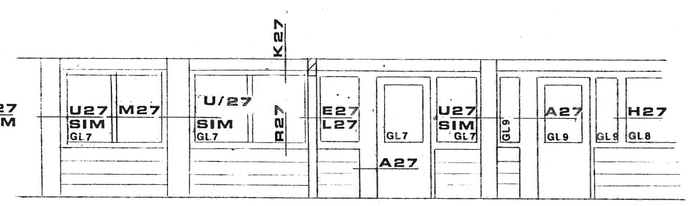

W JAIL CONTROL

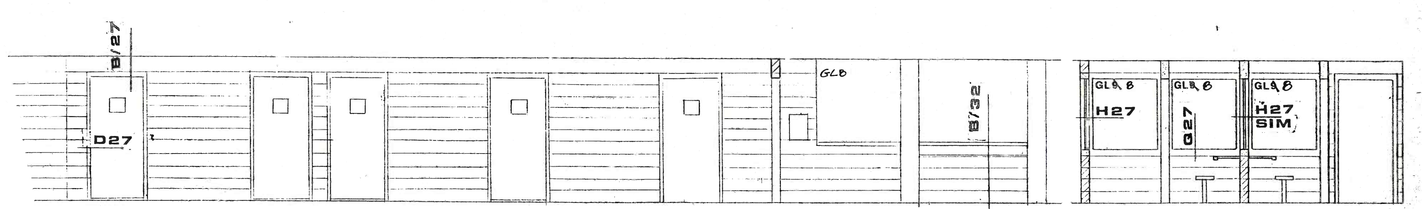


X HOLDING CELLS

X BOOKING


X/A29: Observation portals in holding cell door to be glazed with glass type GL-8.

Y VISITATION INTERIOR


Y/A29: Visitation rooms to be glazed with glass type GL-8.

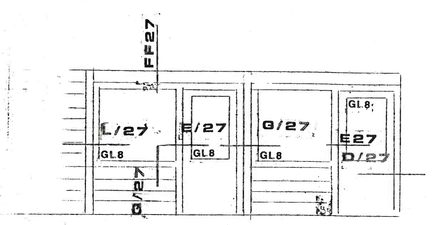


Z CONFERENCE

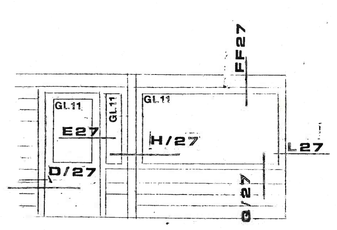

AA LINEUP

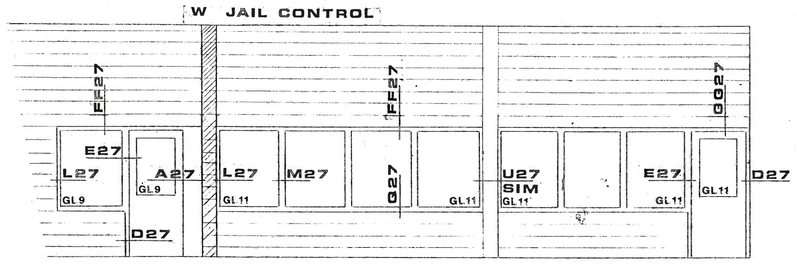


CC SALLYPORT BB MULTI-USE ROOM

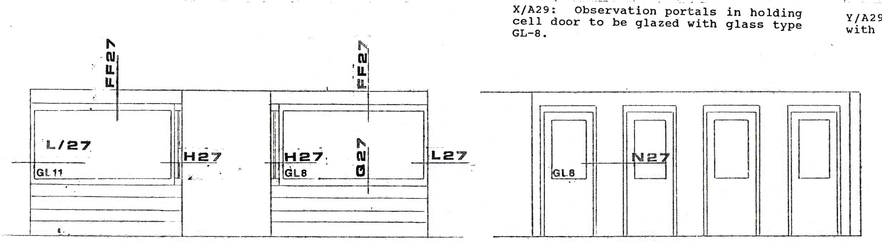

DD CONFERENCE


HUBER VISITATION EE

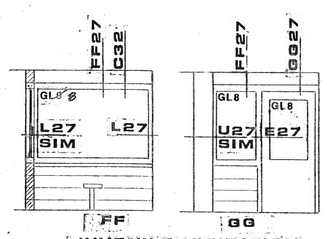


FF GG

JUVENILE VISITATION

FF/A29: Juvenile rooms to be glazed with glass type GL-8.

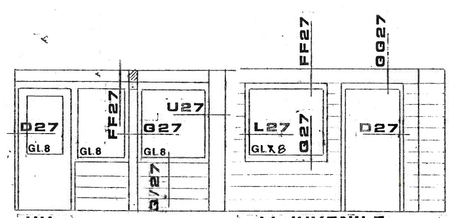


HH JJ JUVENILE DAYROOM

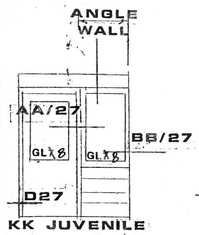


KK JUVENILE MULTIPURPOSE

KK/A29: Juvenile multipurpose room to be glazed with glass type GL-8.

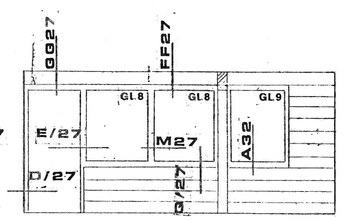


JUVENILE OFFICE

BB

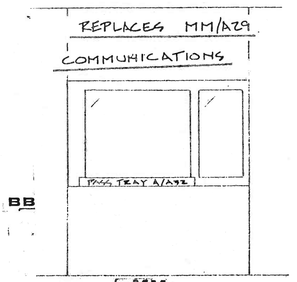



MM COMMUNICATIONS

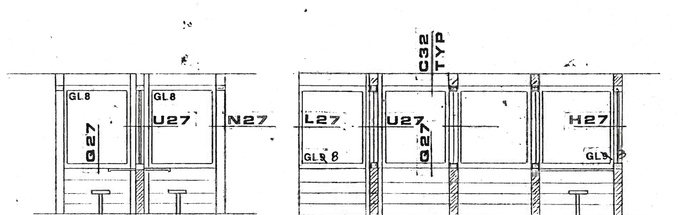


NN HUBER VISITATION OO

OO/A29: Huber visitation rooms to be glazed with glass type GL-8.

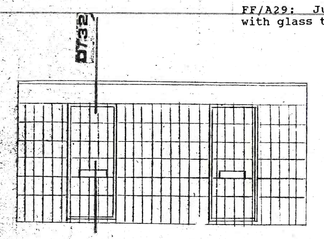


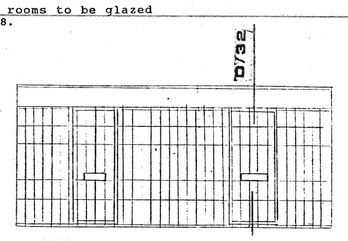


PP JUVENILE CELLS QQ

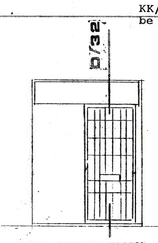


RR HOLDING CELL INTERIOR

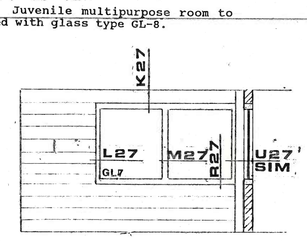


XX SECURE VESTIBULE

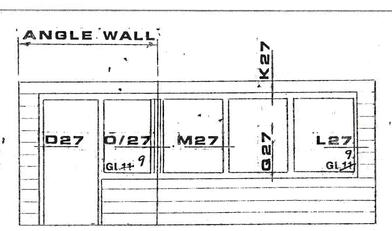

TT SECRETARY

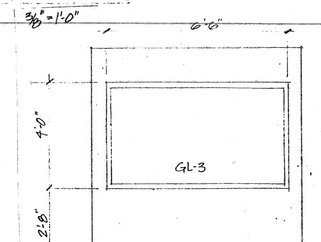

N. ELEVATION: S1064

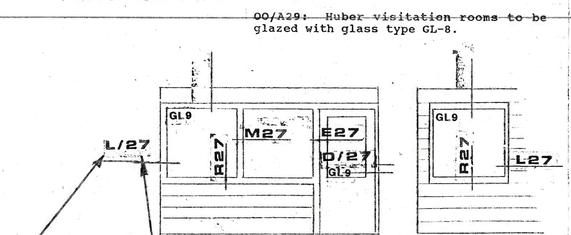

DETAIL NO. 1 SHEET NO. A27

VV COMMUNICATIONS WW

HOLLOW METAL FRAMES

DATE	REVISION
	Elevation TT change glass type to GL-9
#1	At Visitation Rooms J006: Frames at Borrowed Lites in Elevation T/A29, that is the wall between inmate visitation and public visitation, are Hollow Steel. Borrowed Lite Frames south of this wall (inmate side) are Hollow Steel and Frames north of this wall (public side) are Hollow Metal. At visitation rooms J004: Frames at Elevation 00/A29, that is the wall between inmate visitation and public visitation are Hollow Steel. Borrowed Lite Frames to the west (inmate side) of this wall are Hollow Steel and Frames to the east of this wall (public side) are Hollow Metal. Borrowed Lite Frames between J007 and J006 are Hollow Steel.

STRUC

MECHA

ARCHITECT
KENTON PETERS + ASSOC., INC.
44 E MIFFLIN
MADISON, WISCONSIN 53703
(608) 255-5656

JEFFERSON COUNTY
LAW ENFORCEMENT CENTER
JEFFERSON, WISCONSIN

INTERIOR ELEVATIONS

SCALE 1/4"=1'-0" EXCEPT AS SHOWN

8-1-95

A29

AS BUILT
DEC 6, 1994