




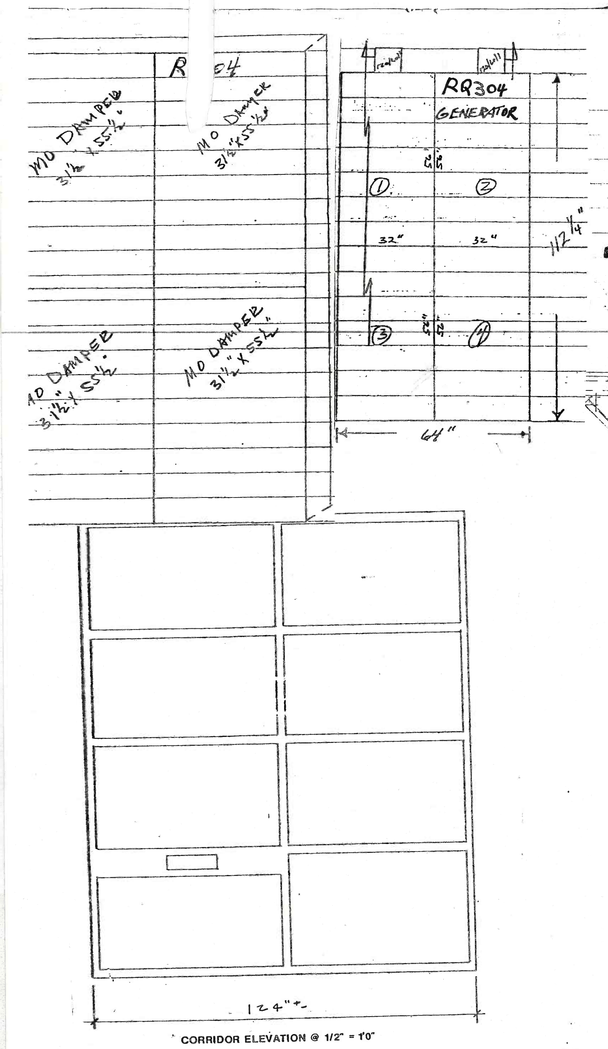


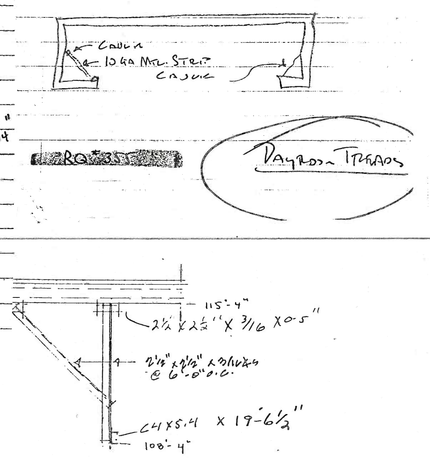


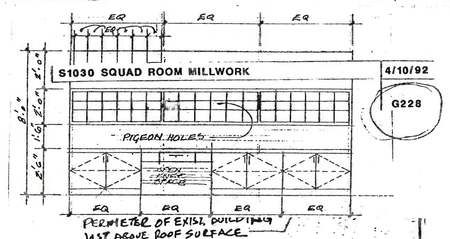

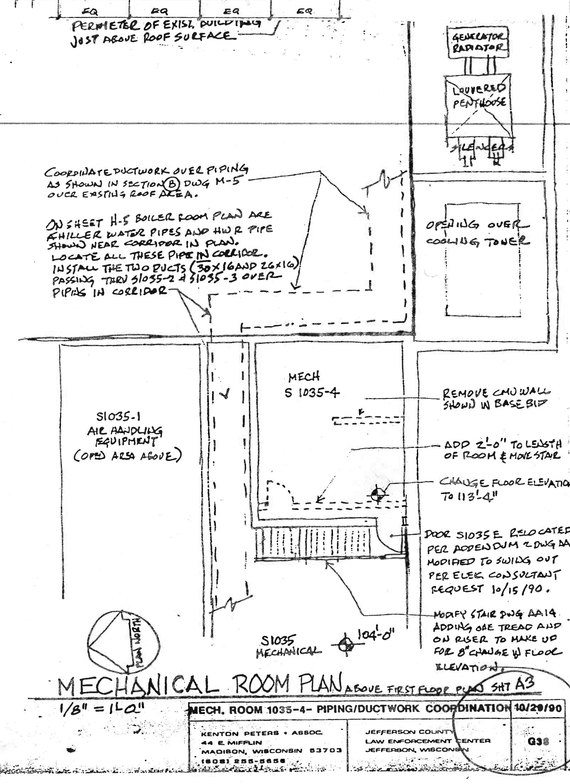

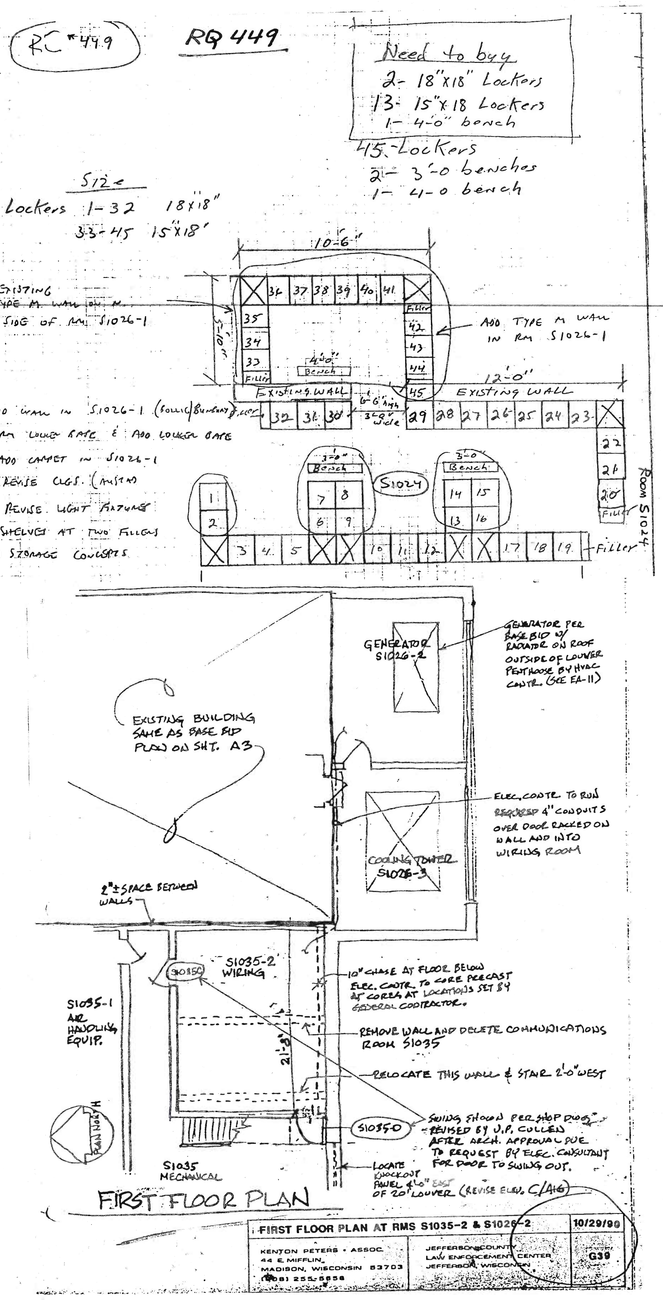

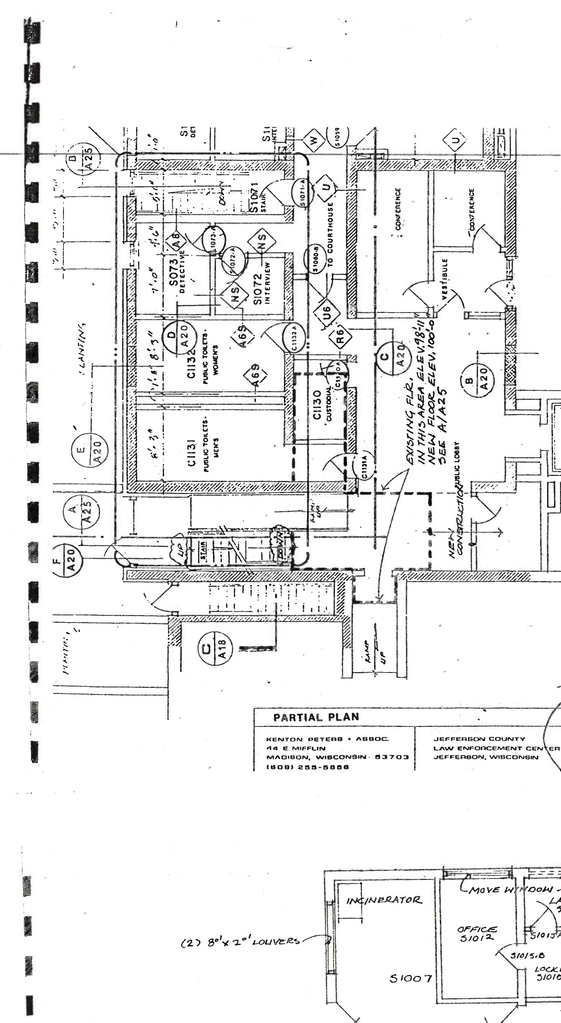

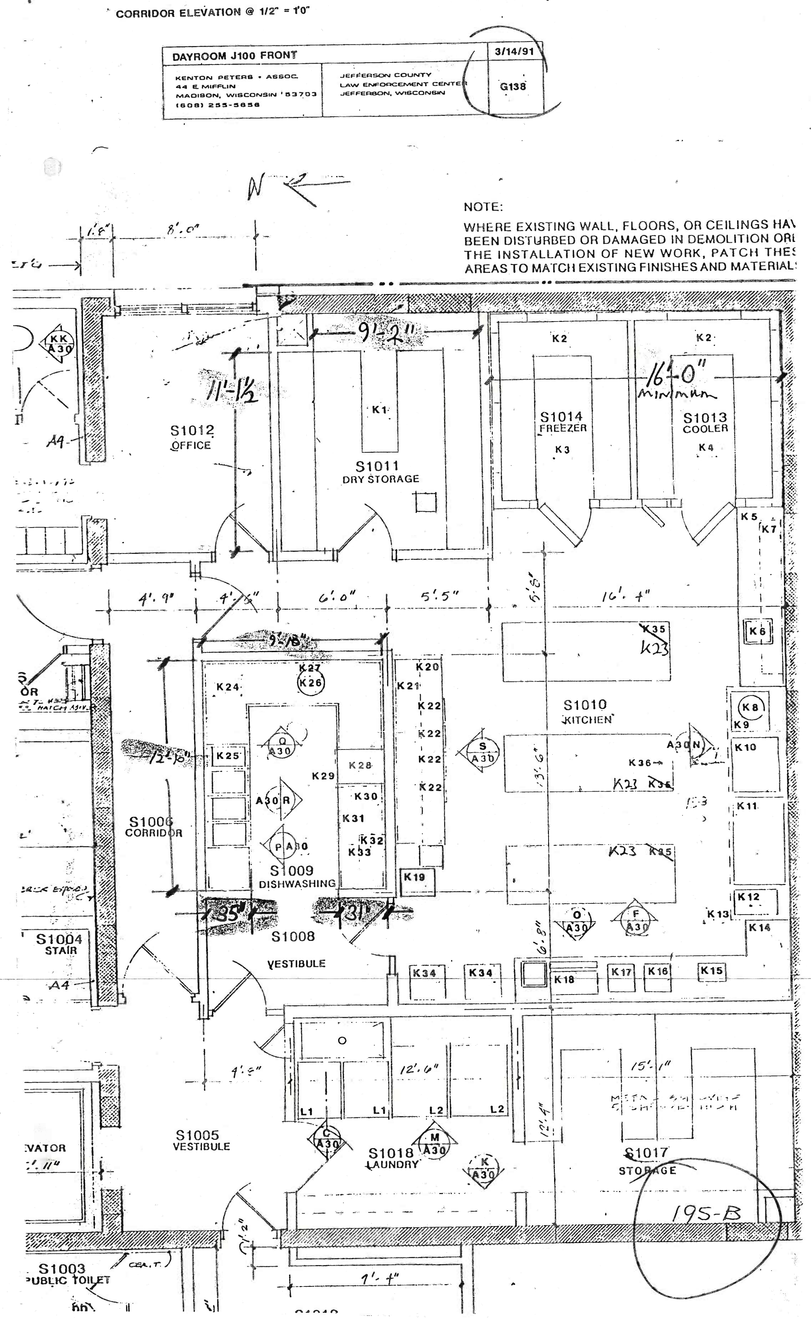

KENTON PETERS + ASSOCIATES, INC.
324 SOUTH HAMILTON STREET
MADISON, WI 53703
(608) 255-5656

AS BUILT
DEC 6, 1994

A3
SUPPLEMENTARY DRAWINGS