

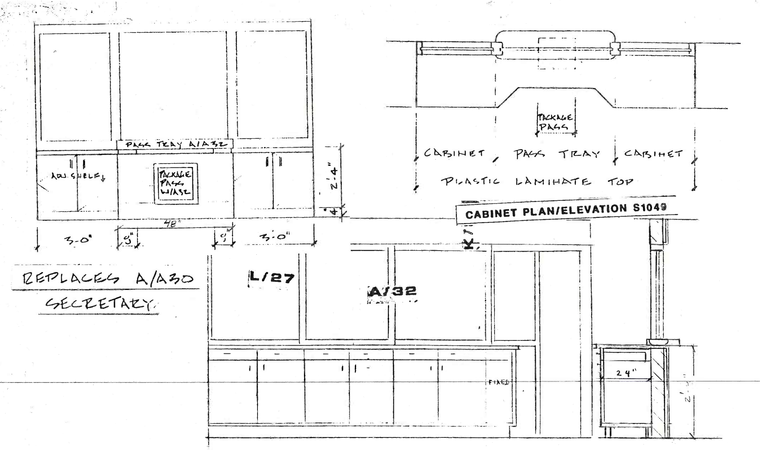


A SECRETARYS DESK S1049

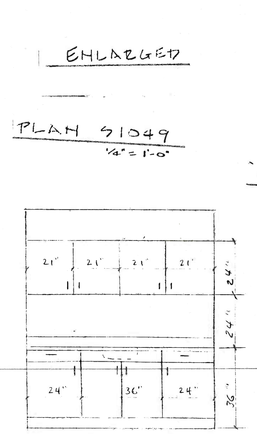



B DISPATCH LOUNGE S1046

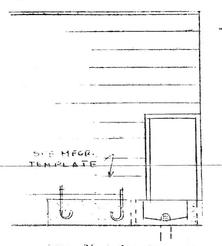


C LAUNDRY S1018

EHLARGED PLAN S1049
1/2" = 1'-0"

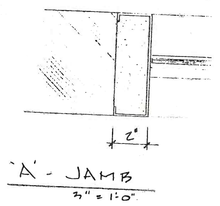


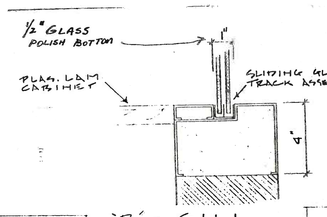

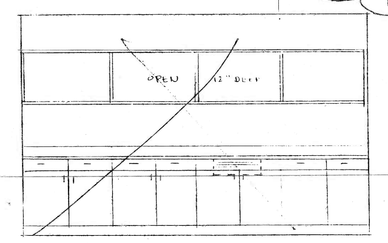

D

SEE LEFT G220

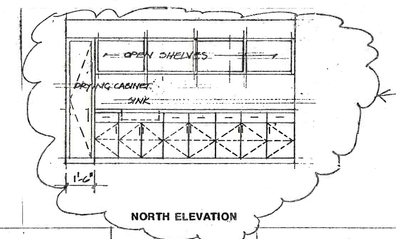

G220



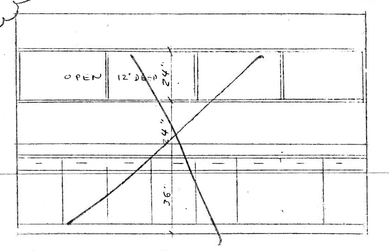


PHOTO LAB S1037


E

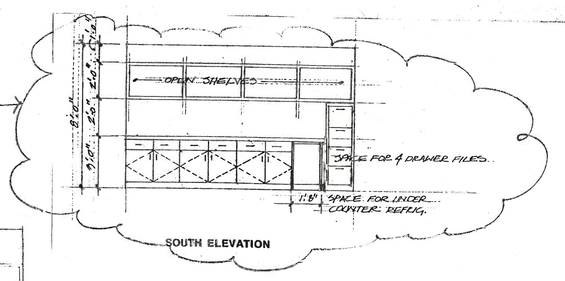


Detail 'F' Cooks Table:
Provide two under-counter drawers: Provide with lock and key.

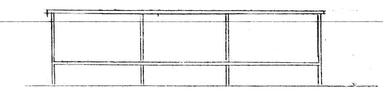


F COOKS TABLE

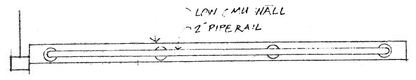

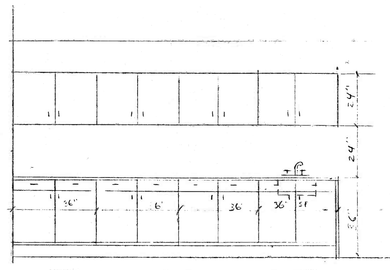


G JO87 PROCESSING

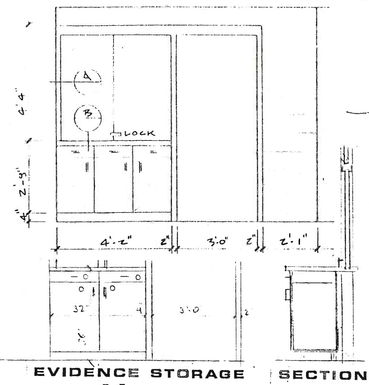


EVIDENCE STORAGE SECTION

H

REPLACES H/A30

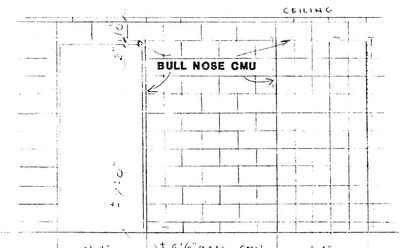


J EXPOSED CMU WALLS

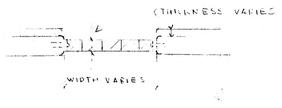



L

2. Detail 'K' Sorting Room S1018: Provide locks for all eight cabinet doors.

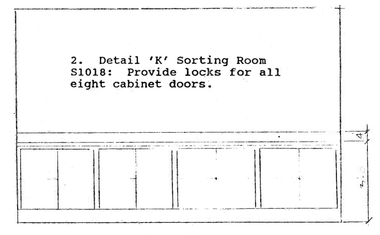


K SORTING S1018

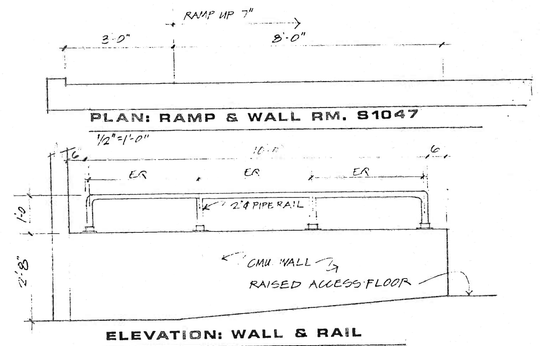


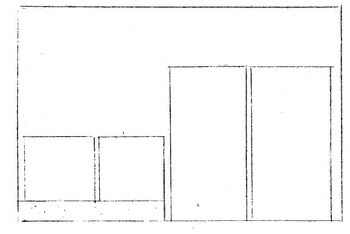

M WASHERS DRYERS S1018

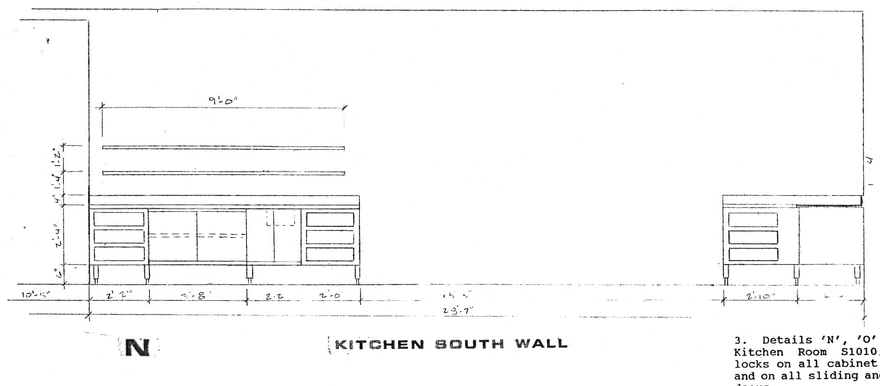


N KITCHEN SOUTH WALL

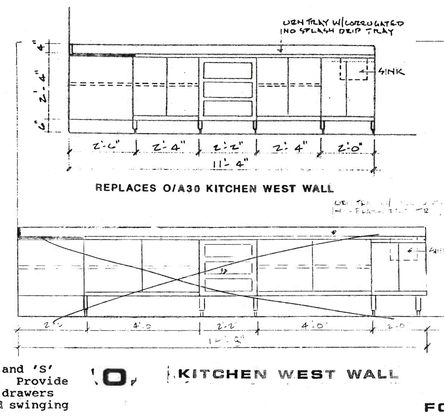


O KITCHEN WEST WALL


3. Details 'N', 'O' and 'S' Kitchen Room S1010; Provide locks on all cabinet drawers and on all sliding and swinging doors.

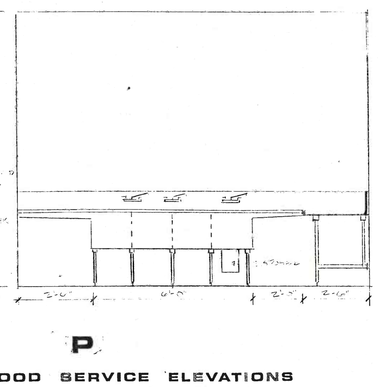


P FOOD SERVICE ELEVATIONS S1010

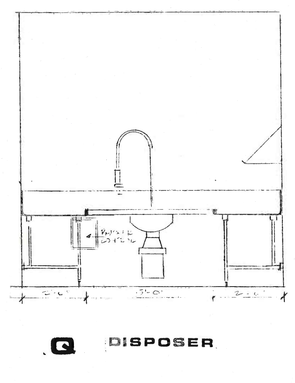


Q DISPOSER

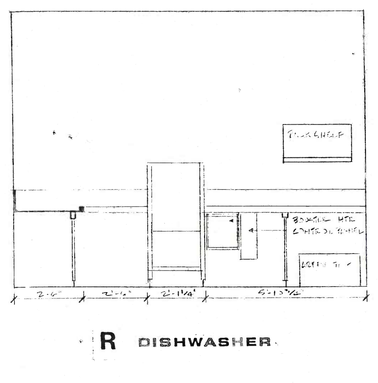


R DISHWASHER

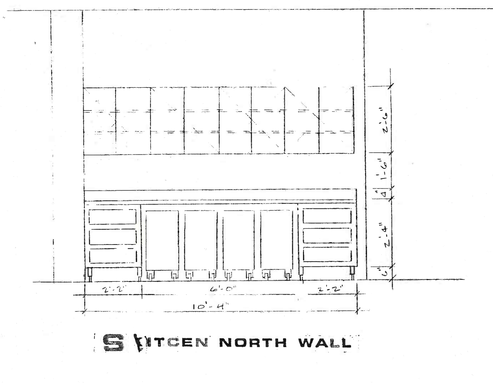


S KITCEN NORTH WALL

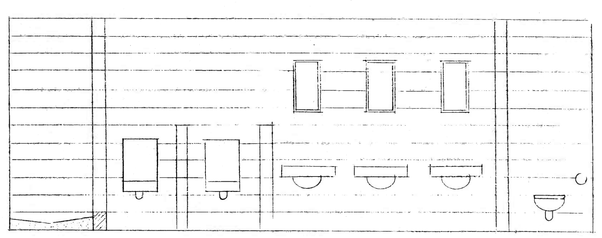


T HUBER MENS TOILET J057

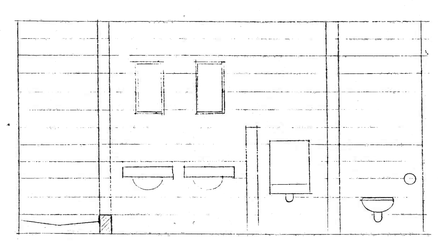


U HUBER MENS TOILET J053

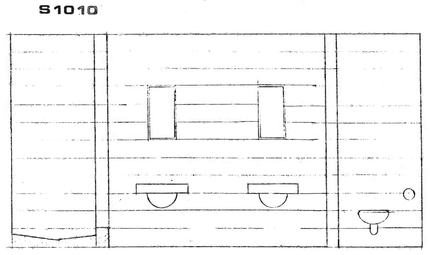


V HUBER LADIES TOILET J047

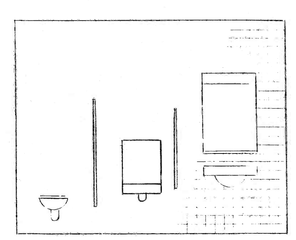


W MEN SHERIFF DEPT TOILET S1023

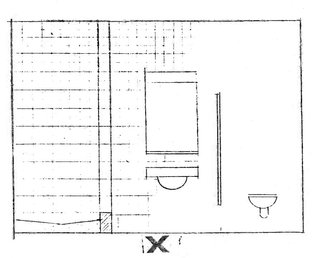


X LADIES SHERIFF DEPT TOILET S1025

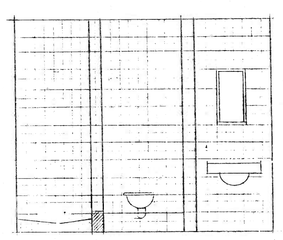

Y HUBER MENS TOILET J069

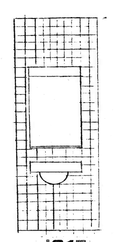


J017 J024

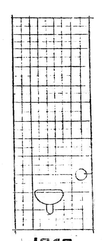

J018 J024

Z CONTROL ETC. TOILETS

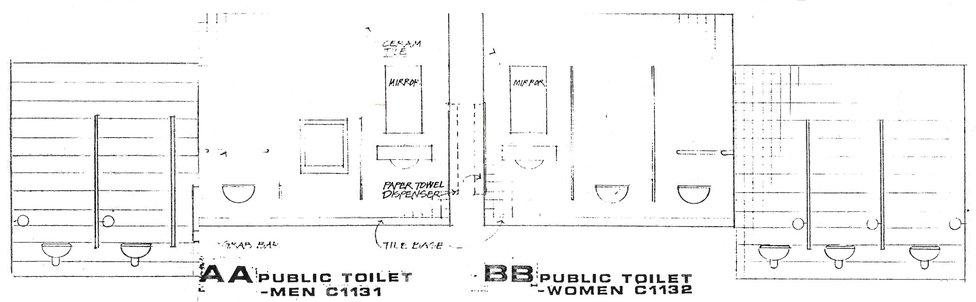


AA PUBLIC TOILET -MEN C1131

BB PUBLIC TOILET -WOMEN C1132


AA COURT MENS TOILET C1131

BB COURT LADIES TOILET C1132

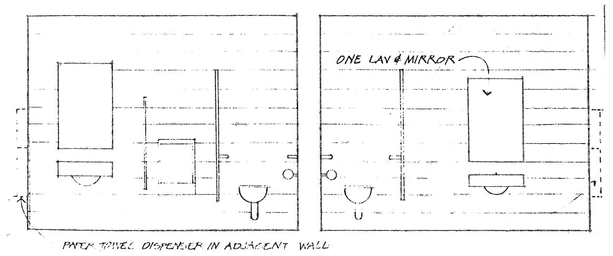


CC MENS PUBLIC TOILET S1002


DD LADIES PUBLIC TOILET S1003

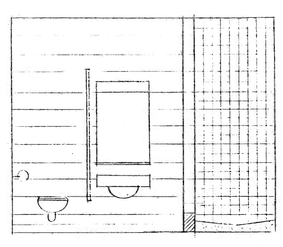


EE JAIL STAFF LADIES J032

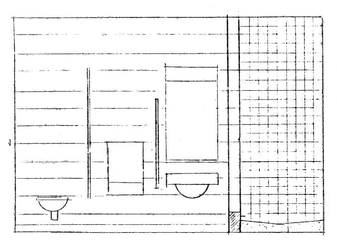


FF JAIL STAFF MEN J030

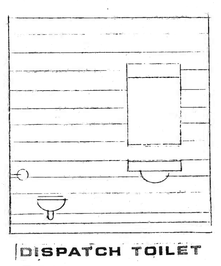


DISPATCH TOILET S0145 GG

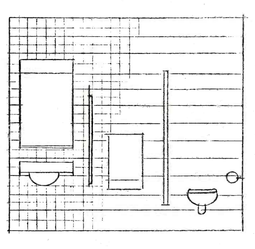

HH MENS STAFF TOILET S 1044

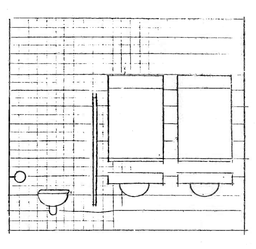

JJ LADIES STAFF TOILET S1043

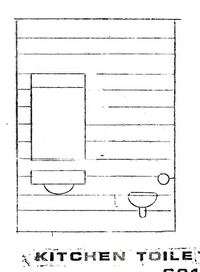

KK KITCHEN TOILET S015

LL REPORTS DESK S1028

SECTION

4. Detail 'MM' Examination Room J022: Provide locks on upper and and lower cabinet doors and drawer.

MM J022 EXAMINATION

NN SHOWER CURB 3'-1'-0"

AS BUILT
DEC 6, 1994

DATE	REVISION

STRUCTURAL CONSULTANT

MECHANICAL CONSULTANT

ARCHITECT

KENTON PETERS + ASSOC., INC.
44 E MIFFLIN
MADISON, WISCONSIN 53703
(608) 255-5656

JEFFERSON COUNTY
LAW ENFORCEMENT CENTER

JEFFERSON, WISCONSIN

INTERIOR ELEVATIONS

SCALE 3/8"-1'-0"
EXCEPT AS SHOWN

5-11-96

A30