



REPLACES A/A31 CLERK OF COURTS

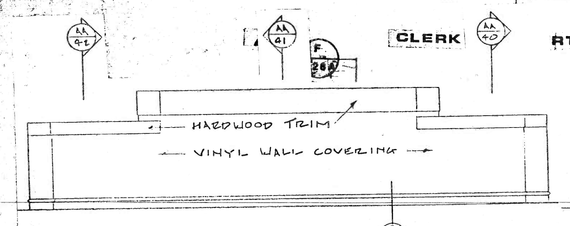

CLERK COMMISIONER' BENCH WITNESS IONER


REPLACES J/A31

3/8"=1'-0"

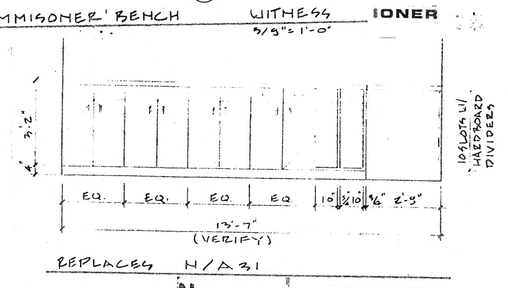

REPLACES N/A31


N CHILD SUPPORT

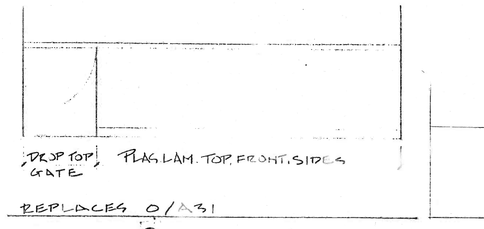

REPLACES O/A31


O

P DISTRICT ATTORNEY

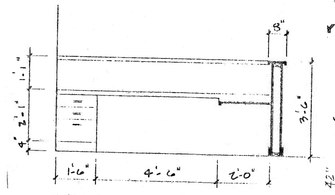


REPLACES Q/A31

Q

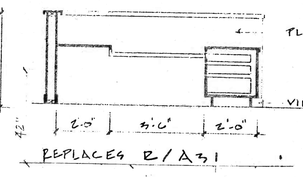


REPLACES R/A31

R DISTRICT ATTORNEY

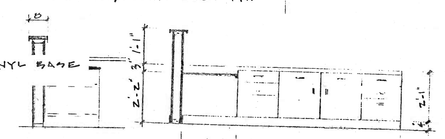


REPLACES S/A31
RECEPTION DESK IN ROOM C2043

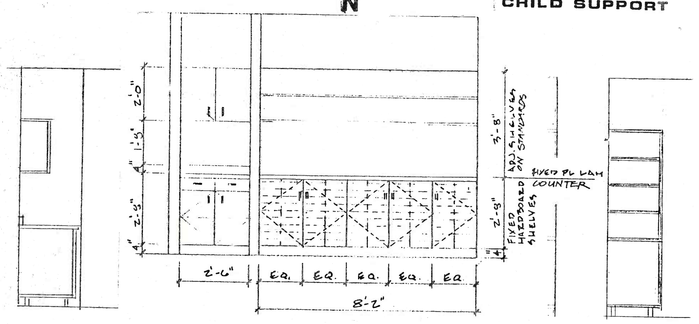

REPLACES U/A31 CHILDSUPORT


3/8"=1'-0"

T V

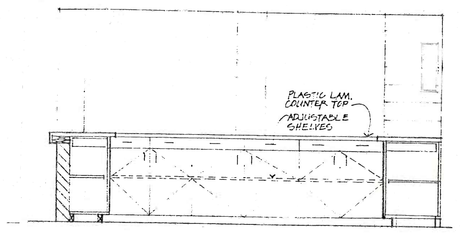


W ELEVATION

3/8"=1'-0"

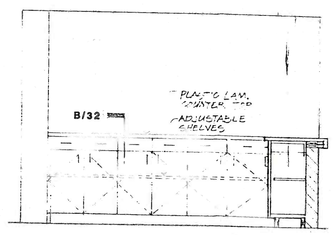


X ELEVATION BOOKING


3/8"=1'-0"

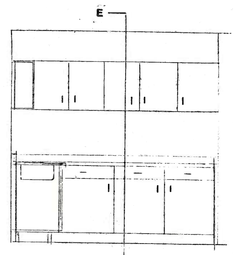


Y BOOKING

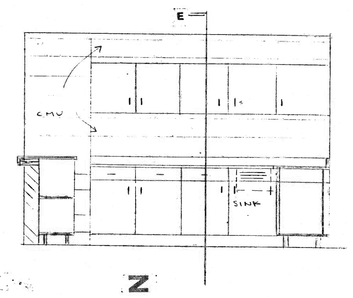


Z

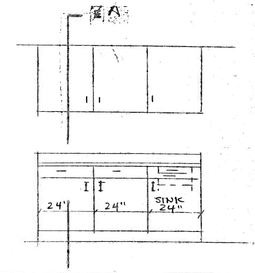

STAFF LOUNGE BB

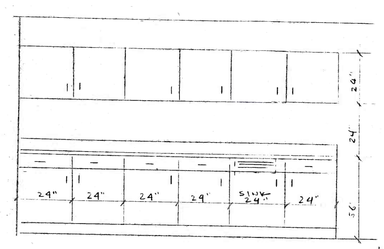



CC PROCESSING

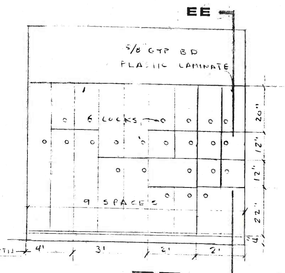


DD EVIDENCE EE

2. Detail 'DD' and 'EE' Room J090 secure evidence storage. Install individually keyed snap lockes on all cabinet doors.

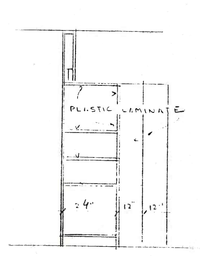


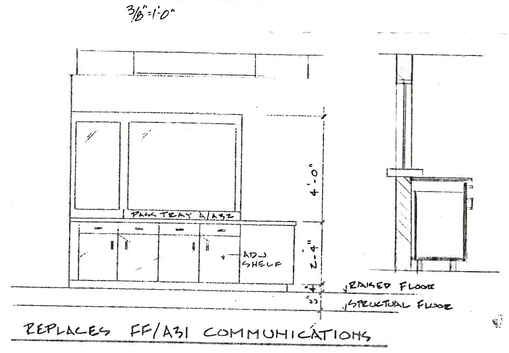

REPLACES FF/A31 COMMUNICATIONS

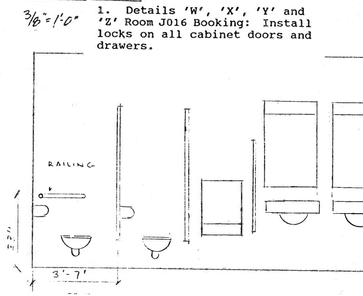


GG C2007 MENS TOILET

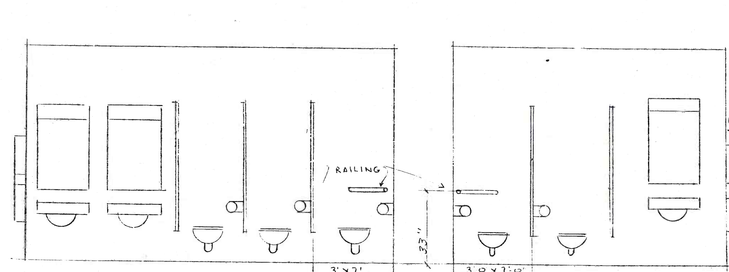


HH C2008 WOMENS TOILET

JJ C1102 & C2071 WOMENS TOILET

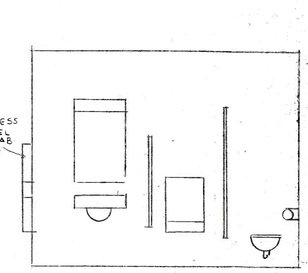


KK C1103 & C2072 MENS TOILET

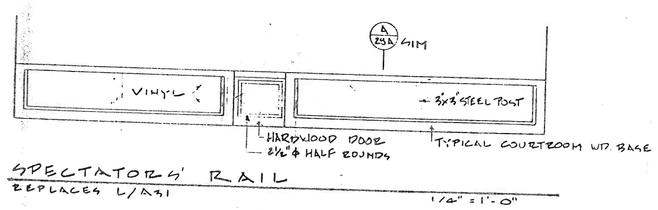


SPECTATORS' RAIL

REPLACES L/A31


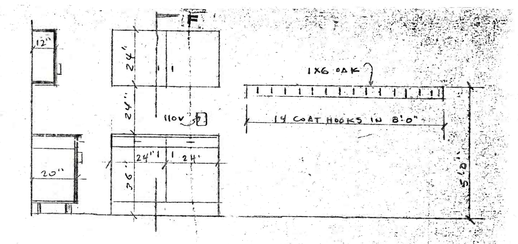


F G JURY ROOMS H

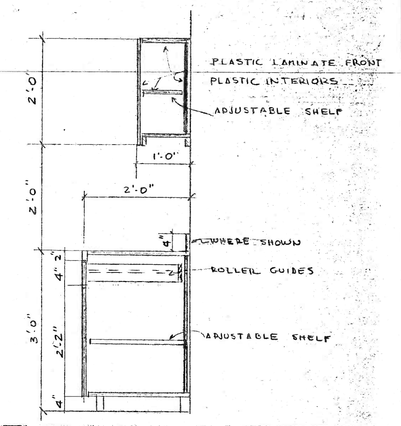


E TYP. WALL & BASE CABINETS


3/4"=1'-0"

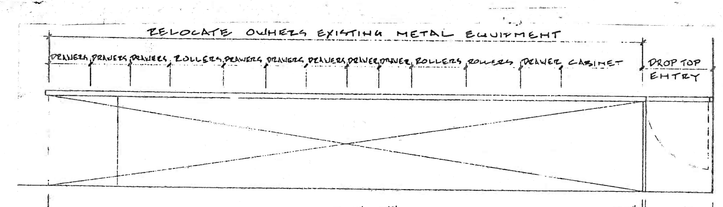

REPLACES B/A31 CLERK OF COURTS JRT

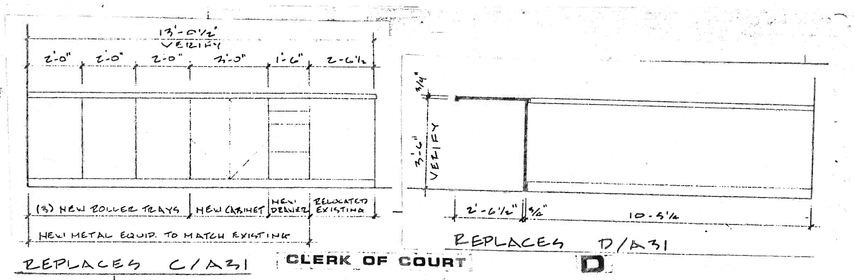


REPLACES C/A31 CLERK OF COURT D

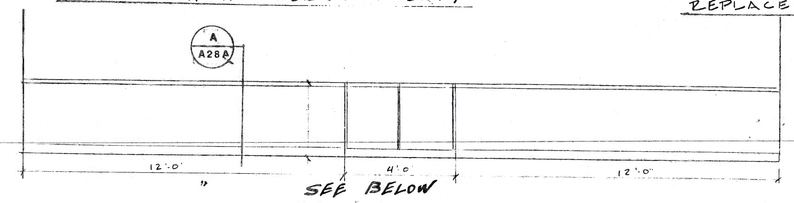

SEE BELOW

L FAMILY COURT COMMISSIONER

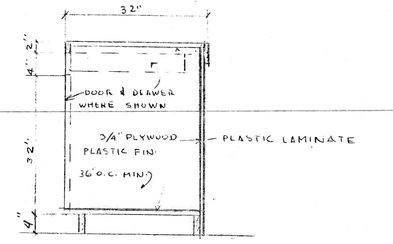

TYPICAL COUNTER 3/4"=1'-0"

1. Details 'W', 'X', 'Y' and 'Z' Room J016 Booking: Install locks on all cabinet doors and drawers.

2. Detail 'DD' and 'EE' Room J090 secure evidence storage. Install individually keyed snap lockes on all cabinet doors.

AS BUILT
DEC 6, 1994

DATE	REVISION

STRUCTURAL CONSULTANT

MECHANICAL CONSULTANT

ARCHITECT
KENTON PETERS + ASSOC., INC.
44 E MIFFLIN
MADISON, WISCONSIN 53703
(608) 255-5656

JEFFERSON COUNTY
LAW ENFORCEMENT CENTER
JEFFERSON, WISCONSIN

INTERIOR ELEVATIONS
CABINETS
SCALE 3/8"=1'-0"
EXCEPT AS NOTED

05-11-90
A31