

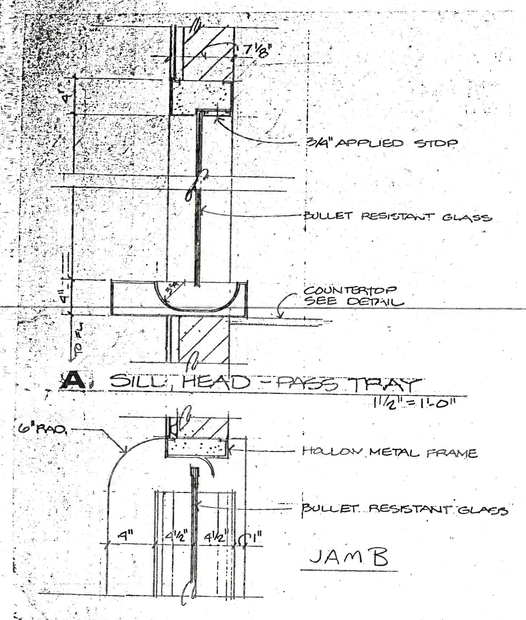



A SILL, HEAD - PASS TRAY
1 1/2" = 1'-0"

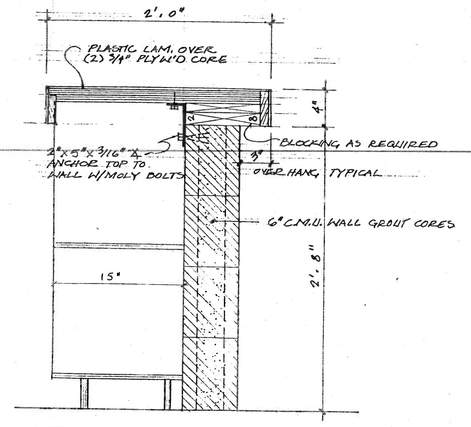

B BOOKING AREA COUNTER

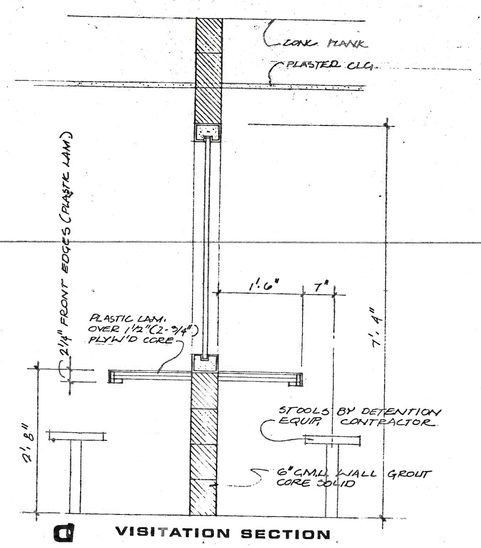


C VISITATION SECTION

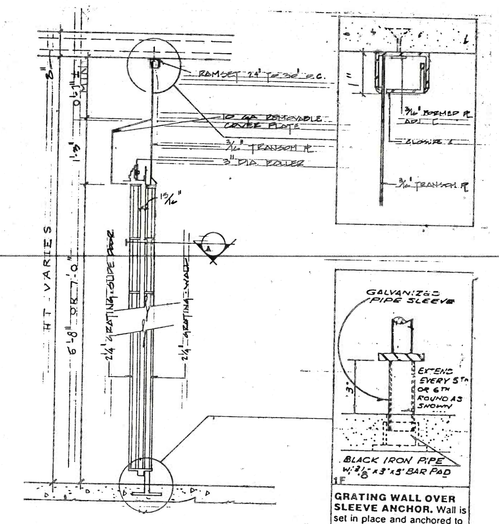



D CELL DOOR DETAIL

E

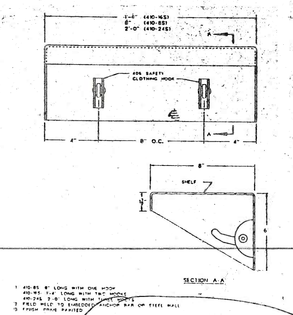


F TRAY ACCESS

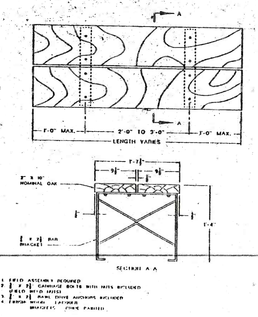

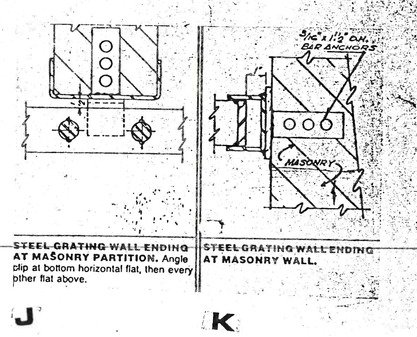


J

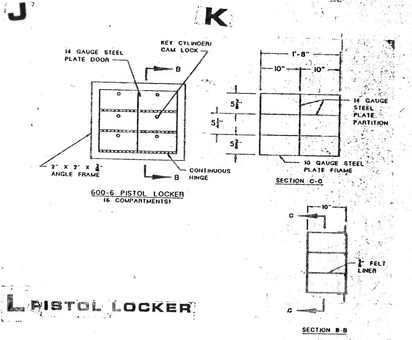


K

L PISTOL LOCKER

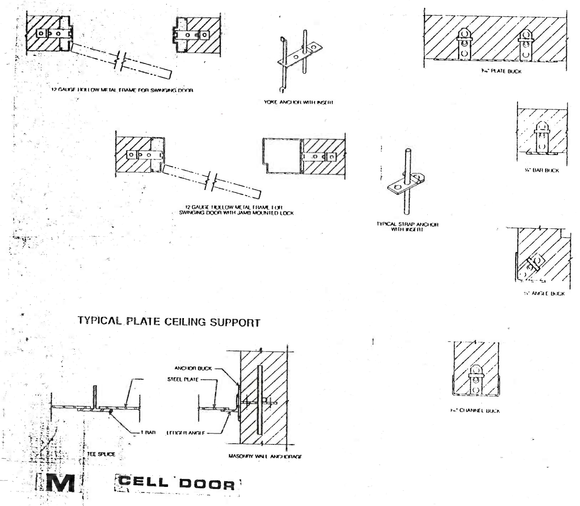

M CELL DOOR

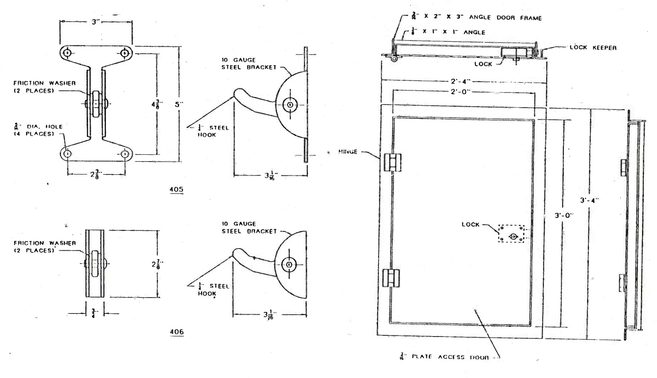


N HOOK


1. Detail N provide one (1) 406 hook and appropriate imbed plate at each cell in 8 cell blocks in medium and maximum security area and at 2 cell blocks in juvenile detention. Mount 4'-8" A.F.F.
2. Provide (2) two 406 hooks, detail N, at all showers in 8 cell blocks and 2 juvenile detention cell blocks and at all Huber toilet area showers. Provide required embed plates mount 4'-8" A.F.F.
3. Provide one (1) coat hook and shelf, detail G, for each bunk in Huber dormitory rooms. Provide appropriate embeds mount at 4'-8" A.F.F.

O ACCESS DOOR


Clarification: Detail O referred to on door schedule as H.S. frame is as shown in detail.

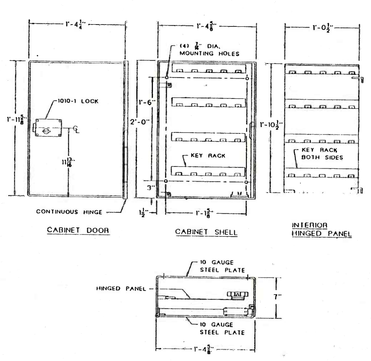


P KEY LOCKER

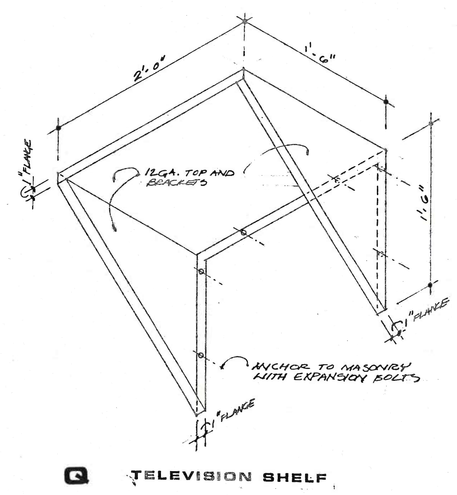

Q TELEVISION SHELF

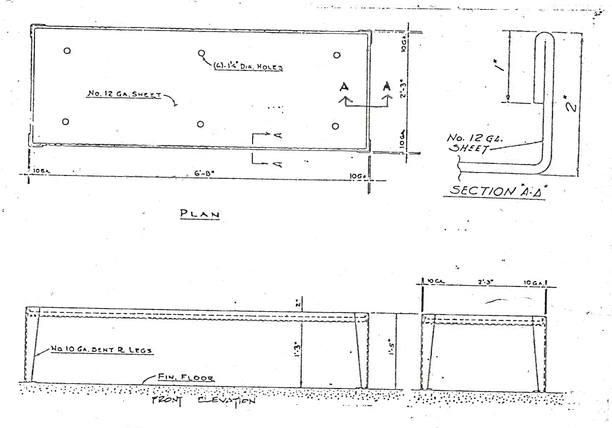


R STEEL COT

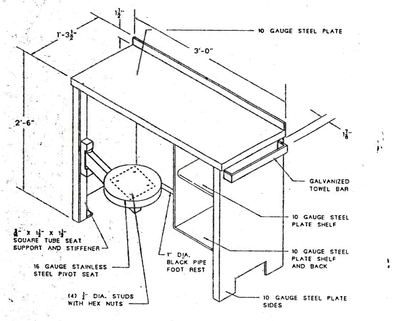

1. FIELD INSTALLED SEAT
2. ø 1" RAWL DRIVE ANCHORS INCLUDED
3. FINISH: FRAME PAINTED (SEAT - VES201)


S DESK

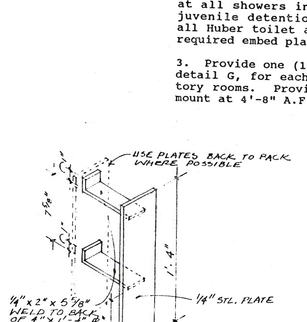


LIST OF CELLS TO RECIEVE IMBEDS FOR FUTURE UPPER BUNKS

* J106 THRU J115 (9)
J119 THRU J121 (3)
J125 & J126 (2)
J132 THRU J140 (8)
J206 THRU J215 (9)
J219 THRU J221 (3)
J225 & J226 (2)
* J232 THRU J240 (8)

* J106, J134, J136, J206, J234 & J236 HAVE 8" CMU. WALL AT BUNKS AND WILL REQUIRE 1/4"x 2"x 7 7/8" THRU WALL STRAPS

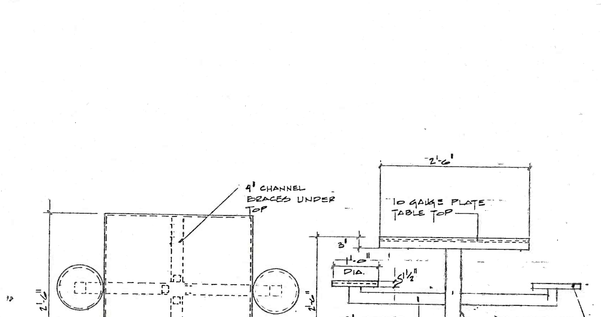


T DAY ROOM TABLE

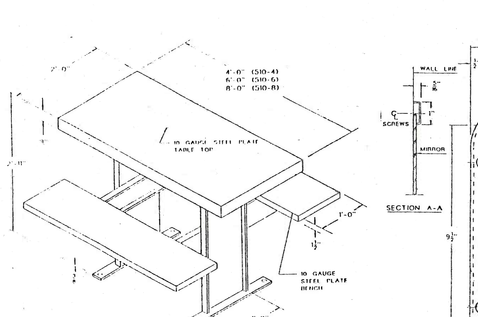

U TABLE


V MIRROR

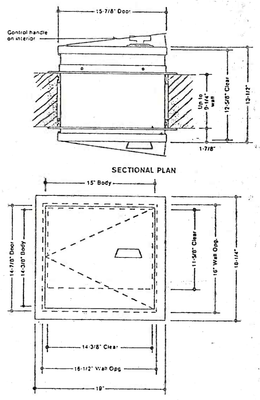

W PACKAGE PASS


1. FIELD INSTALLED SEAT
2. ø 1" RAWL DRIVE ANCHORS INCLUDED
3. FINISH: FRAME PAINTED - VES201


X STOOL

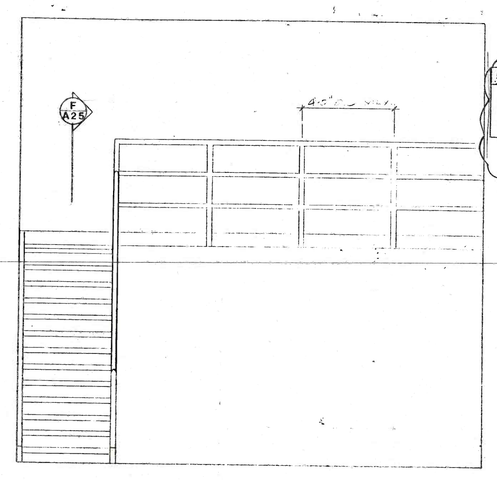

Y TYPICAL DAY ROOM STAIR AND RAILING
J141 SHOWN SCALE 3/8"-1'0"

REVISED BUNK DETAILS		10/24/90
KENTON PETERS - ASSOC. 44 E MIFFLIN MADISON, WISCONSIN (608) 255-5656 53703	PORTAGE COUNTY JAIL & SHERIFF'S DEPARTMENT STEVENS POINT, WISCONSIN	R15A

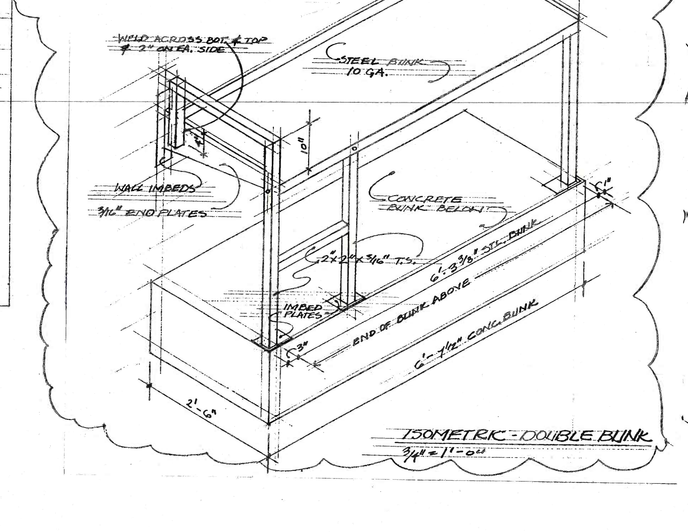

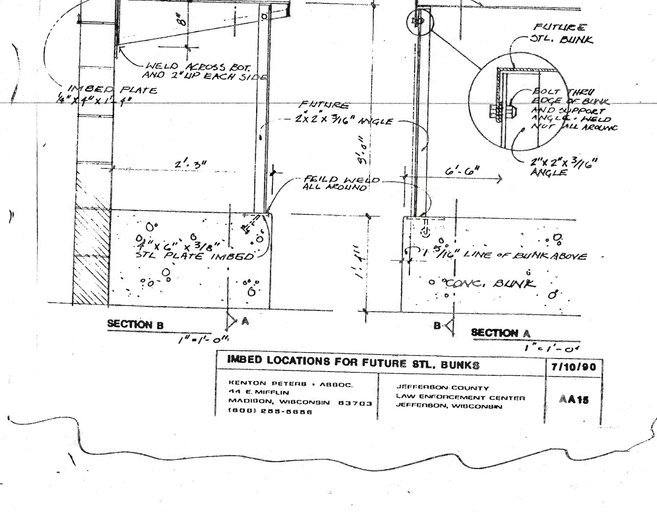

IMBED LOCATIONS FOR FUTURE STL. BUNKS		7/10/90
KENTON PETERS - ASSOC. 44 E MIFFLIN MADISON, WISCONSIN (608) 255-5656 53703	JEFFERSON COUNTY LAW ENFORCEMENT CENTER JEFFERSON, WISCONSIN	AA15

G15 VOID
G15A
SEE LEFT

AS BUILT
DEC 6, 1994

DATE	REVISION

STRUCTURAL CONSULTANT

MECHANICAL CONSULTANT

ARCHITECT
KENTON PETERS + ASSOC., INC.
44 E MIFFLIN
MADISON, WISCONSIN 53703
(608) 255-5656

JEFFERSON COUNTY
LAW ENFORCEMENT CENTER
JEFFERSON, WISCONSIN

DETENTION EQUIPMENT — 8-11-93

NOT TO SCALE — A32