

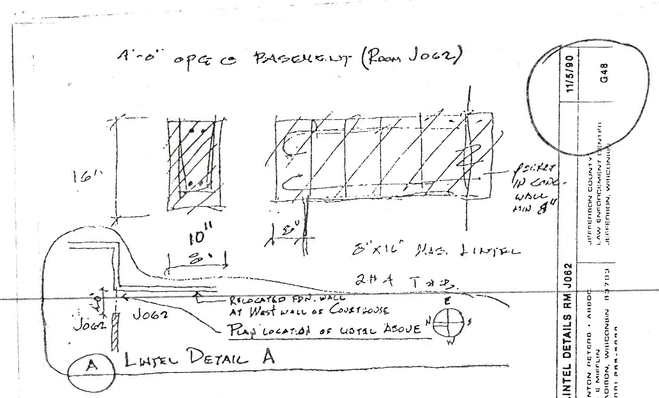


LINTEL DETAILS RM J062 — 11/5/90 — G48


JEFFERSON COUNTY LAW ENFORCEMENT CENTER JEFFERSON, WISCONSIN

KENTON PETERS + ASSOC. 44 E MIFFLIN MADISON, WISCONSIN 53703 (608) 255-5656

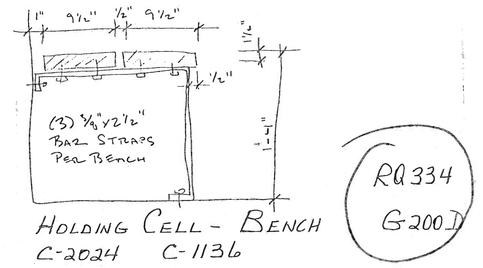


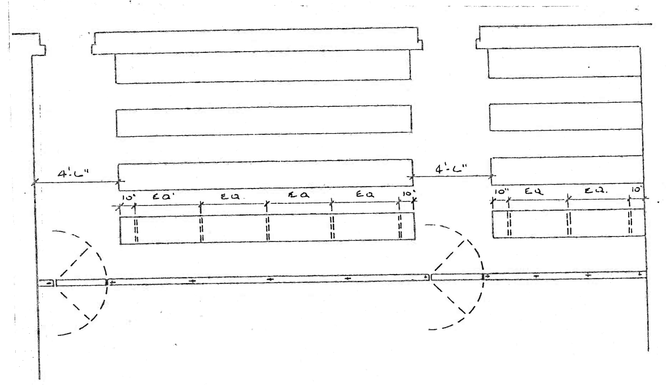


COURTROOM C1122 AUDIENCE PLAN		8/19/91
KENTON PETERS + ASSOC. 44 E MIFFLIN MADISON, WISCONSIN 53703 (608) 255-5656	JEFFERSON COUNTY LAW ENFORCEMENT CENTER JEFFERSON, WISCONSIN	G173

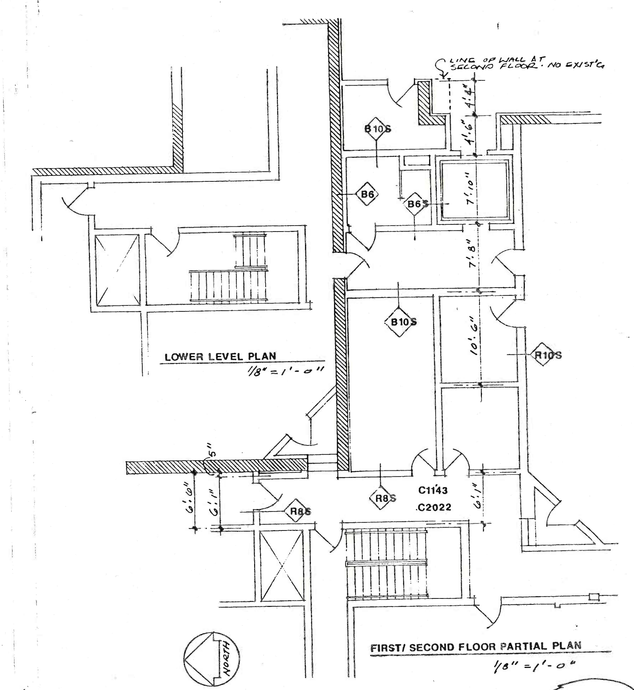

REVISED PLANS @ C1143 & C2022		11/17/90
KENTON PETERS + ASSOC. 44 E MIFFLIN MADISON, WISCONSIN 53703 (608) 255-5656	JEFFERSON COUNTY LAW ENFORCEMENT CENTER JEFFERSON, WISCONSIN	G67

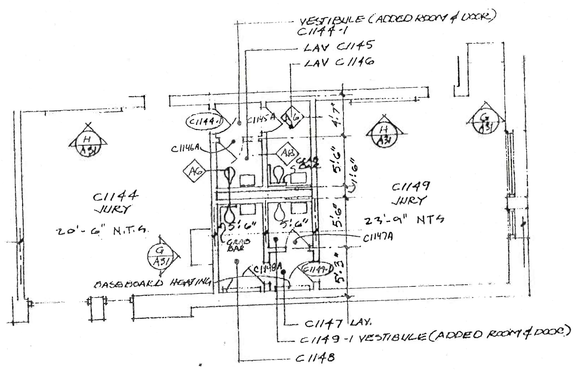


PARTIAL FIRST FLOOR PLAN		11/18/90

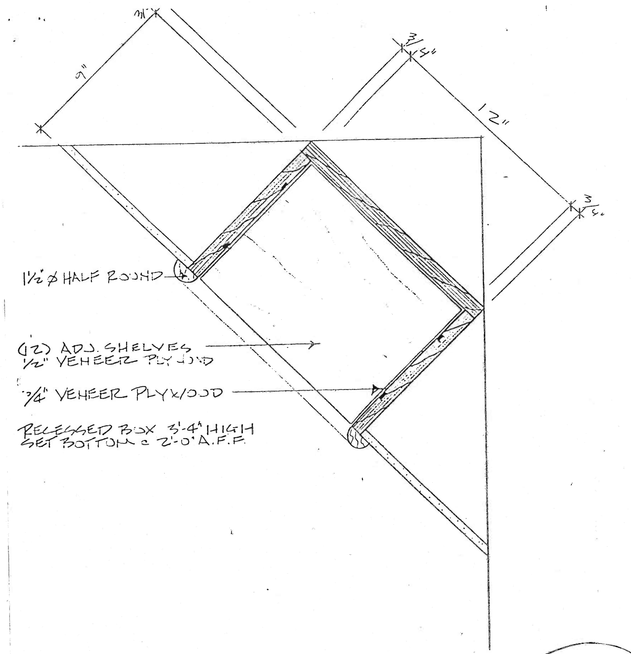

FORM RACK @ C1151-1 & 2014-1		8/19/90
KENTON PETERS + ASSOC. 44 E MIFFLIN MADISON, WISCONSIN 53703 (608) 255-5656	JEFFERSON COUNTY LAW ENFORCEMENT CENTER JEFFERSON, WISCONSIN	G188

RQ 311

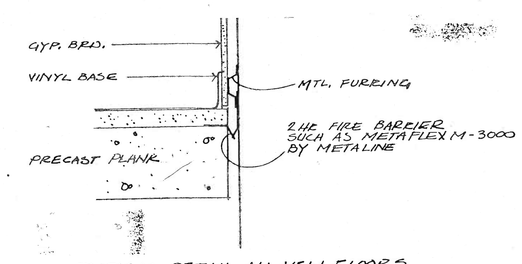

MICS. DETAILS		7/10/90
KENTON PETERS + ASSOC. 44 E MIFFLIN MADISON, WISCONSIN 53703 (608) 255-5656	JEFFERSON COUNTY LAW ENFORCEMENT CENTER JEFFERSON, WISCONSIN	A485

KENTON PETERS + ASSOCIATES, INC.
324 SOUTH HAMILTON STREET
MADISON, WI 53703
[608] 255-5656

A4 SUPPLEMENTARY DRAWINGS

AS BUILT
DEC 6, 1994