


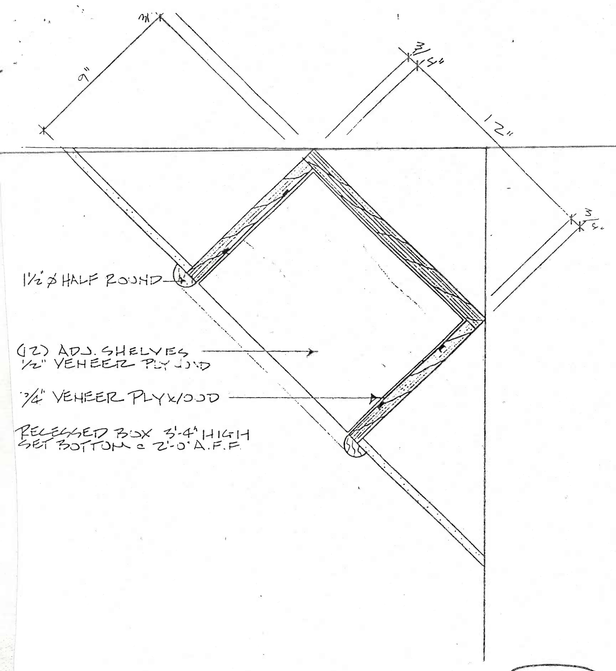


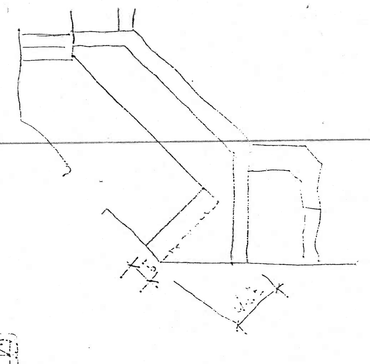

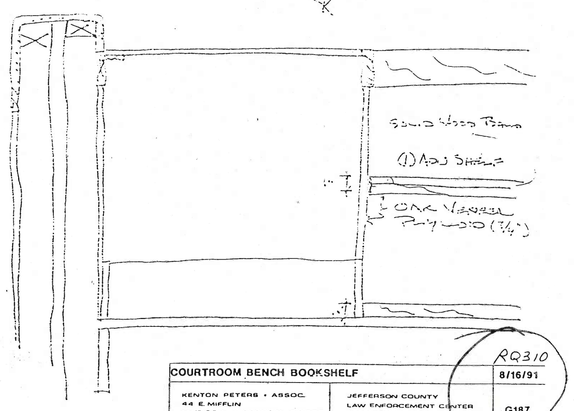


COURTROOM BENCH BOOKSHELF		RQ310 8/16/91
KENTON PETERS • ASSOC. 44 E MIFFLIN MADISON, WISCONSIN 53703 (608) 255-5858	JEFFERSON COUNTY LAW ENFORCEMENT CENTER JEFFERSON, WISCONSIN	G187


FORM RACK @ C1151-1 & 2014-1		RG311 8/19/90
KENTON PETERS • ASSOC. 44 E MIFFLIN MADISON, WISCONSIN 53703 (608) 255-5858	JEFFERSON COUNTY LAW ENFORCEMENT CENTER JEFFERSON, WISCONSIN	G188

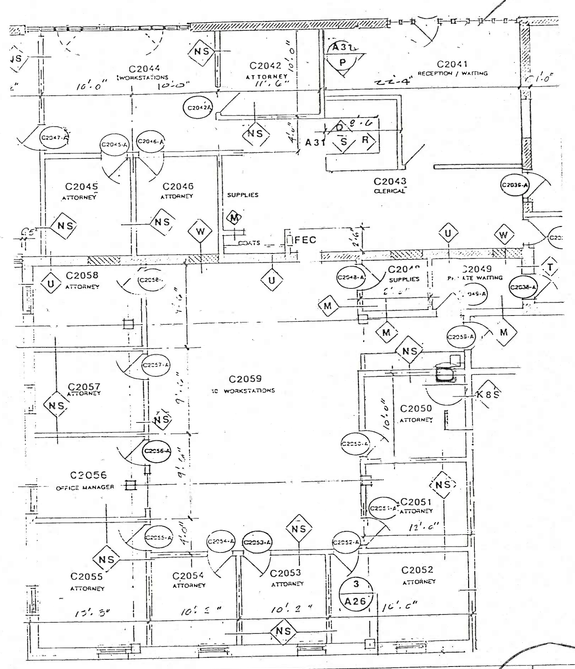


PLAN–DISTRICT ATTORNEY'S SUITE		3/9/91 A-5
KENTON PETERS • ASSOC. 44 E MIFFLIN MADISON, WISCONSIN 53703 (608) 255-5858	JEFFERSON COUNTY LAW ENFORCEMENT CENTER JEFFERSON, WISCONSIN	G134

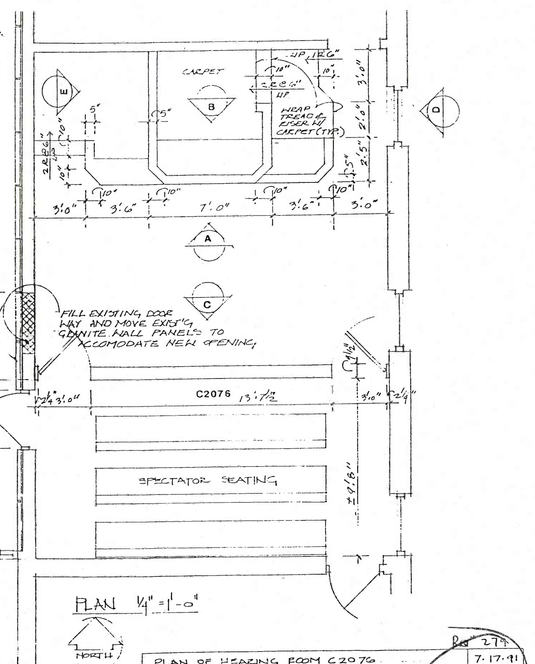

PLAN OF HEARING ROOM C2076		RQ 278 7-17-91
KENTON PETERS • ASSOC. 44 E MIFFLIN MADISON, WISCONSIN 53703 (608) 255-5858	JEFFERSON COUNTY LAW ENFORCEMENT CENTER JEFFERSON, WISCONSIN	G179

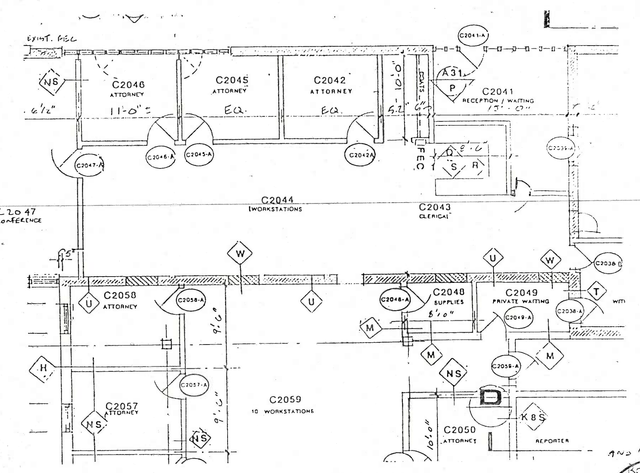


DISTRICT ATTORNEY SUITE REVISIONS		RQ 378 9/23/91
KENTON PETERS • ASSOC. 44 E MIFFLIN MADISON, WISCONSIN 53703 (608) 255-5858	JEFFERSON COUNTY LAW ENFORCEMENT CENTER JEFFERSON, WISCONSIN	G196

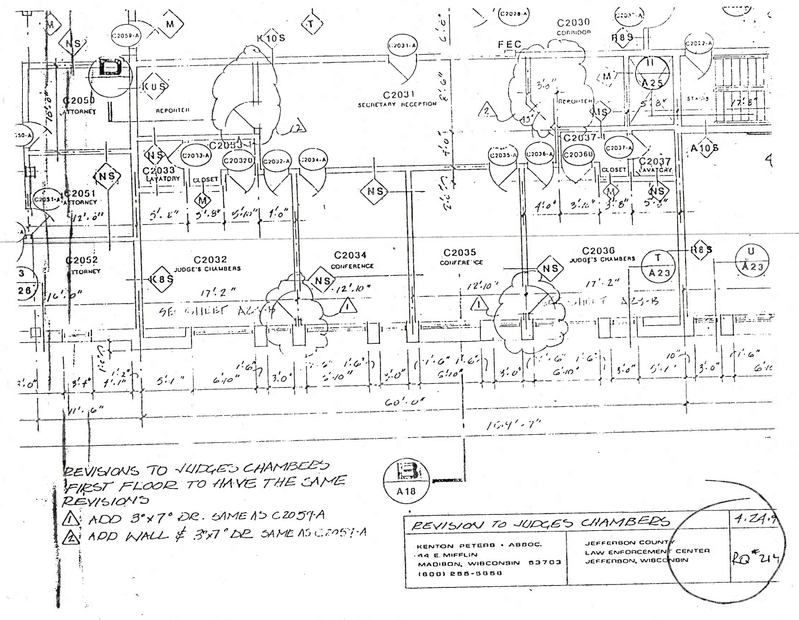


REVISIONS TO JUDGES CHAMBERS FIRST FLOOR TO HAVE THE SAME REVISIONS
1. ADD 8'x7' DR. SAME AS C2059A
2. ADD WALL & 3'-7" DR. SAME AS C2059-A


REVISION TO JUDGES CHAMBERS		7-24-91 RQ "242"
KENTON PETERS • ASSOC. 44 E MIFFLIN MADISON, WISCONSIN 53703 (608) 255-5858	JEFFERSON COUNTY LAW ENFORCEMENT CENTER JEFFERSON, WISCONSIN	

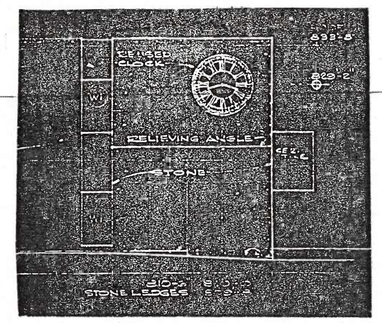

NORTH ELEVATION: EXISTING COURTHOUSE CANOPY.

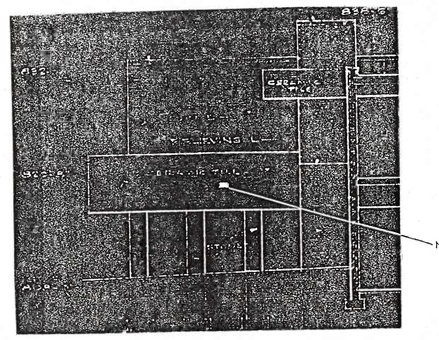


SOUTH ELEVATION: EXISTING COURTHOUSE CANOPY.

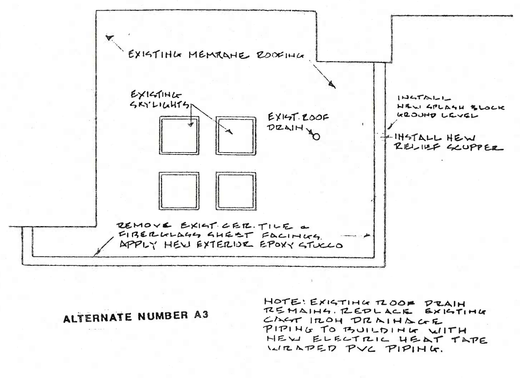


ALTERNATE NUMBER A3

NOTE: EXISTING FLOOR DRAIN TO REMAIN. REPLACE EXISTING CAST IRON DRAINAGE PIPING TO BUILDING WITH NEW ELECTRIC HEAT TAPE WRAPPED PVC PIPING.


PLAN: EXISTING COURTHOUSE CANOPY

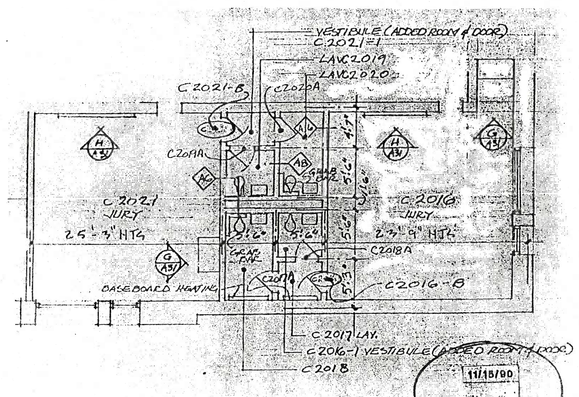

A3 PARTIAL SECOND FLOOR PLAN (G30) 1/8" = 1'-0"		11/15/90
		G66

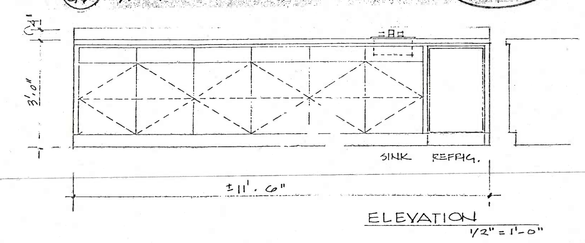


ELEVATION 1/2" = 1'-0"

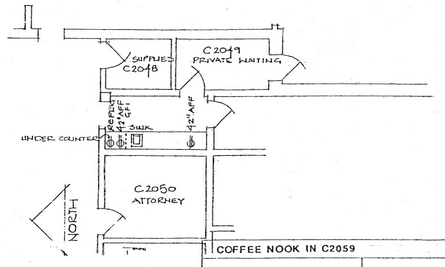


COFFEE NOOK IN C2059		RQ "202" 4/2/91 A-5
KENTON PETERS • ASSOC. 44 E MIFFLIN MADISON, WISCONSIN	JEFFERSON COUNTY LAW ENFORCEMENT CENTER	

PLAN

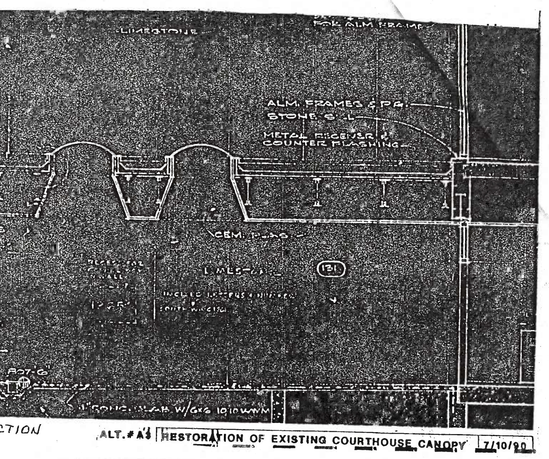

EAST / WEST SECTION


ALT. # A3 RESTORATION OF EXISTING COURTHOUSE CANOPY 7/10/90

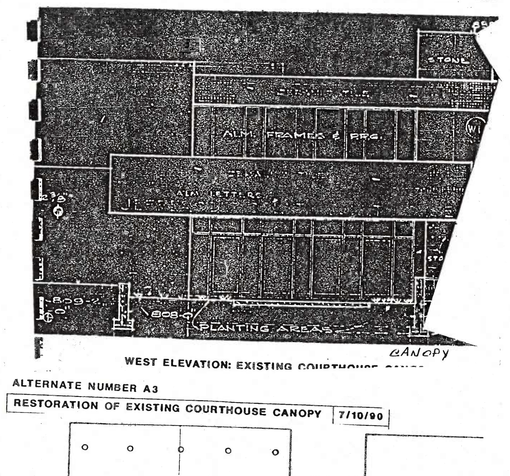


WEST ELEVATION: EXISTING COURTHOUSE CANOPY

ALTERNATE NUMBER A3

RESTORATION OF EXISTING COURTHOUSE CANOPY 7/10/90

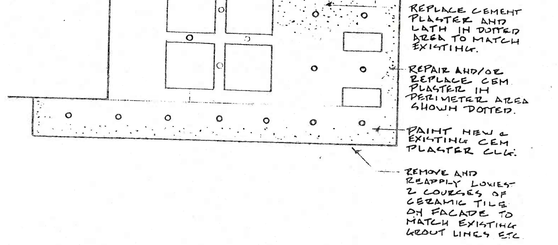

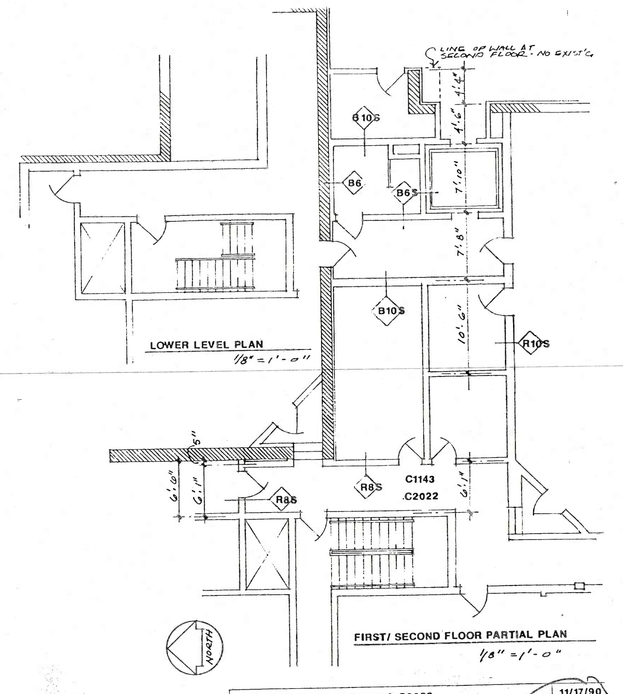

LOWER LEVEL PLAN 1/8" = 1'-0"

FIRST/ SECOND FLOOR PARTIAL PLAN 1/8" = 1'-0"

REVISED PLANS @ C1143 & C2022		11/17/90
KENTON PETERS • ASSOC. 44 E MIFFLIN MADISON, WISCONSIN 53703 (608) 255-5858	JEFFERSON COUNTY LAW ENFORCEMENT CENTER JEFFERSON, WISCONSIN	G67

AS BUILT
DEC 6, 1994

KENTON PETERS + ASSOCIATES, INC.
44 EAST MIFFLIN STREET
MADISON, WI 53703
(608) 255-5858

A5 SUPPLEMENTARY DRAWINGS