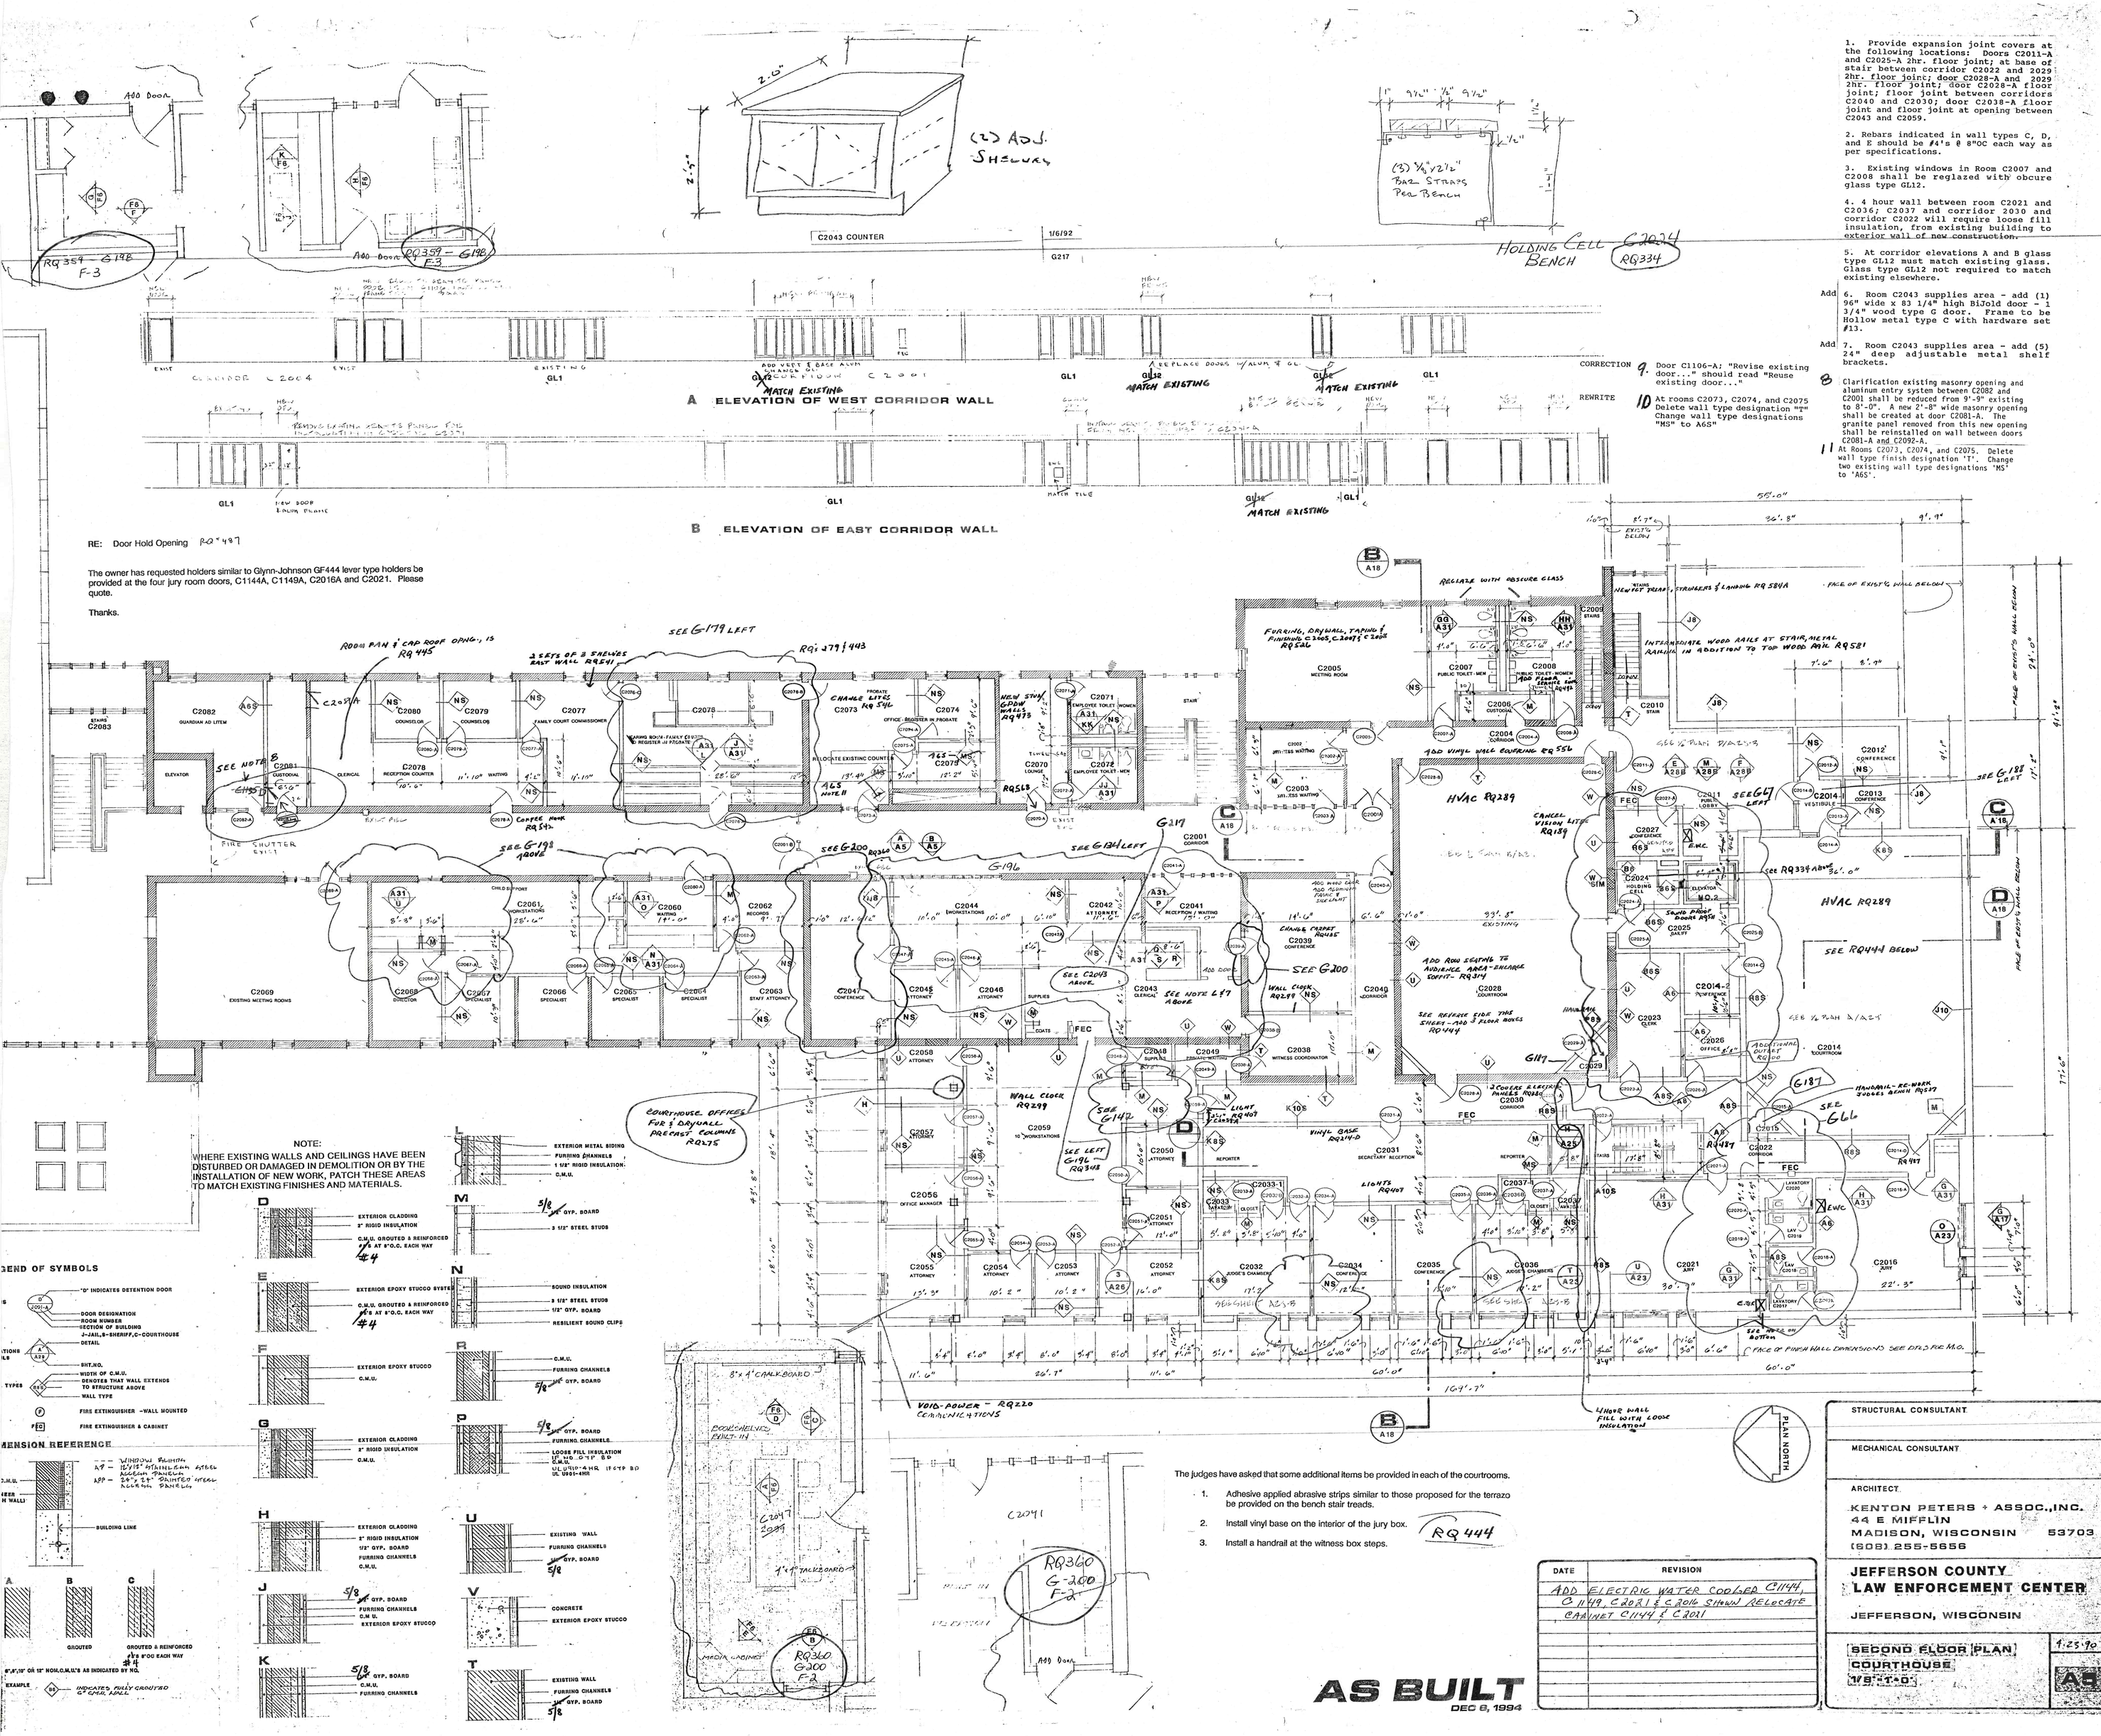


1. Provide expansion joint covers at the following locations: Doors C2011-A and C2025-A 2hr. floor joint; at base of stair between corridor C2022 and 2029 2hr. floor joint; door C2028-A and 2029 2hr. floor joint; door C2028-A floor joint; floor joint between corridors C2040 and C2030; door C2038-A floor joint and floor joint at opening between C2043 and C2059.

2. Rebars indicated in wall types C, D, and E should be #4's @ 8"OC each way as per specifications.

3. Existing windows in Room C2007 and C2008 shall be reglazed with obcure glass type GL12.

4. 4 hour wall between room C2021 and C2036; C2037 and corridor 2030 and corridor C2022 will require loose fill insulation, from existing building to exterior wall of new construction.

5. At corridor elevations A and B glass type GL12 must match existing glass. Glass type GL12 not required to match existing elsewhere.

Add 6. Room C2043 supplies area - add (1) 96" wide x 83 1/4" high BiJold door - 1 3/4" wood type G door. Frame to be Hollow metal type C with hardware set #13.

Add 7. Room C2043 supplies area - add (5) 24" deep adjustable metal shelf brackets.

8 Clarification existing masonry opening and aluminum entry system between C2082 and C2001 shall be reduced from 9'-9" existing to 8'-0". A new 2'-8" wide masonry opening shall be created at door C2081-A. The granite panel removed from this new opening shall be reinstalled on wall between doors C2081-A and C2092-A.

11 At Rooms C2073, C2074, and C2075. Delete wall type finish designation 'T'. Change two existing wall type designations 'MS' to 'A6S'.

CORRECTION 9. Door C1106-A; "Revise existing door..." should read "Reuse existing door..."

REWRITE 10 At rooms C2073, C2074, and C2075 Delete wall type designation "T" Change wall type designations "MS" to A6S"

RE: Door Hold Opening RQ 497

The owner has requested holders similar to Glynn-Johnson GF444 lever type holders be provided at the four jury room doors, C1144A, C1149A, C2016A and C2021. Please quote.

Thanks.

NOTE:
WHERE EXISTING WALLS AND CEILINGS HAVE BEEN DISTURBED OR DAMAGED IN DEMOLITION OR BY THE INSTALLATION OF NEW WORK, PATCH THESE AREAS TO MATCH EXISTING FINISHES AND MATERIALS.

END OF SYMBOLS

"D" INDICATES DETENTION DOOR
DOOR DESIGNATION
ROOM NUMBER
SECTION OF BUILDING
J-JAIL, S-SHERIFF, C-COURTHOUSE
DETAIL
SHT.NO.
WIDTH OF C.M.U.
DENOTES THAT WALL EXTENDS TO STRUCTURE ABOVE
WALL TYPE
FIRE EXTINGUISHER -WALL MOUNTED
FIRE EXTINGUISHER & CABINET

DIMENSION REFERENCE

WINDOW SCHEDULE
AP - 16'x12' STAINLESS STEEL ACCESS PANELS
APP - 24"x 24" PAINTED STEEL ACCESS PANELS
BUILDING LINE
A B C
GROUTED
GROUTED & REINFORCED #4 @ 8'OC EACH WAY
8",4",10" OR 12" NOM.C.M.U.'S AS INDICATED BY NO.
EXAMPLE — INDICATES FULLY GROUTED 8" CMU WALL

D EXTERIOR CLADDING; 2" RIGID INSULATION; C.M.U. GROUTED & REINFORCED #4 AT 8"O.C. EACH WAY
E EXTERIOR EPOXY STUCCO SYSTEM; C.M.U. GROUTED & REINFORCED #4 AT 8"O.C. EACH WAY
F EXTERIOR EPOXY STUCCO; C.M.U.
G EXTERIOR CLADDING; 2" RIGID INSULATION; C.M.U.
H EXTERIOR CLADDING; 2" RIGID INSULATION; 1/2" GYP. BOARD; FURRING CHANNELS; C.M.U.
J 5/8" GYP. BOARD; FURRING CHANNELS; C.M.U.; EXTERIOR EPOXY STUCCO
K 5/8" GYP. BOARD; C.M.U.; FURRING CHANNELS
L EXTERIOR METAL SIDING; FURRING CHANNELS; 1 1/2" RIGID INSULATION; C.M.U.
M 5/8" GYP. BOARD; 3 1/2" STEEL STUDS
N SOUND INSULATION; 3 1/2" STEEL STUDS; 1/2" GYP. BOARD; RESILIENT SOUND CLIPS
R C.M.U.; FURRING CHANNELS; 5/8" GYP. BOARD
P 5/8" GYP. BOARD; FURRING CHANNELS; LOOSE FILL INSULATION UL NO. G-15, B-9 U.L. NO. U419-4HR 1 GYP BD UL U901-4HR
U EXISTING WALL; FURRING CHANNELS; 5/8" GYP. BOARD
V CONCRETE; EXTERIOR EPOXY STUCCO
T EXISTING WALL; FURRING CHANNELS; 5/8" GYP. BOARD

The judges have asked that some additional items be provided in each of the courtrooms.

1. Adhesive applied abrasive strips similar to those proposed for the terrazo be provided on the bench stair treads.
2. Install vinyl base on the interior of the jury box. RQ 444
3. Install a handrail at the witness box steps.

AS BUILT
DEC 8, 1994

DATE	REVISION
	ADD ELECTRIC WATER COOLER C1144, C1149, C2021 & C2016 SHOWN RELOCATE CABINET C1144 & C2021

STRUCTURAL CONSULTANT

MECHANICAL CONSULTANT

ARCHITECT
KENTON PETERS + ASSOC., INC.
44 E MIFFLIN
MADISON, WISCONSIN 53703
(608) 255-5656

JEFFERSON COUNTY
LAW ENFORCEMENT CENTER
JEFFERSON, WISCONSIN

SECOND FLOOR PLAN
COURTHOUSE
1/8"=1'-0"

1-25-90
A8