

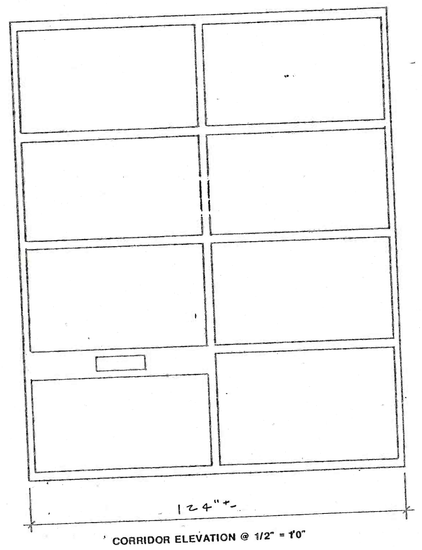


CORRIDOR ELEVATION @ 1/2" = 1'0"

DAYROOM J100 FRONT		3/14/91
KENTON PETERS + ASSOC. 44 E. MIFFLIN MADISON, WISCONSIN 53703 (608) 255-5656	JEFFERSON COUNTY LAW ENFORCEMENT CENTER JEFFERSON, WISCONSIN	G138

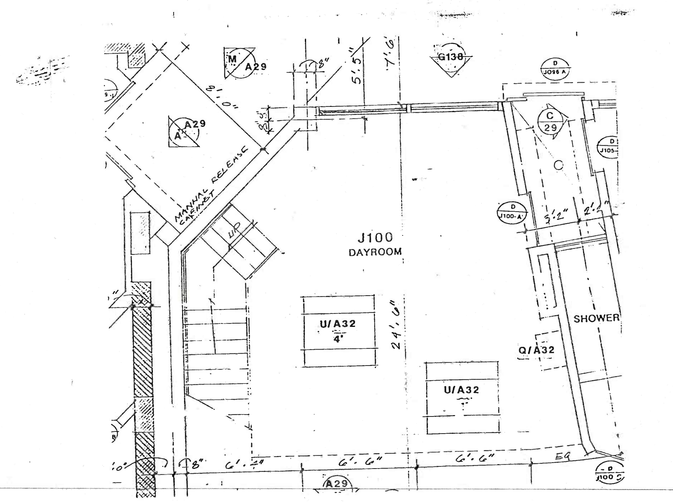

PLAN @ 1/4" = 1'0"

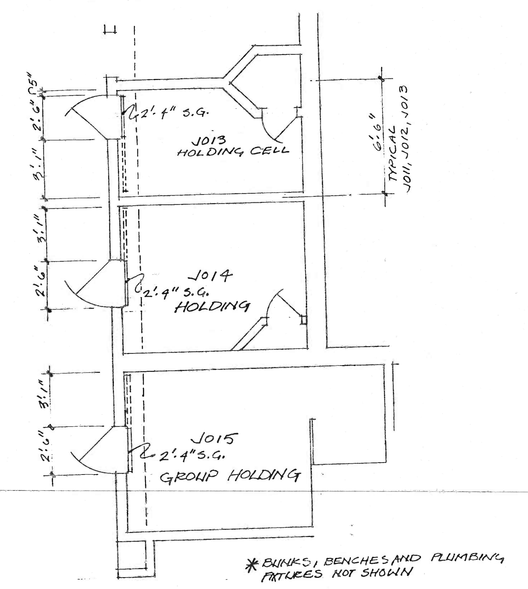

* BUNKS, BENCHES AND PLUMBING FIXTURES NOT SHOWN

PLAN OF HOLDING CELLS SHOWING MINIMUM DIMENSIONS FOR DOOR TRAVEL

1/4"=1'-0"

DAYROOM J100 FRONT		3/14/91
KENTON PETERS + ASSOC. 44 E. MIFFLIN MADISON, WISCONSIN 53703 (608) 255-5656	JEFFERSON COUNTY LAW ENFORCEMENT CENTER JEFFERSON, WISCONSIN	A-4 G137

PLAN OF HOLDING CELLS		10/24/90
KENTON PETERS + ASSOC. 44 E. MIFFLIN MADISON, WISCONSIN 53703 (608) 255-5656	JEFFERSON COUNTY LAW ENFORCEMENT CENTER JEFFERSON, WISCONSIN	G28

AS BUILT
DEC 6, 1994

KENTON PETERS + ASSOCIATES, INC. 324 SOUTH HAMILTON STREET MADISON, WI 53703 (608) 255-5656	A6 SUPPLEMENTARY DRAWINGS