LEGEND OF SYMBOLS

DOORS — "D" INDICATES DETENTION DOOR; DOOR DESIGNATION; ROOM NUMBER; SECTION OF BUILDING J=JAIL, S=SHERIFF, C=COURTHOUSE; DETAIL


ELEVATIONS DETAILS — SHT. NO.

WALL TYPES — WIDTH OF C.M.U.; DENOTES THAT WALL EXTENDS TO STRUCTURE ABOVE; WALL TYPE

(F) FIRE EXTINGUISHER - WALL MOUNTED

FC FIRE EXTINGUISHER & CABINET


DIMENSION REFERENCE

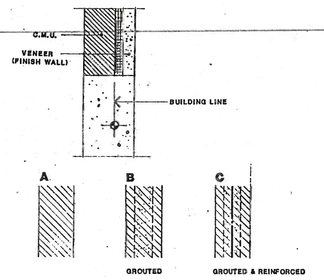


8",6",10" OR 12" NOM.C.M.U.'S AS INDICATED BY NO.


EXAMPLE 88 — INDICATES FULLY GROUTED 6" CMU. WALL

CONTINUED BELOW

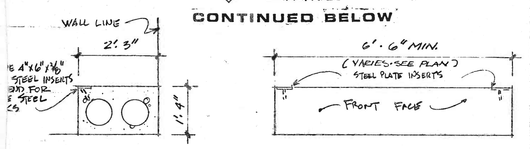


B TYPICAL CONCRETE BUNK DETAIL
1/2"=1'-0"

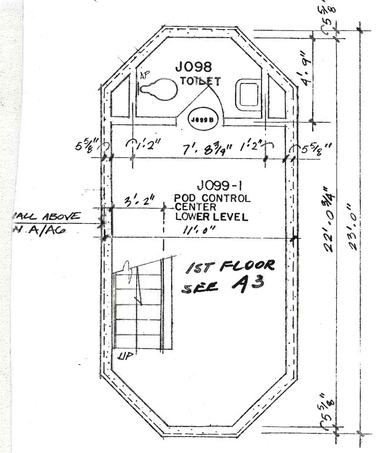


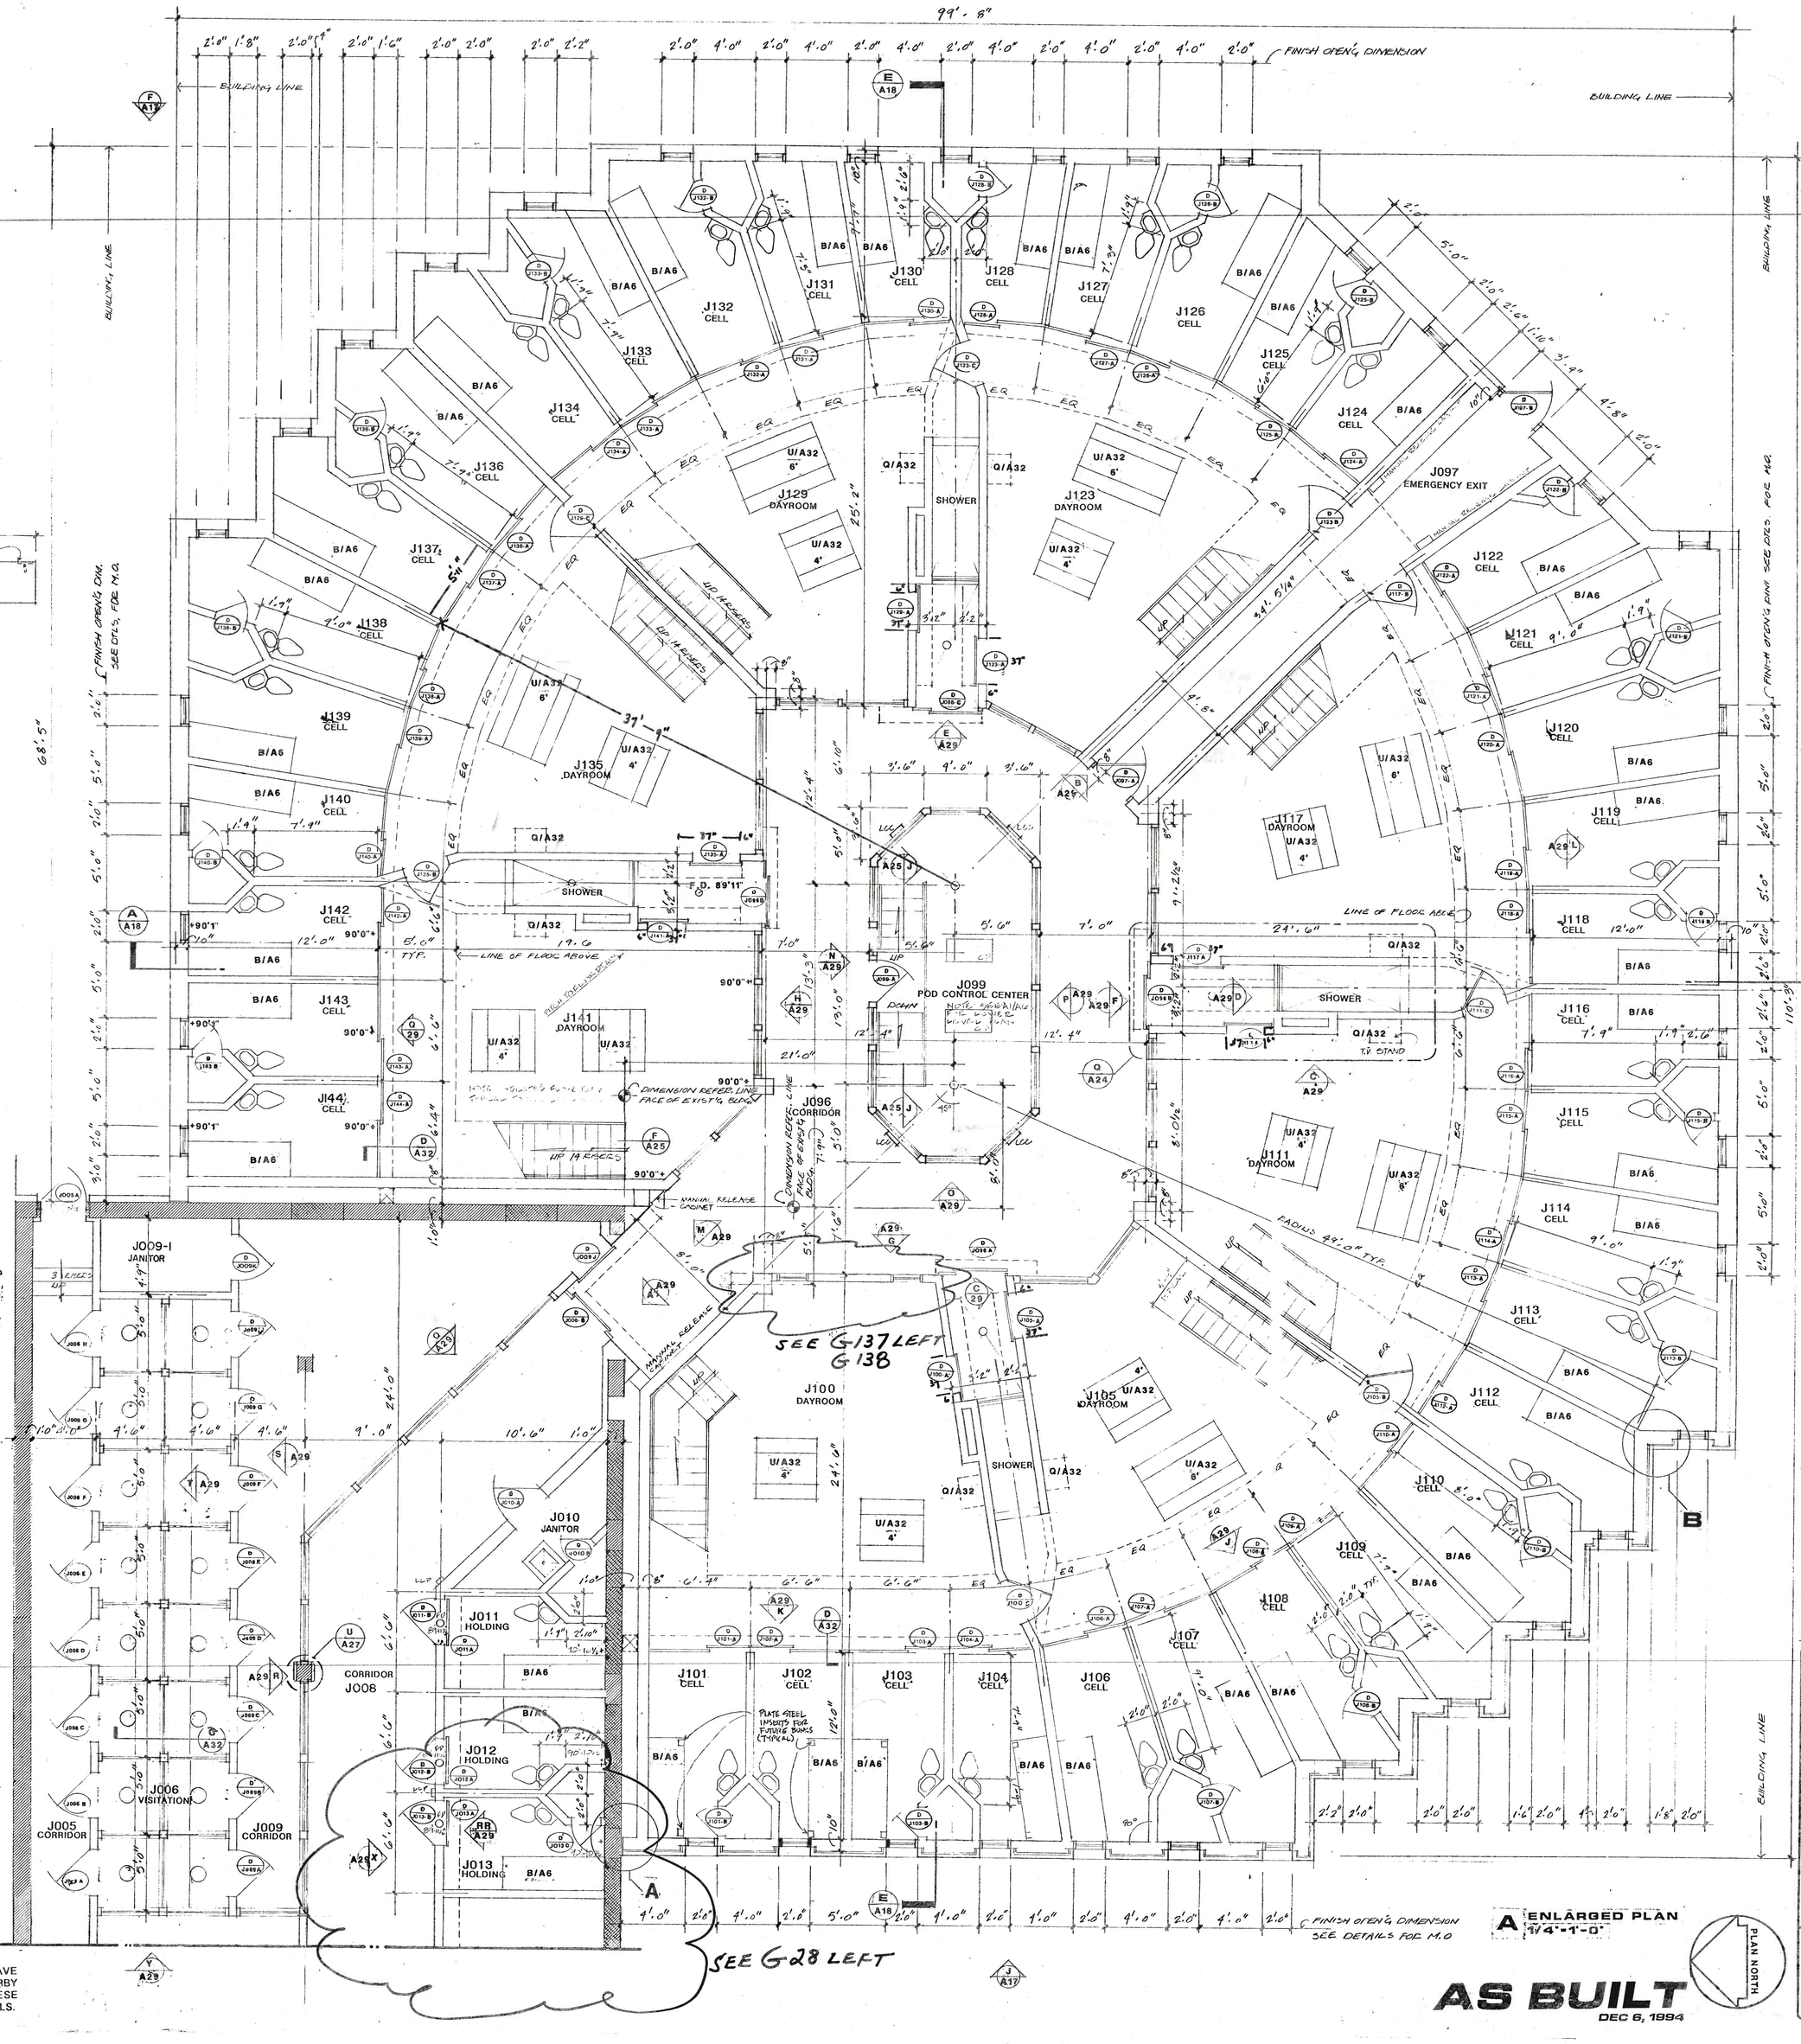

A ENLARGED PLAN
1/4"=1'-0"

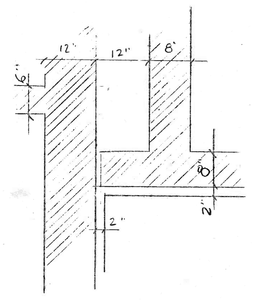

A CORNER DETAIL
3/4"=1'-0"

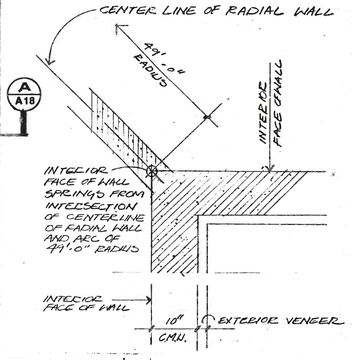


B LAYOUT OF STEPPED WALL 3/4"=1'-0"

Add at two 45 degree hollow metal window frames provide formed metal piping enclosures floor to ceiling. Closure to be 12 gauge metal "U" shaped approximately 4" wide by 4" deep. Enclosures to attach to metal window frames and masonry walls with snap clip attachments.

* 1/4" pod plan shows ground floor only. First floor see sheet A3. Cells layouts are the same both floors.

A1 PLAN OF AREA BELOW CONTROL POD
1/4"=1'-0"

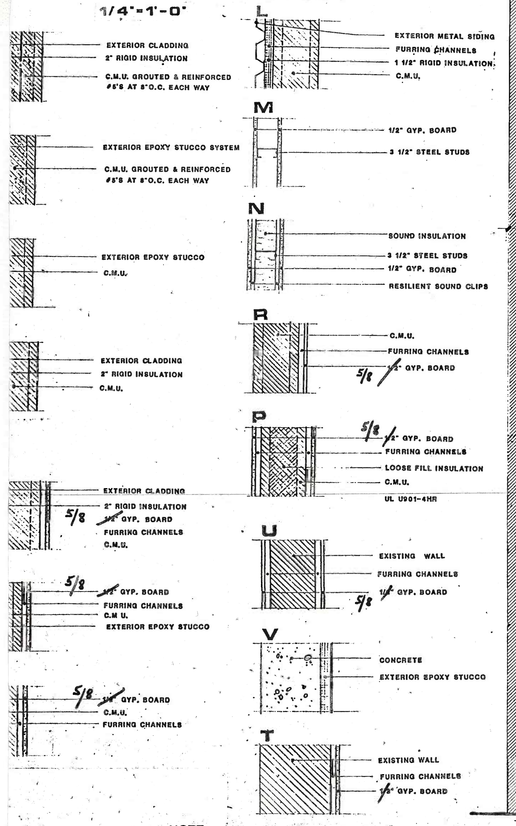

NOTE:
WHERE EXISTING WALL, FLOORS, OR CEILINGS HAVE BEEN DISTURBED OR DAMAGED IN DEMOLITION ORBY THE INSTALLATION OF NEW WORK, PATCH THESE AREAS TO MATCH EXISTING FINISHES AND MATERIALS.

AS BUILT
DEC 6, 1994

DATE	REVISION

STRUCTURAL CONSULTANT

MECHANICAL CONSULTANT

ARCHITECT
KENTON PETERS + ASSOC., INC.
44 E MIFFLIN
MADISON, WISCONSIN 53703
(608) 255-5656

JEFFERSON COUNTY LAW ENFORCEMENT CENTER

JEFFERSON, WISCONSIN

ENLARGE PLAN 'A'

1/4"=1'-0"

5-11-94

A6