
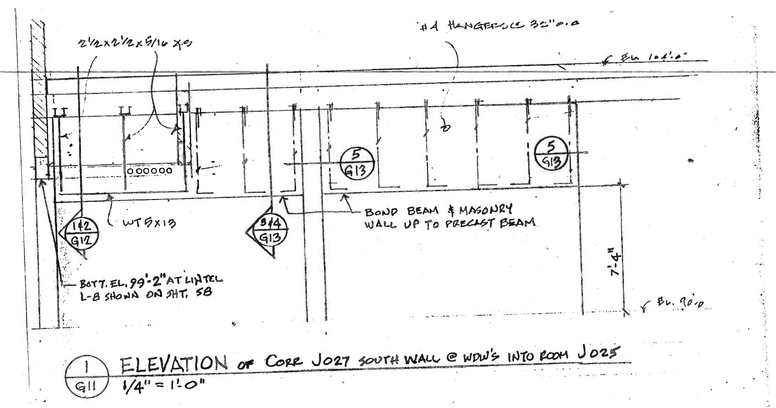


1/G11 ELEVATION OF CORE J027 SOUTH WALL @ WDW'S INTO ROOM J025
1/4" = 1'-0"


J027 SALLY PORT SUSPENDED BOND BEAM		10/29/90
KENTON PETERS + ASSOC. 44 E. MIFFLIN MADISON, WISCONSIN 53703 (608) 255-5656	JEFFERSON COUNTY LAW ENFORCEMENT CENTER JEFFERSON, WISCONSIN	G42

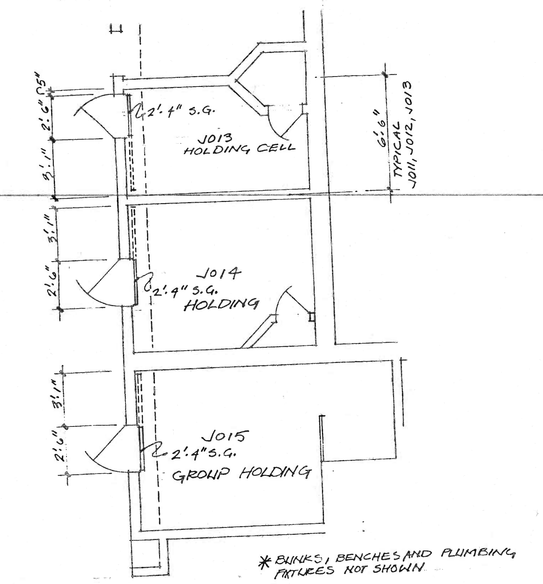

PLAN OF HOLDING CELLS SHOWING MINIMUM DIMENSIONS FOR DOOR TRAVEL

1/G11 1/4"=1'-0"

PLAN OF HOLDING CELLS		10/24/90
KENTON PETERS + ASSOC. 44 E. MIFFLIN MADISON, WISCONSIN 53703 (608) 255-5656	JEFFERSON COUNTY LAW ENFORCEMENT CENTER JEFFERSON, WISCONSIN	G28

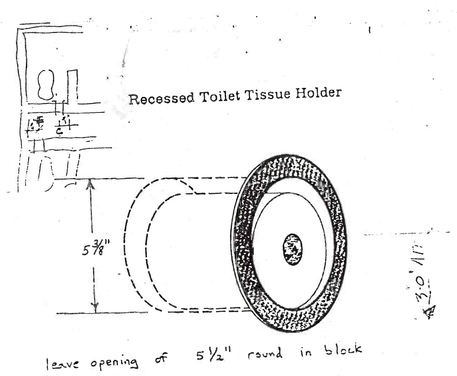


leave opening of 5½" round in block


Model No. TH-10:R-S

The recessed tissue holder is fabricated from 16 gauge stainless steel. Unit is approximately 4-3/4 inches deep with an inside diameter of 3 inches. Surface flange diameter is approximately 7-1/4 inches. Twin threaded studs are securely welded to back side of unit. A 1/4 inch thick mild steel flat bar securely anchors tissue holder in place. Anchorage is accessible only from the utility area.

Refer to the specifications at the end of this section for detailed information.

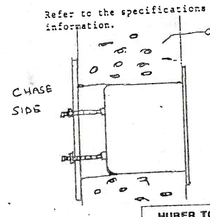


HUBER TOILET TISSUE HOLDER		12/13/90
KENTON PETERS + ASSOC. 44 E. MIFFLIN MADISON, WISCONSIN 53703 (608) 255-5656	JEFFERSON COUNTY LAW ENFORCEMENT CENTER JEFFERSON, WISCONSIN	G78

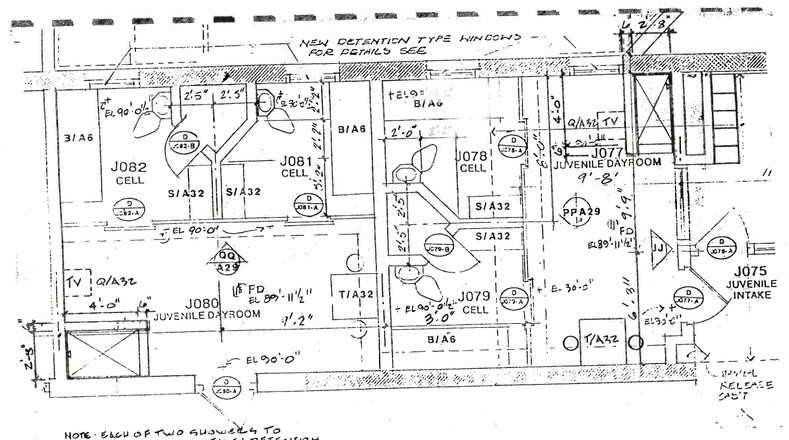


NOTE: ELEV OF TWO SHOWERS TO HAVE 6"x6" CERAMIC TILE WITH 4" DRAIN AND 4 COURSES 16"x8" GLAZED CMU ENCLOSURE 8'-0" HIGH GLAZED CMU CLOSURES TO G-9/A24 FOR CONSTRUCTION DETAILS

REVISE J077 AND J080 JUVENILE DETENTION DAYROOMS, TO INCLUDE SHOWER STALLS

SHOWER STALLS IN J077 AND J080		7/10/90
KENTON PETERS + ASSOC. 44 E. MIFFLIN MADISON, WISCONSIN 53703 (608) 255-5656	JEFFERSON COUNTY LAW ENFORCEMENT CENTER JEFFERSON, WISCONSIN	AA93

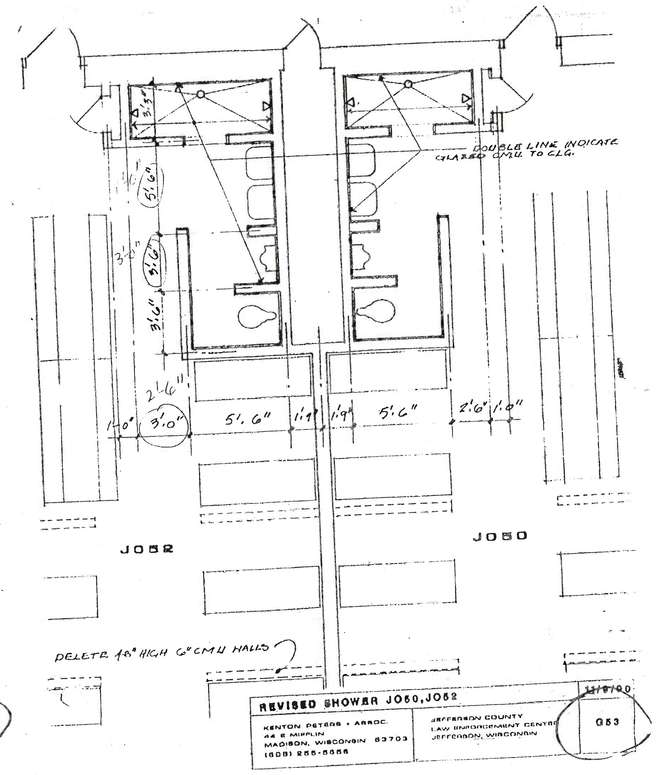


REVISED SHOWER J050,J052		11/9/90
KENTON PETERS + ASSOC. 44 E. MIFFLIN MADISON, WISCONSIN 53703 (608) 255-5656	JEFFERSON COUNTY LAW ENFORCEMENT CENTER JEFFERSON, WISCONSIN	G53

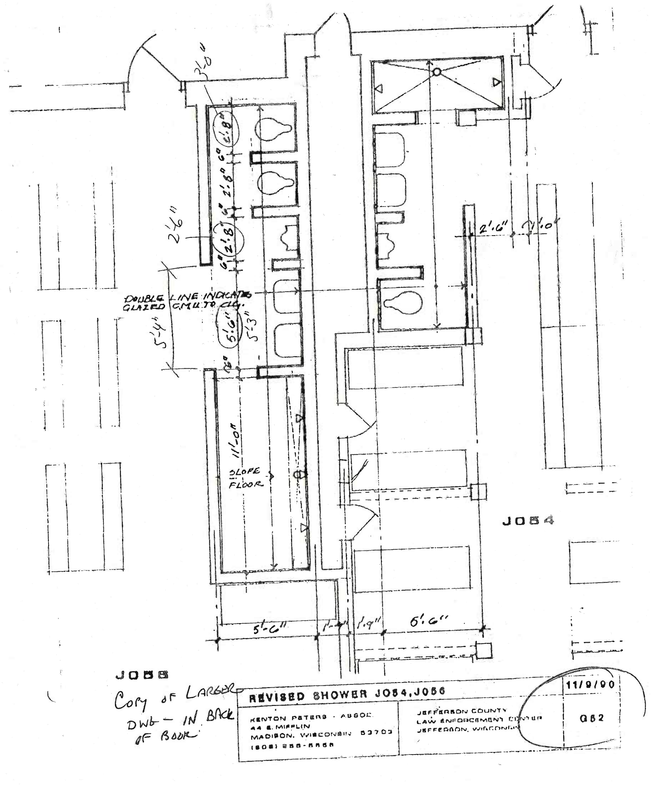


J055 Copy of Larger DWG — IN BACK OF BOOK

REVISED SHOWER J054,J056		11/9/90
KENTON PETERS + ASSOC. 44 E. MIFFLIN MADISON, WISCONSIN 53703 (608) 255-5656	JEFFERSON COUNTY LAW ENFORCEMENT CENTER JEFFERSON, WISCONSIN	G52

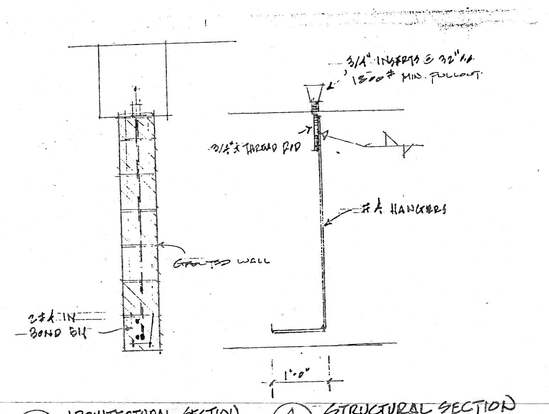


3/G13 ARCHITECTURAL SECTION 3/4" = 1'-0"

4/G13 STRUCTURAL SECTION 3/4" = 1'-0"

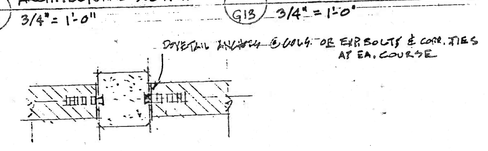


5/G13 PLAN DETAIL @ PRECAST 3/4" = 1'-0"

SALLY PORT SUSPENDED BOND BEAM DETAILS		10/29/90
KENTON PETERS + ASSOC. 44 E. MIFFLIN MADISON, WISCONSIN 53703 (608) 255-5656	JEFFERSON COUNTY LAW ENFORCEMENT CENTER JEFFERSON, WISCONSIN	G44

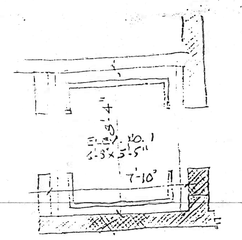

9-13-90 G8

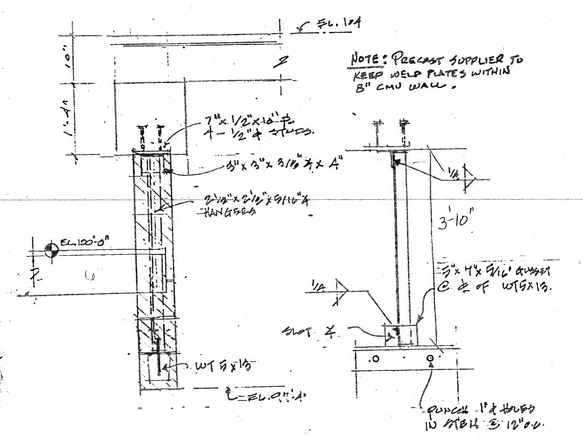

1/G12 ARCHITECTURAL SECTION 3/4" = 1'-0"

2/G12 STRUCT. SECTION 3/4" = 1'-0"

SALLY PORT SUSPENDED BOND BEAM AT STAIR ROOM SIDES-1 10-29-90

G-43

KENTON PETERS + ASSOCIATES, INC.
324 SOUTH HAMILTON STREET
MADISON, WI 53703
[608] 255-5656

A7 SUPPLEMENTARY DRAWINGS

AS BUILT
DEC 6, 1994