




**AA** PUBLIC TOILET -MEN C1131

**BB** PUBLIC TOILET -WOMEN C1132

| ELEVATIONS C1131 & C1132 | | 9/10/93 |
|---|---|---|
| KENTON PETERS + ASSOC.<br>44 E.MIFFLIN<br>MADISON, WISCONSIN 53703<br>(608) 255-5858 | JEFFERSON COUNTY<br>LAW ENFORCEMENT CENTER<br>JEFFERSON, WISCONSIN | AA46 |

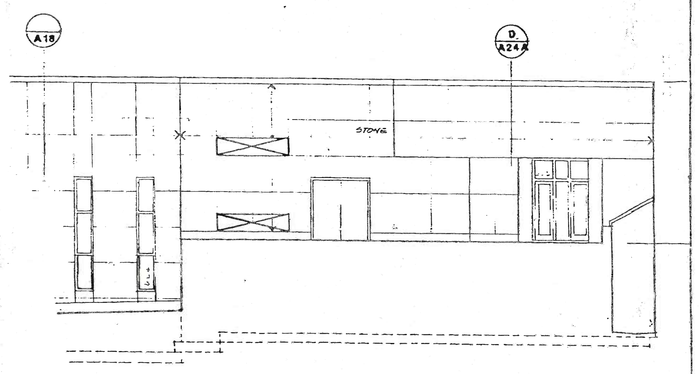


| LOUVER LOCATON @ S1007 | | 6/3/91 |
|---|---|---|
| KENTON PETERS + ASSOC.<br>44 E.MIFFLIN<br>MADISON, WISCONSIN 53703<br>(608) 255-5858 | JEFFERSON COUNTY<br>LAW ENFORCEMENT CENTER<br>JEFFERSON, WISCONSIN | G161 |

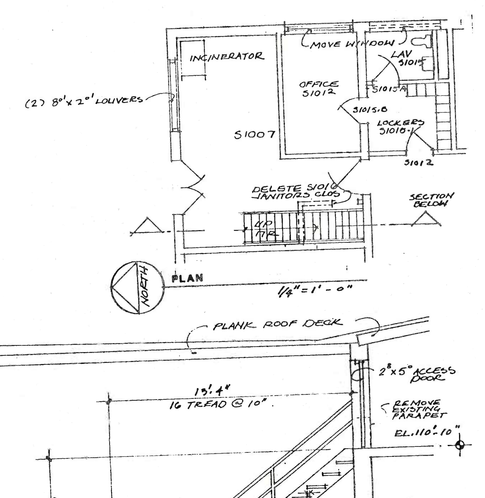


SEE: BUILDING SECTION 9/A19 - REPLACES STL. ACCESS LADDER AND JANITORS CLOSET


| PLAN REVISION S1007 & STAIR SECTION | | 7/10/00 |
|---|---|---|
| KENTON PETERS + ASSOC.<br>44 E.MIFFLIN<br>MADISON, WISCONSIN 53703<br>(608) 255-5858 | JEFFERSON COUNTY<br>LAW ENFORCEMENT CENTER<br>JEFFERSON, WISCONSIN | AA18 |

RC #449

Need to buy
2- 18"x18" Lockers
13- 15"x18 Lockers
1- 4'-0" bench

45 Lockers
2- 3'-0 benches
1- 4'-0 bench

5/12 c
Lockers 1-32 18"x18"
33-45 15"x18"

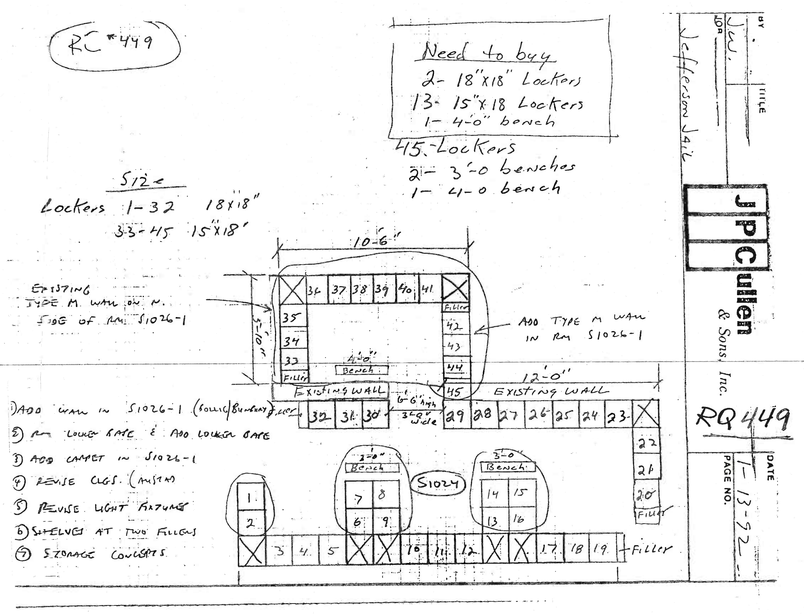


Jefferson Jail


JPCullen & Sons, Inc.


RQ 449

DATE 7-13-92

PAGE NO.

G 200E

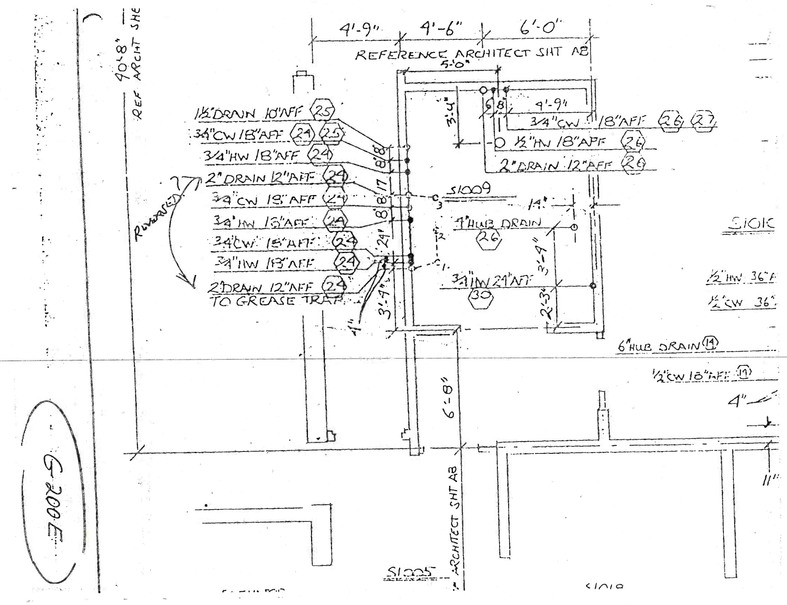

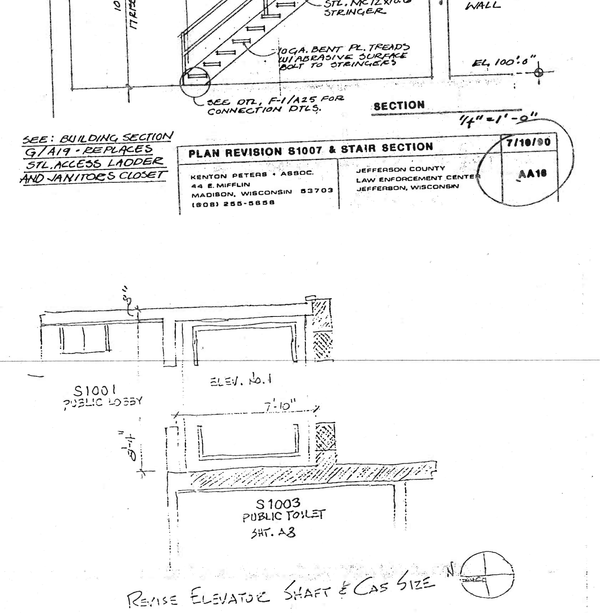
REVISE ELEVATOR SHAFT & CAB SIZE

PLANS
1/4"=1'-0"

| | | 7-19-00 |
|---|---|---|
| KENTON PETERS + ASSOC.<br>44 E.MIFFLIN<br>MADISON, WISCONSIN 53703<br>(608) 255-5858 | JEFFERSON COUNTY<br>LAW ENFORCEMENT CENTER<br>JEFFERSON, WISCONSIN | G8 |

| KENTON PETERS + ASSOCIATES, INC.<br>324 SOUTH HAMILTON STREET<br>MADISON, WI 53703<br>[608] 255-5656 | A8<br>SUPPLEMENTARY DRAWINGS |
|---|---|

**AS BUILT**
DEC 6, 1994