


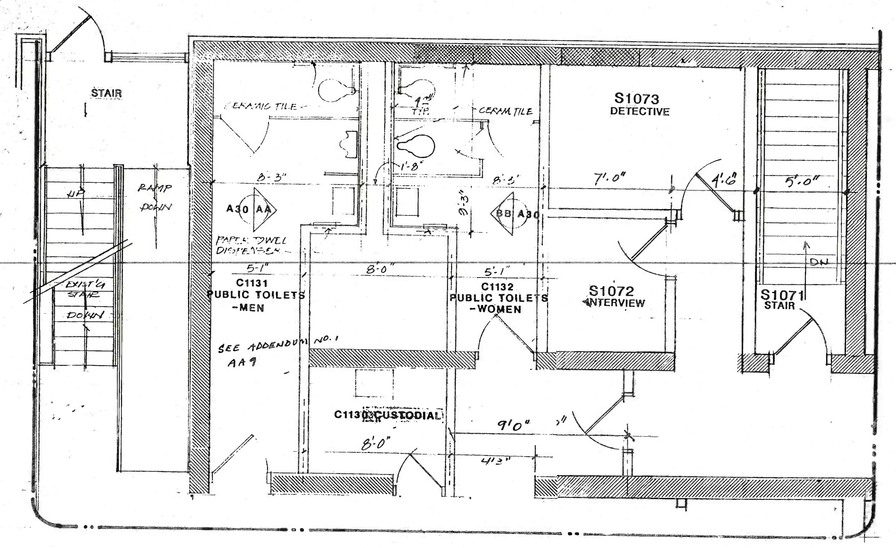


D ENLARGED PLAN
1/4"=1'-0"

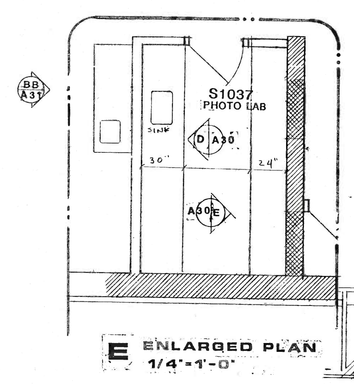


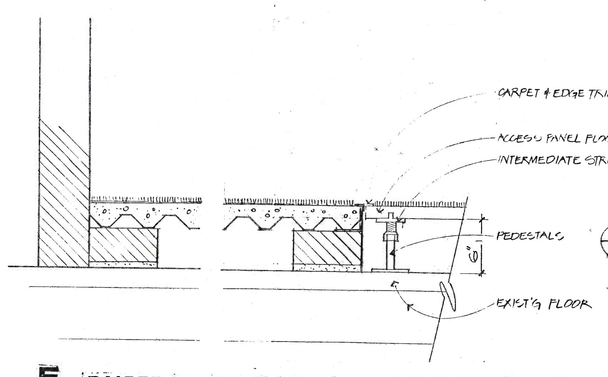

F RAISED FLOOR & ACCESSIBLE FLOOR DETAIL
1 1/2"=1'-0"

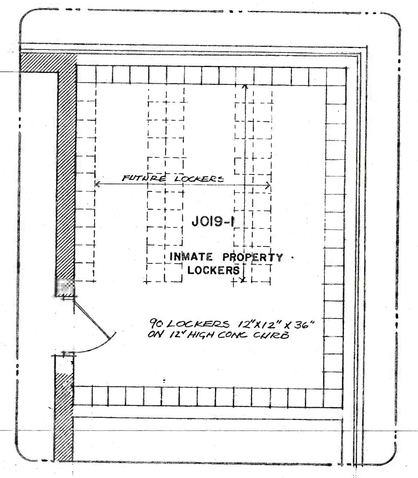

G ENLARGED PLAN
1/4"=1'-0"

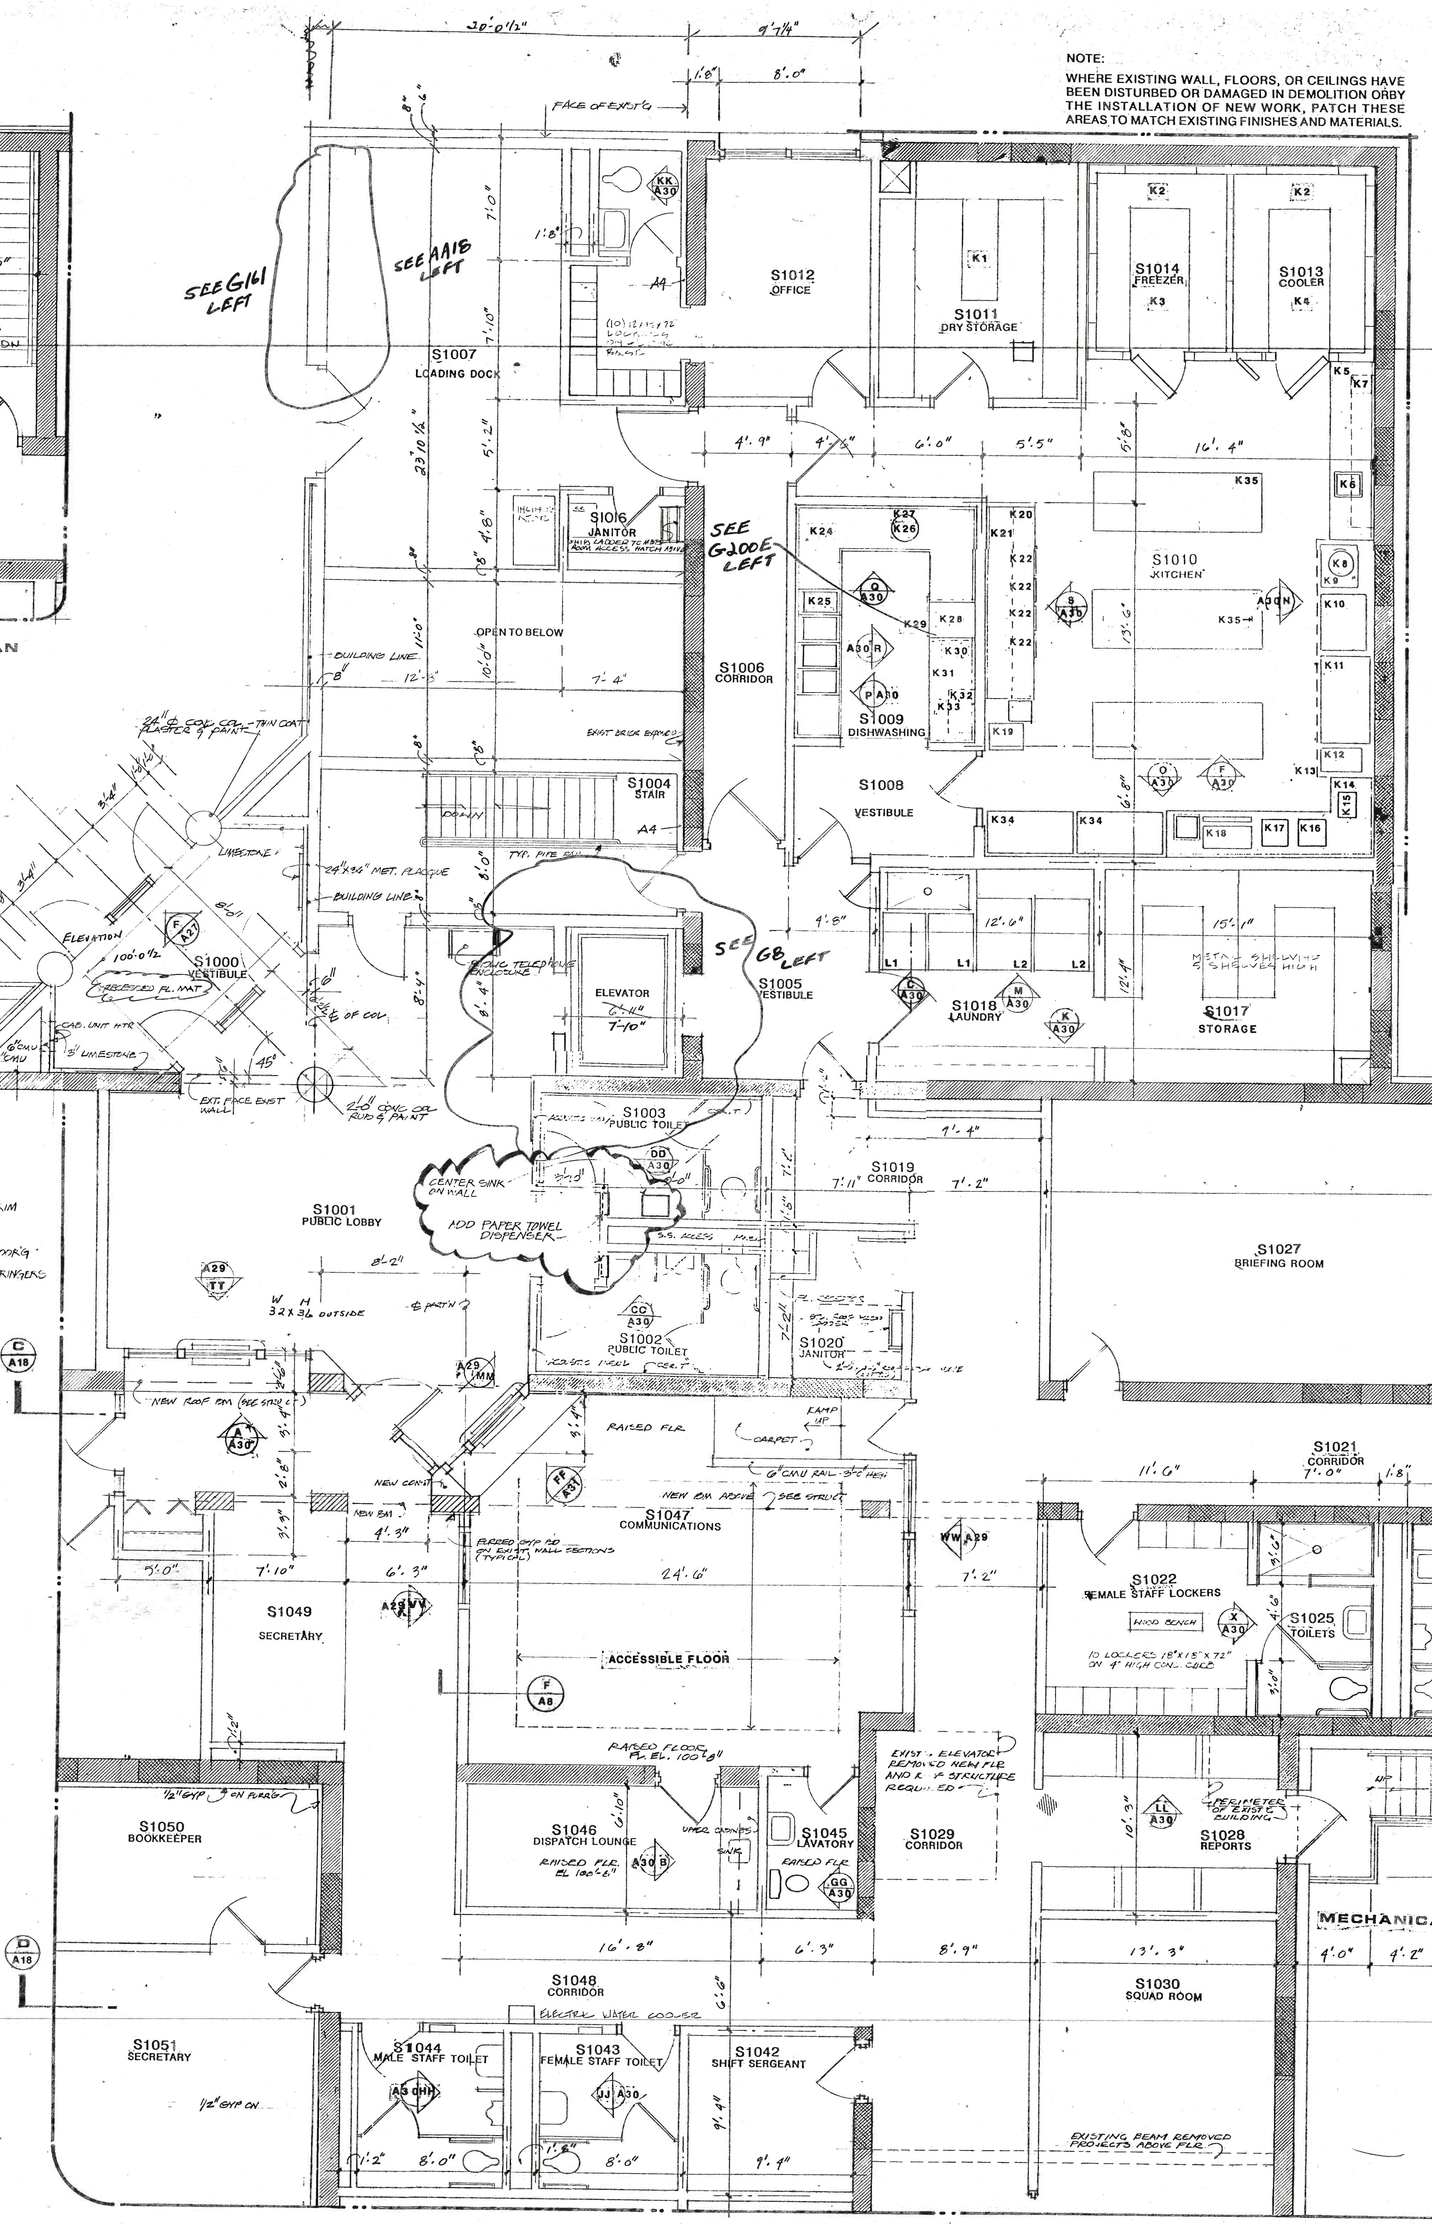

C ENLARGED PLAN
1/4"=1'-0"

NOTE:
WHERE EXISTING WALL, FLOORS, OR CEILINGS HAVE BEEN DISTURBED OR DAMAGED IN DEMOLITION ORBY THE INSTALLATION OF NEW WORK, PATCH THESE AREAS TO MATCH EXISTING FINISHES AND MATERIALS.

FOOD SERVICE EQUIPMENT SCHEDULE

ITEM	DESCRIPTION	REQ	PLUMBING HW	PLUMBING CW	PLUMBING D	PLUMBING G	ELECTRICAL HP	ELECTRICAL KW	ELECTRICAL V	ELECTRICAL ø	REMARKS
K1	Shelving	Lot									
K2	Shelving	Lot									
K3	Walk-In Freezer	1					1.5		208	3	Remote Condensing Unit
K4	Walk-In Cooler	1					.75		208	3	Remote Condensing Unit
K5	Counter, Sink	1	1/2"	1/2"	1/2"						
K6	Disposal	1					.75		208	3	
K7	Shelves	2									
K8	Kettle	1						12	480	3	
K9	Kettle Stand	1									
K10	Double Gas Oven	1				1"	(2).75		120	1	
K11	Gas Range	1				3/4"					
K12	Fryer	1				3/4"					
K13	Exhaust Hood	1									See Mechanical Plan
K14	Counter with Sink	1	1/2"	1/2"	2						
K15	Slicer	1					1/3		115	1	Cord and Plug
K16	Toaster	1						3.8	208	1	Cord and Plug
K17	Juice Machine	1							120	1	Cord and Plug (N.I.C.)
K18	Coffee Urn	1		3/8"				15	480	3	
K19	Mixer	1					.5		208	1	Cord and Plug
K20	Prep Counter	1									
K21	Upper Cabinets	1									
K22	Ingredient Bin	4									
K23	Cooks' Table	2									
K24	Table with Sinks	1	(2)1/2"	(2)1/2"	(2)2"						
K25	Disposal	1					.75		208	3	
K26	Disposal	1					1		480	3	Control Panel
K27	Pre-rinse Unit	1	1/2"	1/2"	2"						
K28	Dishwasher	1	(2)3/4"		2"	1/2"	1	5	208	3	
K29	Exhaust Hood	1									See Mechanical Plan
K30	Booster Heater	1									See Plumbing Plan
K31	Clean Dish Table	1									
K32	Shelf	1									
K33	Grease Trap	1									See Plumbing Plan
K34	Serving Carts	2					1.5	120	1		Cord and Plug
K35	HANGING RACK	1									

LAUNDRY EQUIPMENT SCHEDULE

ITEM	DESCRIPTION	REQ	HW	CW	D	G	HP	V	ø	REMARKS
L1	Washer	2	3/4"	3/4"	2"		1/3	480	3	
	Extractor						1.5	480	3	
L2	Dryer	2					1/4	480	3	

DATE	REVISION

STRUCTURAL CONSULTANT

MECHANICAL CONSULTANT

ARCHITECT
KENTON PETERS + ASSOC., INC.
44 E. MIFFLIN
MADISON, WISCONSIN 53703
(608) 255-5658

JEFFERSON COUNTY
LAW ENFORCEMENT CENTER
JEFFERSON, WISCONSIN

MISC. ENLARGED PLANS
SHERIFF'S DEPT.
1/4"=1'-0"

8-11-90
AB

AS BUILT
DEC 6, 1994

PLAN NORTH