
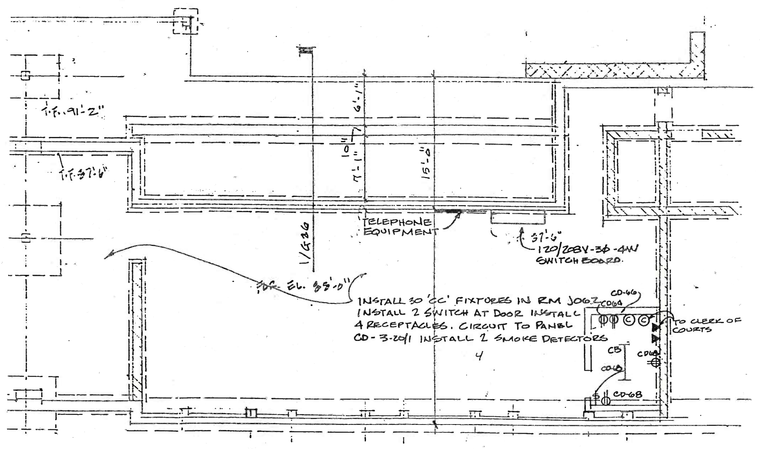
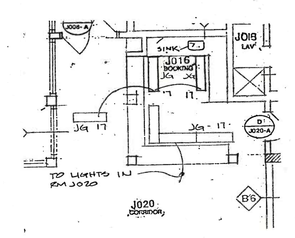




PARTIAL GROUND FLOOR PLAN
SCALE 3/16"=1'-0"

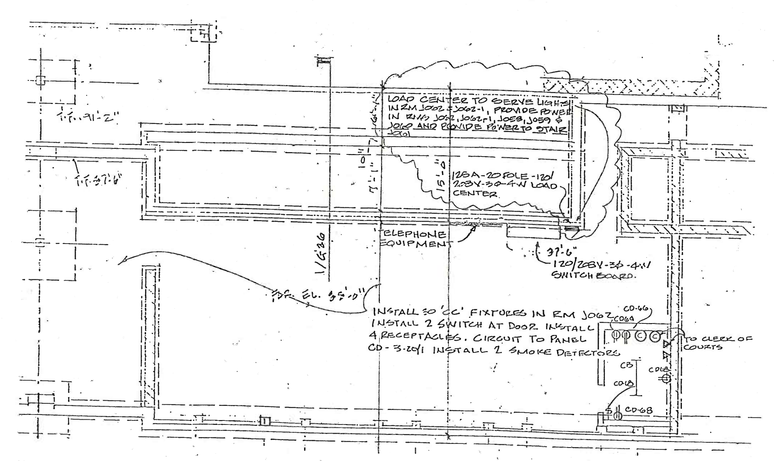



| COURTHOUSE WEST WALL ELECTRICAL PLAN | | 11-12-90 |
|---|---|---|
| KENTON PETERS + ASSOC.<br>44 E. MIFFLIN<br>MADISON, WISCONSIN 53703<br>(608) 255-5656 | JEFFERSON COUNTY<br>LAW ENFORCEMENT CENTER<br>JEFFERSON, WISCONSIN | G36 |

| PARTIAL GRD FLR PLAN J016 | | 1-7-91 |
|---|---|---|
| KENTON PETERS + ASSOC.<br>44 E. MIFFLIN<br>MADISON, WISCONSIN 53703<br>(608) 255-5656 | JEFFERSON COUNTY<br>LAW ENFORCEMENT CENTER<br>JEFFERSON, WISCONSIN | E87 |


| COURTHOUSE WEST WALL - NEW PANEL | | 1-24-91 |
|---|---|---|
| KENTON PETERS + ASSOC.<br>44 E. MIFFLIN<br>MADISON, WISCONSIN 53703<br>(608) 255-5656 | JEFFERSON COUNTY<br>LAW ENFORCEMENT CENTER<br>JEFFERSON, WISCONSIN | E99 |

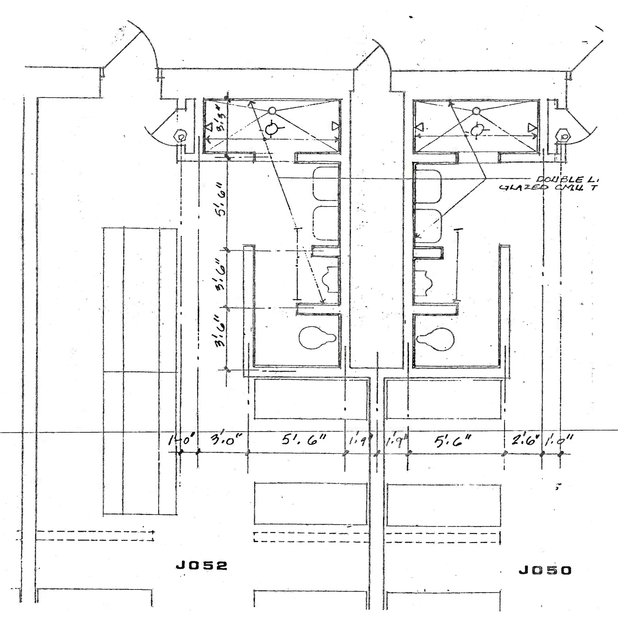

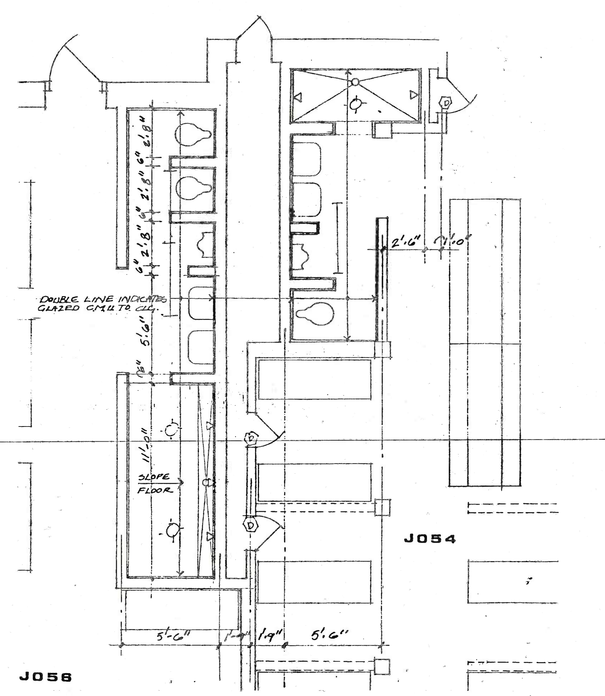
| HUBER J050-J052 ELECTRICAL | | 11/15/90 |
|---|---|---|
| KENTON PETERS + ASSOC.<br>44 E. MIFFLIN<br>MADISON, WISCONSIN 53703<br>(608) 255-5656 | JEFFERSON COUNTY<br>LAW ENFORCEMENT CENTER<br>JEFFERSON, WISCONSIN | G62 |

| HUBER J054-J056 ELECTRICAL | | 11/15/90 |
|---|---|---|
| KENTON PETERS + ASSOC.<br>44 E. MIFFLIN<br>MADISON, WISCONSIN 53703<br>(608) 255-5656 | JEFFERSON COUNTY<br>LAW ENFORCEMENT CENTER<br>JEFFERSON, WISCONSIN | G64 |

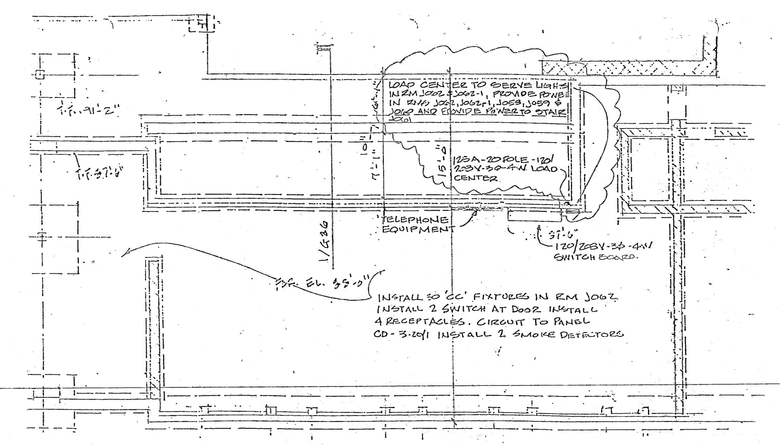


| COURTHOUSE WEST WALL - NEW PANEL | | 2/26/91 |
|---|---|---|
| KENTON PETERS + ASSOC.<br>44 E. MIFFLIN<br>MADISON, WISCONSIN 53703<br>(608) 255-5656 | JEFFERSON COUNTY<br>LAW ENFORCEMENT CENTER<br>JEFFERSON, WISCONSIN | E121 |

**AS BUILT**
DEC 6, 1994

| KENTON PETERS + ASSOCIATES, INC.<br>324 SOUTH HAMILTON STREET<br>MADISON, WI 53703<br>(608) 255-5656 | SUPPLEMENTARY DRAWING<br>E-1A |
|---|---|