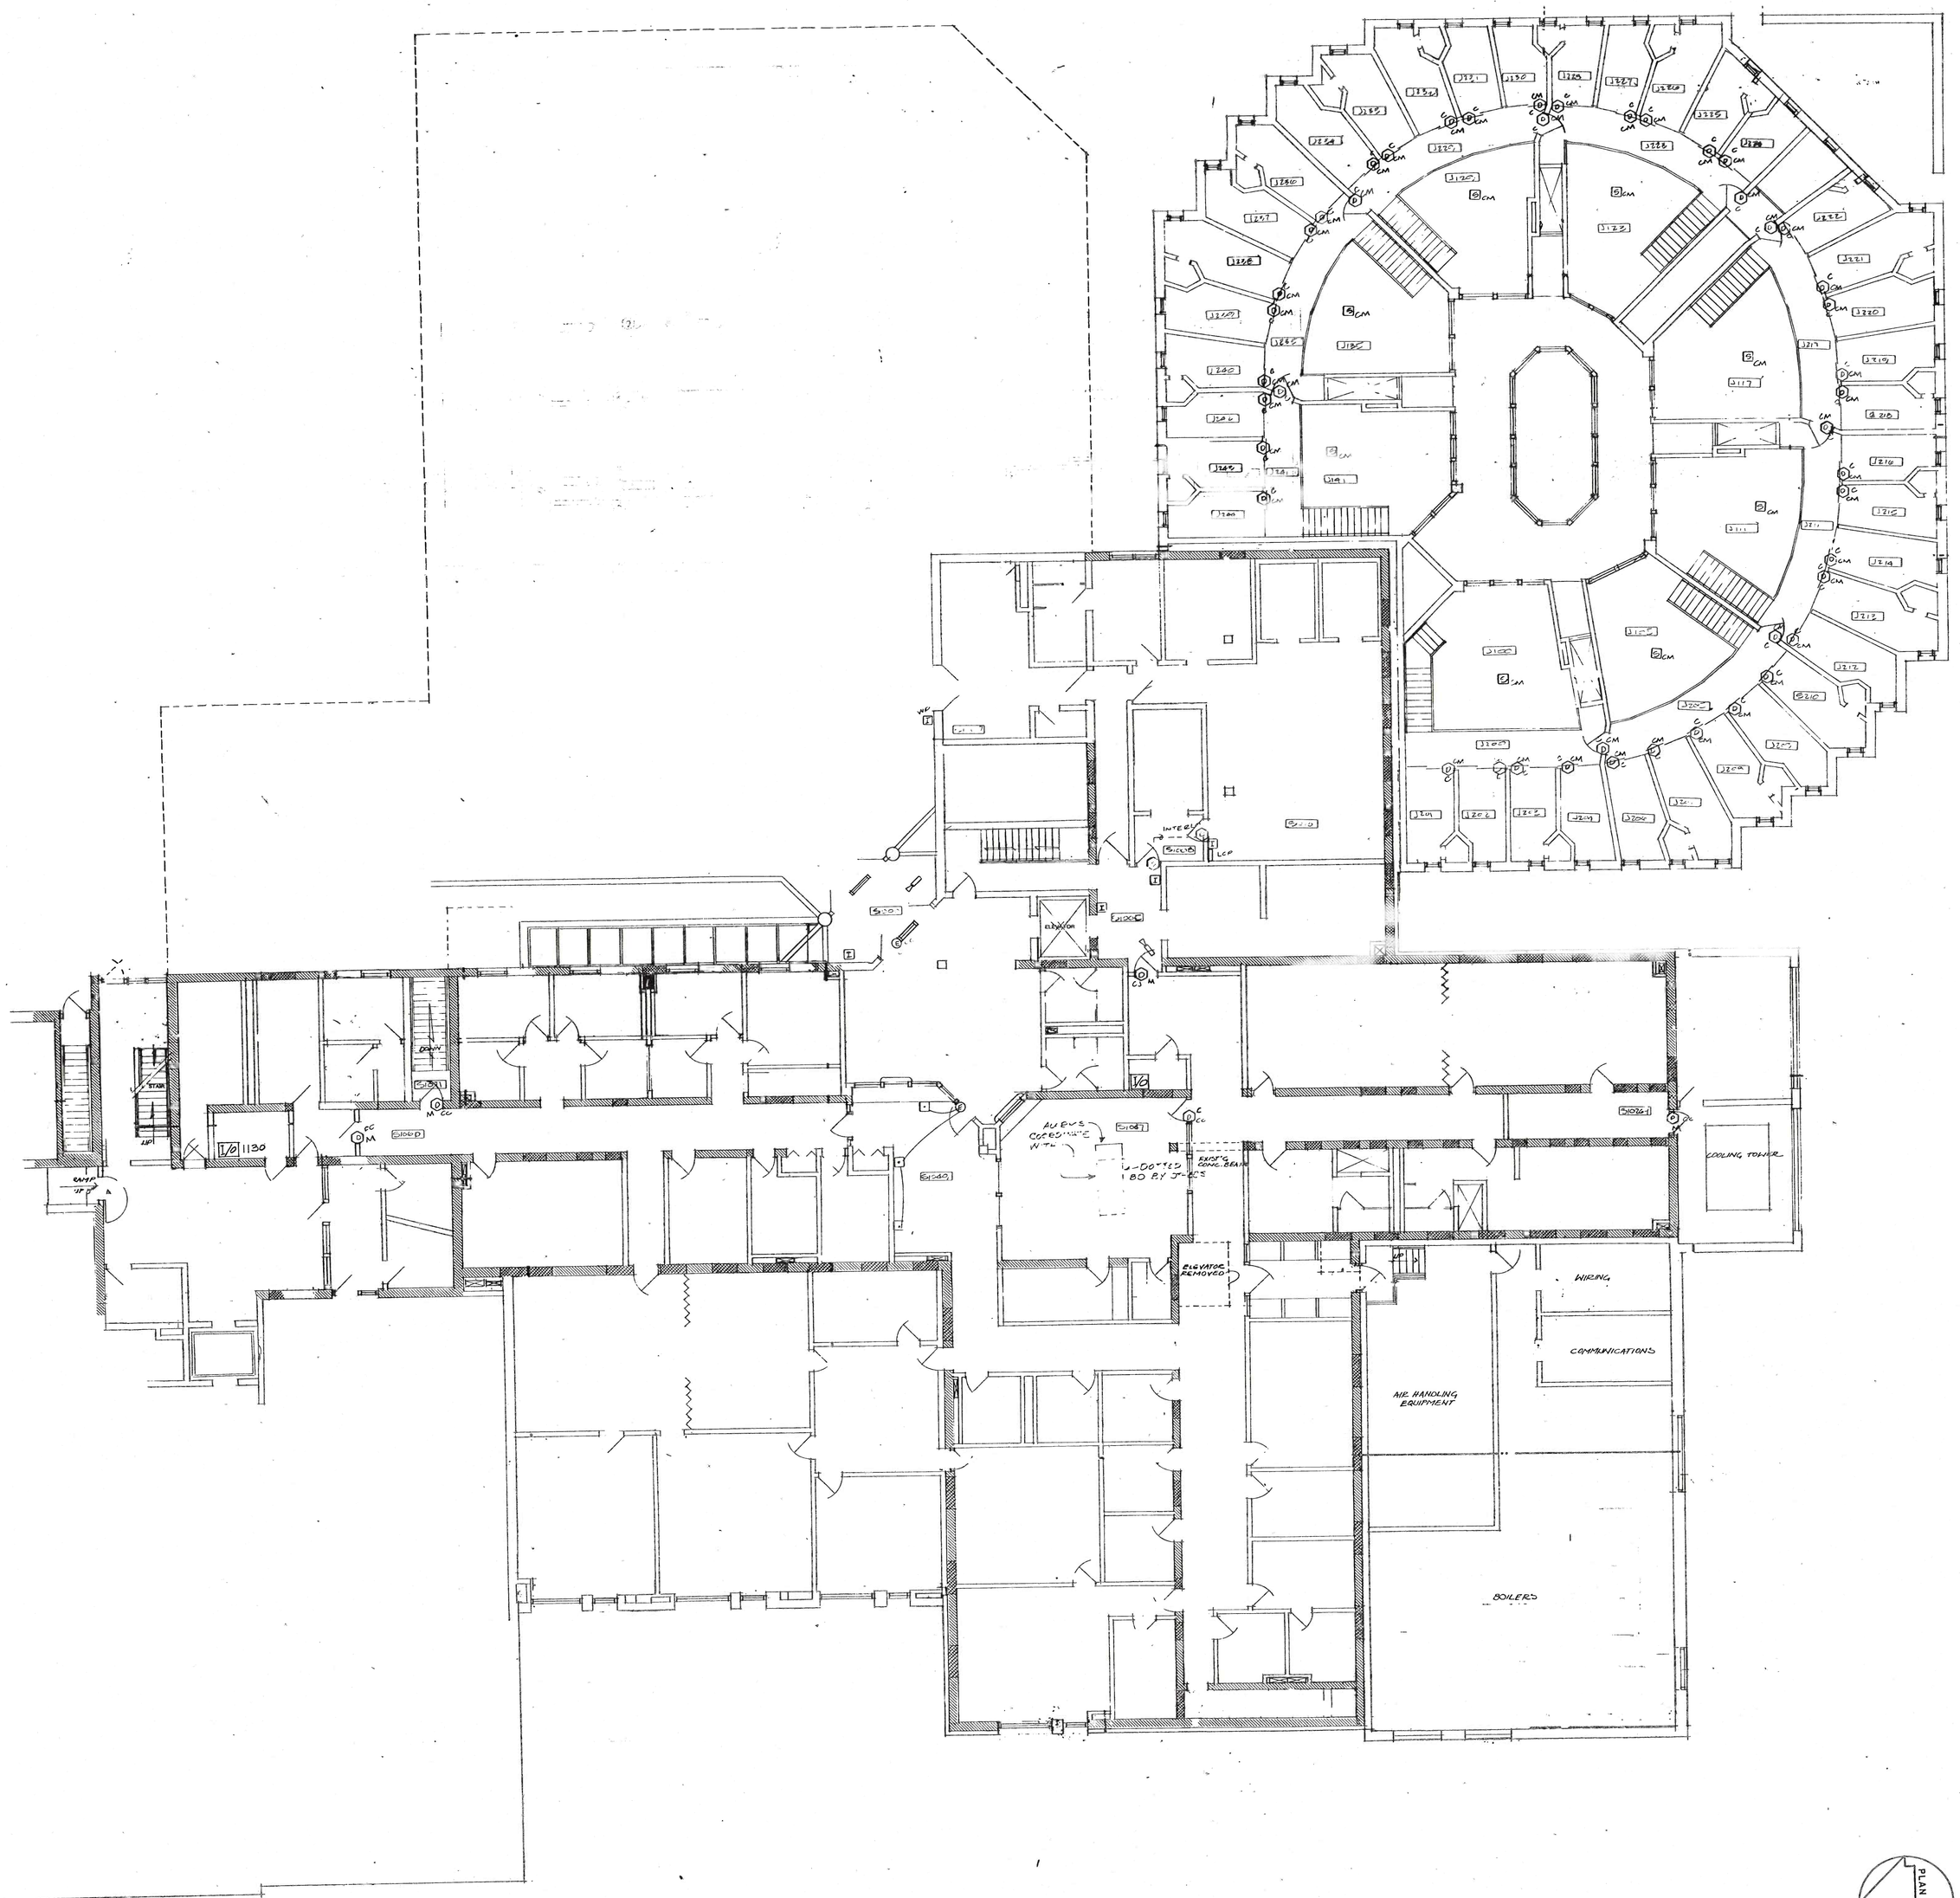



AS BUILT
DEC 6, 1994

PLAN NORTH

| DATE | REVISION |
|---|---|
| | |

STRUCTURAL CONSULTANT

MECHANICAL CONSULTANT
MDI 1910 MAYFLOWER DR. MIDDLETON, WI.
608-836-7600

ARCHITECT
KENTON PETERS + ASSOC., INC.
44 E MIFFLIN
MADISON, WISCONSIN 53703
(608) 255-5656

JEFFERSON COUNTY
LAW ENFORCEMENT CENTER
JEFFERSON, WISCONSIN

FIRST FLOOR PLAN
1/8"-1'-0"
SECURITY

12-11-90

E-10