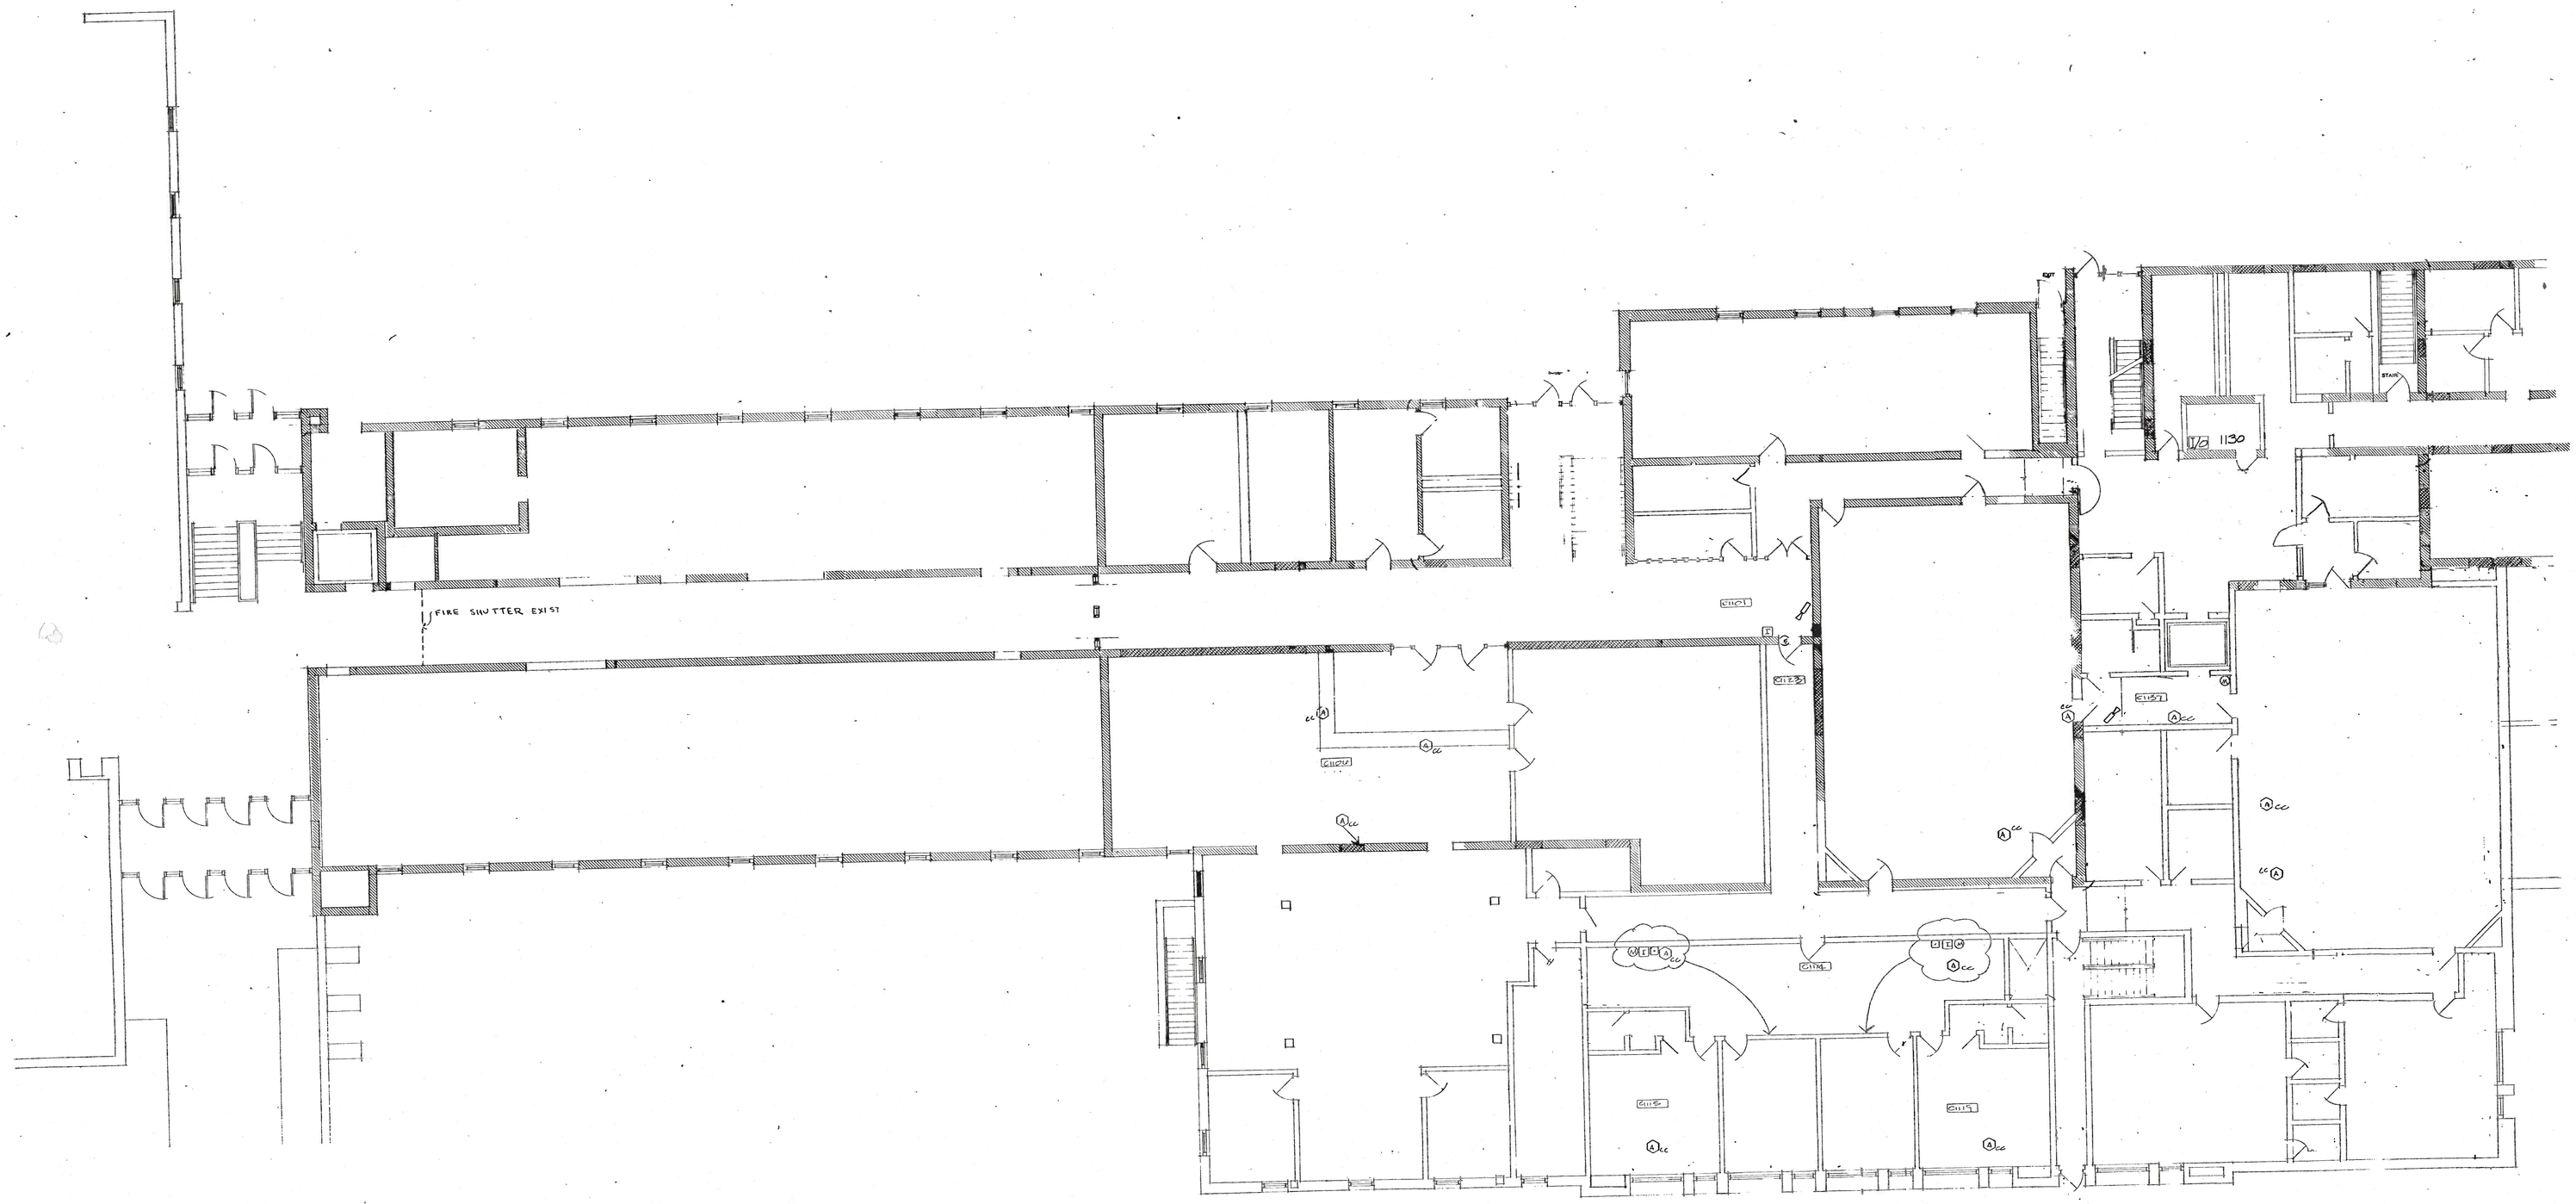



PLAN NORTH

AS BUILT
DEC 6, 1994

CTURAL CONSULTANT.

RICAL CONSULTANT.
1910 MAYFLOWER DR. MIDDLETON, WI.
608-836-7600

ITECT.
ITON PETERS + ASSOC., INC.
E MIFFLIN
DISON, WISCONSIN 53703
) 255-5858

FFERSON COUNTY
W ENFORCEMENT CENTER

FFERSON, WISCONSIN

ST FLOOR PLAN
RTHOUSE
0"-0"
URITY

6-11-90

E-11