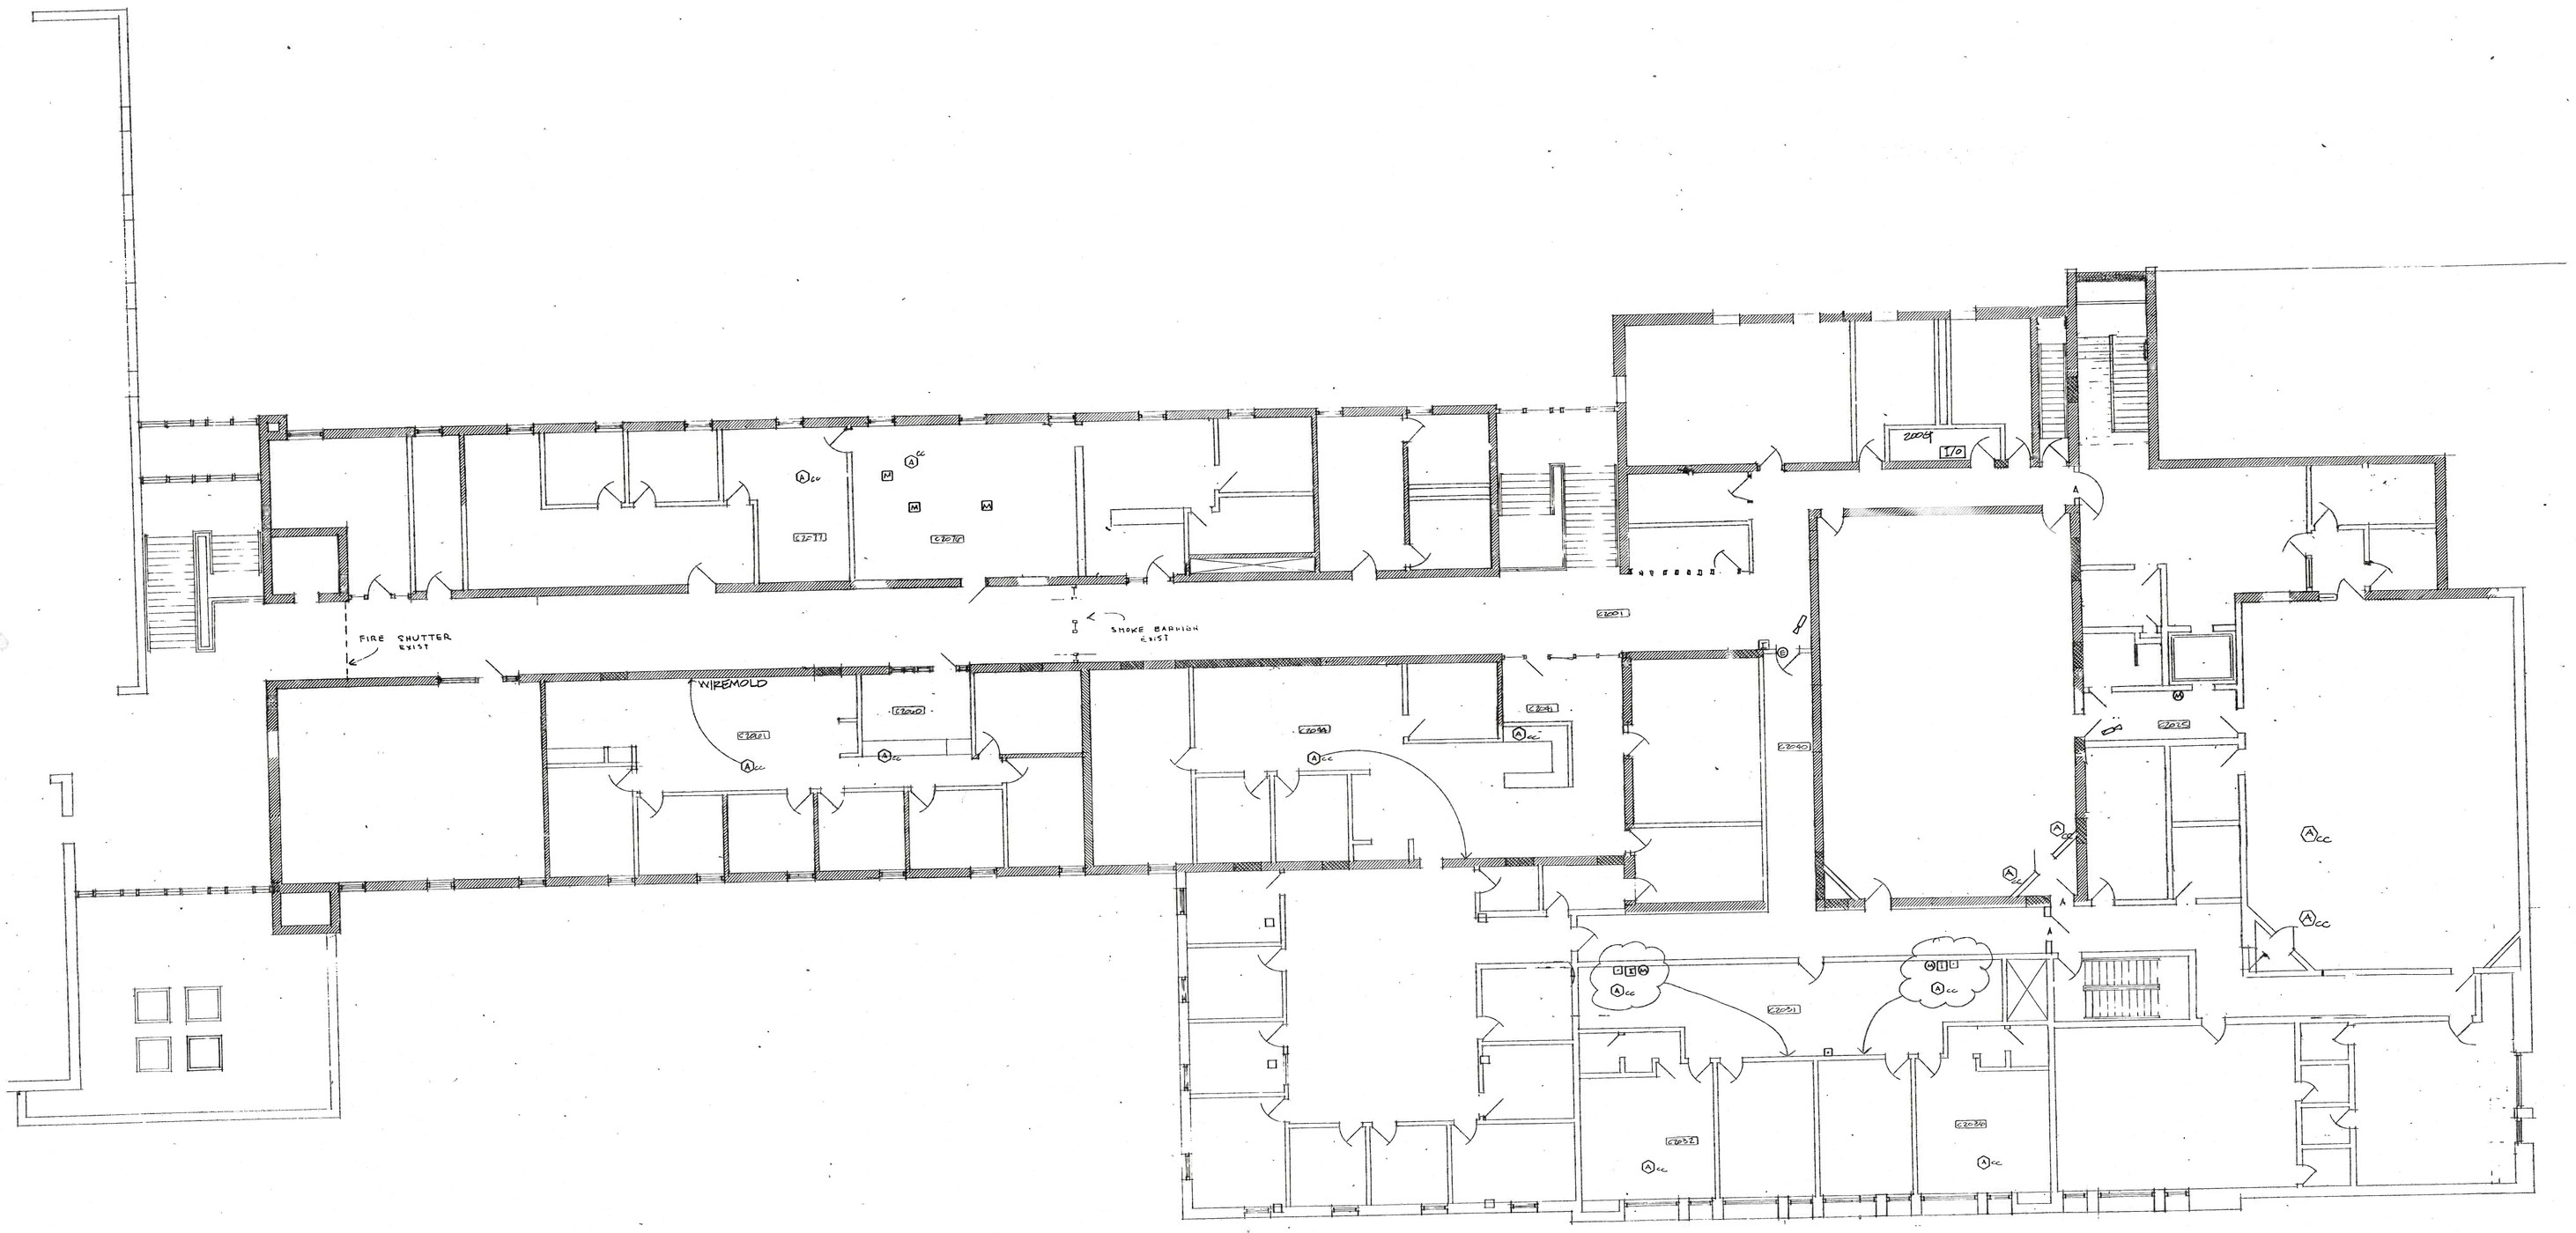


PLAN NORTH

STRUCTURAL CONSULTANT.

MECHANICAL CONSULTANT
MDI 1910 MAYFLOWER DR. MIDDLETON, WI.
608-836-7600

ARCHITECT.
KENTON PETERS + ASSOC., INC.
44 E MIFFLIN
MADISON, WISCONSIN 53703
(608) 255-5656

JEFFERSON COUNTY
LAW ENFORCEMENT CENTER
JEFFERSON, WISCONSIN

SECOND FLOOR PLAN
COURTHOUSE
~~79-1-80~~
SECURITY

6-11-90

E-12

DATE	REVISION
	2 OCT

AS BUILT
DEC 6, 1994