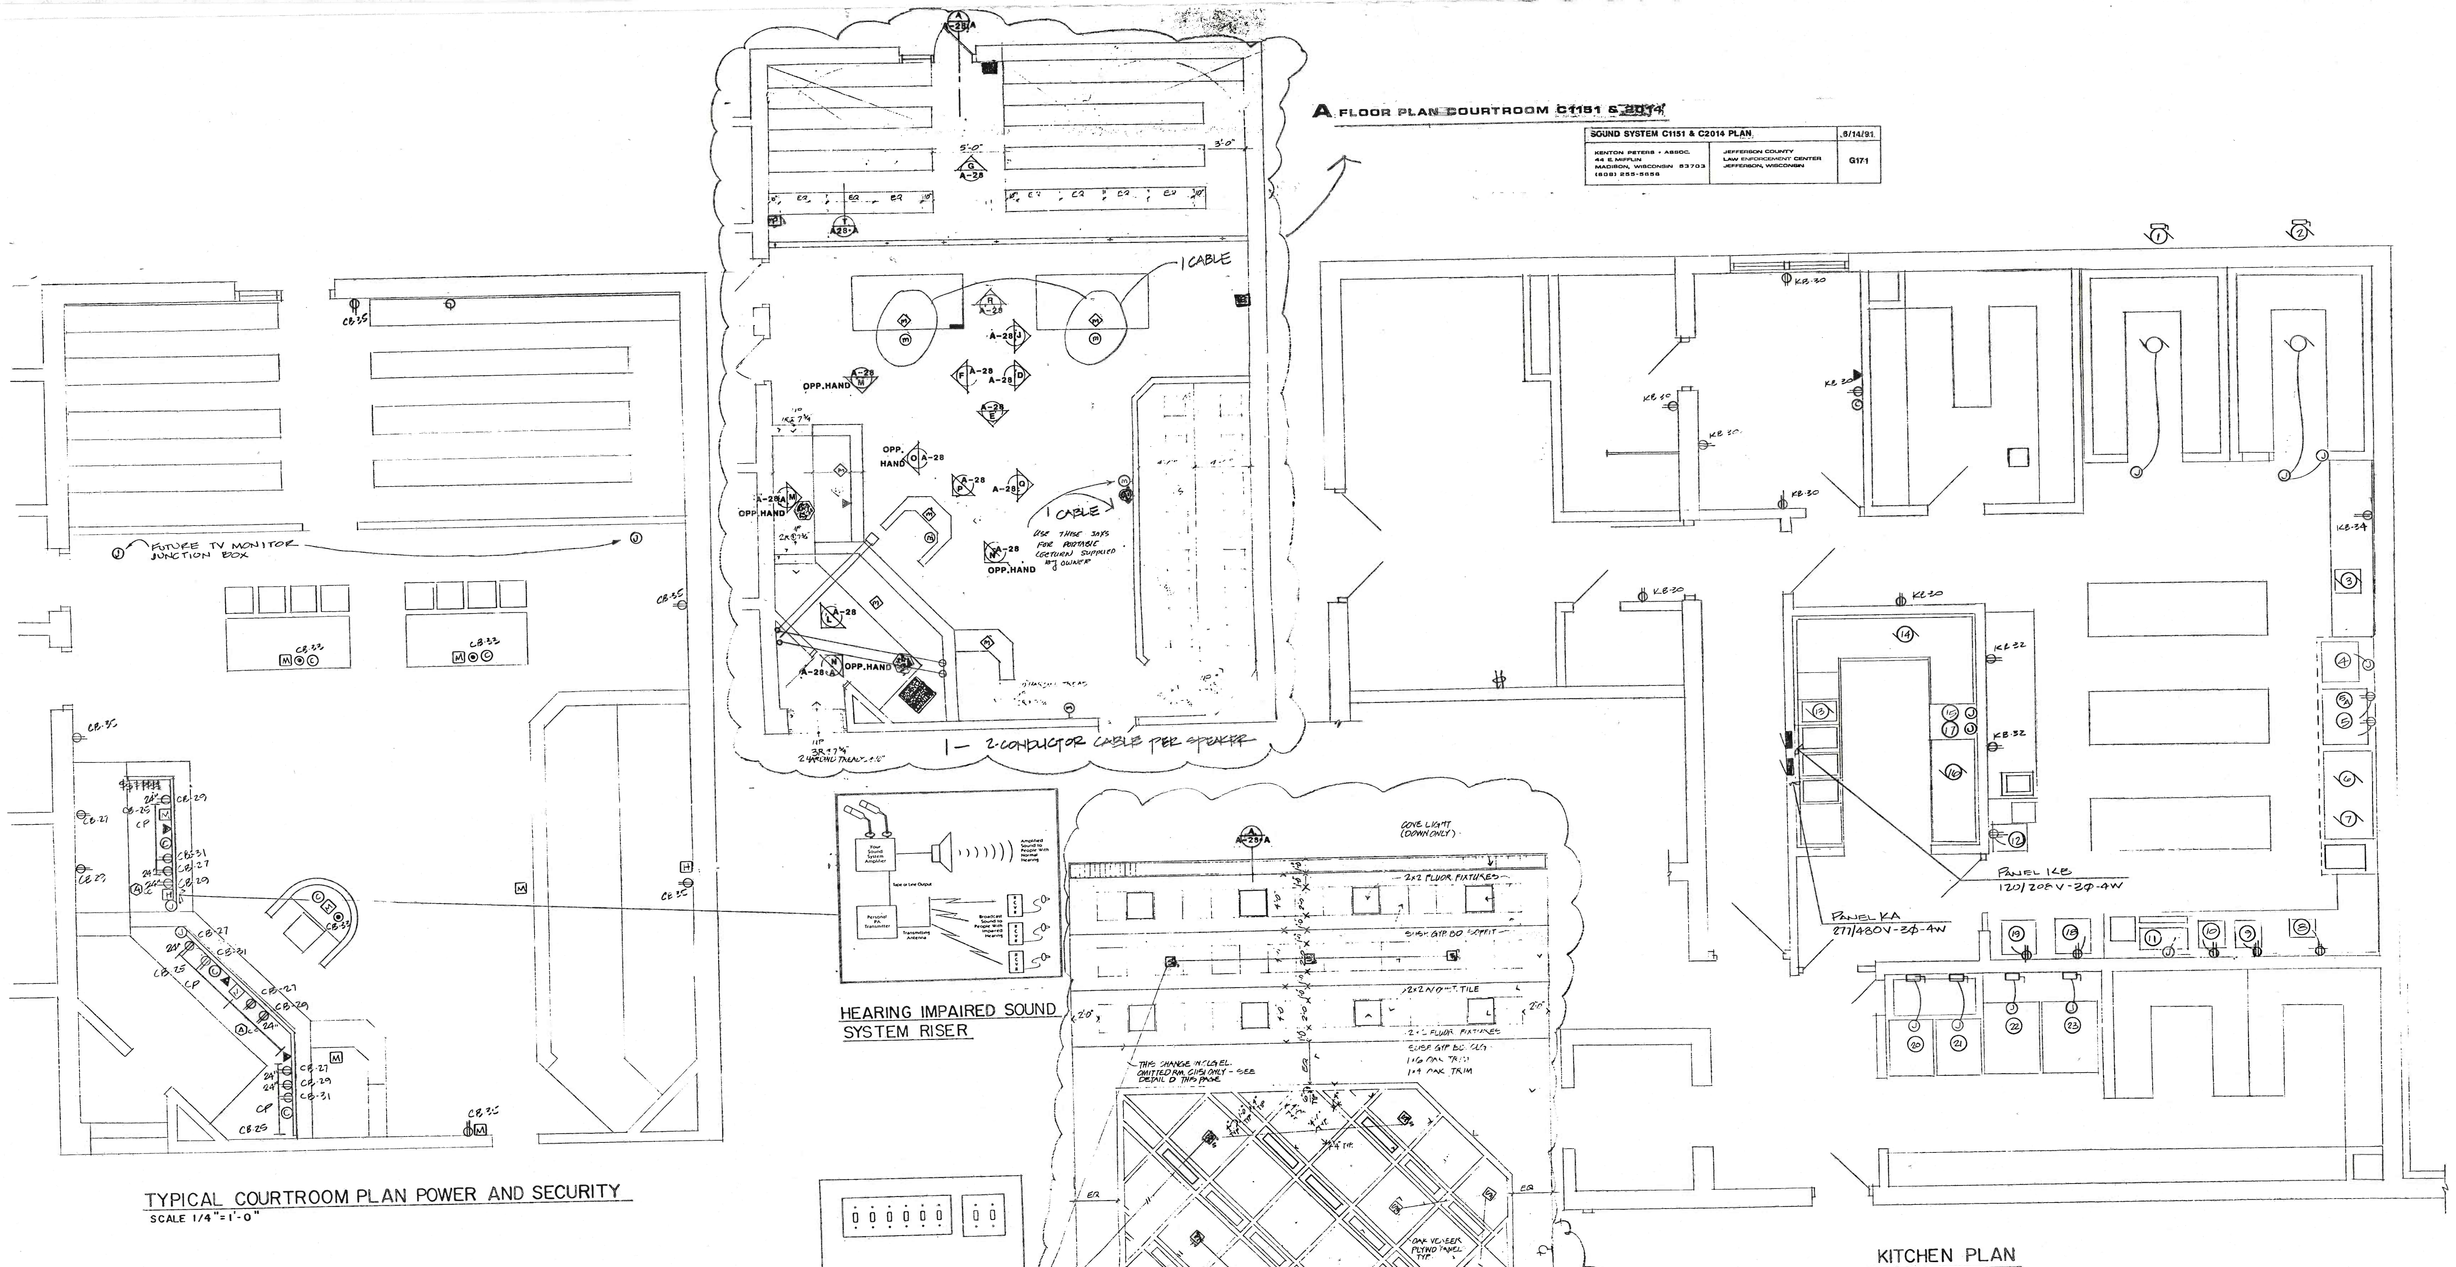


MOTOR & SPECIAL EQUIPMENT SCHEDULE-KITCHEN

NO.	DESCRIPTION	KW	HP	VOLT	PH.	PNL	PANEL PROTECT. DEVICE AMP	POLE	START. SIZE	EQUIPMENT TO FURNISH	LOC.	REMARKS
1	WALK-IN FREEZER		1/2	208	1	KE	15	1		WP DISC. 30A	EXIST	
2	WALK-IN COOLER		3/4	208	1	KE	15	1		WP DISC 30A	ZOOF	
3	DISPOSAL		3/4	208	3	KE	15	3		DISC 30A	ATUNIT	
4	KETTLE	12		480	3	KA	20	3		DISC 30A	ATUNIT	
5	DOUBLE GAS OVEN		3/8	120	1	KB	20	1		DUPLEX RECPT	IN WALL	RECPT TO MATCH PLUG
5A	DOUBLE GAS OVEN		3/8	120	1	KE	20	1		DUPLEX RECPT	IN WALL	RECPT TO MATCH PLUG
6	SUPPLY FAN		2	480	3	KA	15	3		WP DISC 30A	ROOF	
7	EXHAUST FAN		2	480	3	KA	15	3		WP DISC 30A	ZOOF	
8	SLICER		1/3	120	1	KB	20	1		DUPLEX RECPT	IN WALL	RECPT TO MATCH PLUG
9	TOASTER	3.8		208	1	KE	20	2		250V RECPT.	IN WALL	RECPT TO MATCH PLUG
10	JUICE MACHINE			120	1	KE	20	1		DUPLEX RECPT	IN WALL	RECPT TO MATCH PLUG
11	COFFEE URN	15		480	3	KA	30	3		30A DISC	ATUNIT	
12	MIXER		1/2	208	3	KD	15	2		30A DISC	ATUNIT	
13	DISPOSAL		3/4	208	3	KD	15	3		30A DISC	ATUNIT	
14	DISPOSAL		1	480	3	KA	15	3		30A DISC	ATUNIT	
15	DISHWASHER	5	1	208	3	KD	30	3		30A DISC	ATUNIT	
16	EXHAUST FAN		3/4	208	3	KE	15	3		30A DISC	ATUNIT	
17	BOOSTER HEATER	25		480	3	KA	30	3		30A DISC	ATUNIT	
18	SERVING CART	1.5		120	1	KE	20	1		DUPLEX RECPT	IN WALL	RECPT TO MATCH PLUG
19	SERVING CART	1.5		120	1	KE	20	1		DUPLEX RECPT	IN WALL	RECPT TO MATCH PLUG
20	DRYER	1/2	9.3	480	3	KA	15	3		30A DISC	ATUNIT	
21	DRYER	1/2	1.5	480	3	KA	15	3		30A DISC	ATUNIT	
22	WASHER		1.1	480	3	KA	15	3		30A DISC	ATUNIT	
23	WASHER		1.1	480	3	KA	15	3		30A DISC	ATUNIT	

DATE	REVISION

STRUCTURAL CONSULTANT

MECHANICAL CONSULTANT
MDI 1910 MAYFLOWER DR. MIDDLETON, WI.
608-836-7600

ARCHITECT
KENTON PETERS + ASSOC., INC.
44 E. MIFFLIN
MADISON, WISCONSIN 53703
(608) 255-5656

JEFFERSON COUNTY
LAW ENFORCEMENT CENTER
JEFFERSON, WISCONSIN

1/4" PLAN COURTROOM AND KITCHEN

6-11-90

E-13

AS BUILT
DEC 6, 1994