

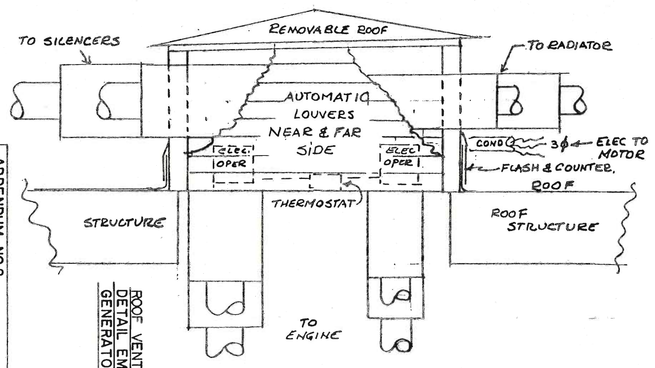


ROOF VENT AND PIPING DETAIL EMERGENCY GENERATOR


ADDENDUM NO.2	7/10/90
KENTON PETERS - ASSOC. 44 E. MIFFLIN MADISON, WISCONSIN 53703 (608) 255-5656	JEFFERSON COUNTY LAW ENFORCEMENT CENTER JEFFERSON, WISCONSIN
EA-1	

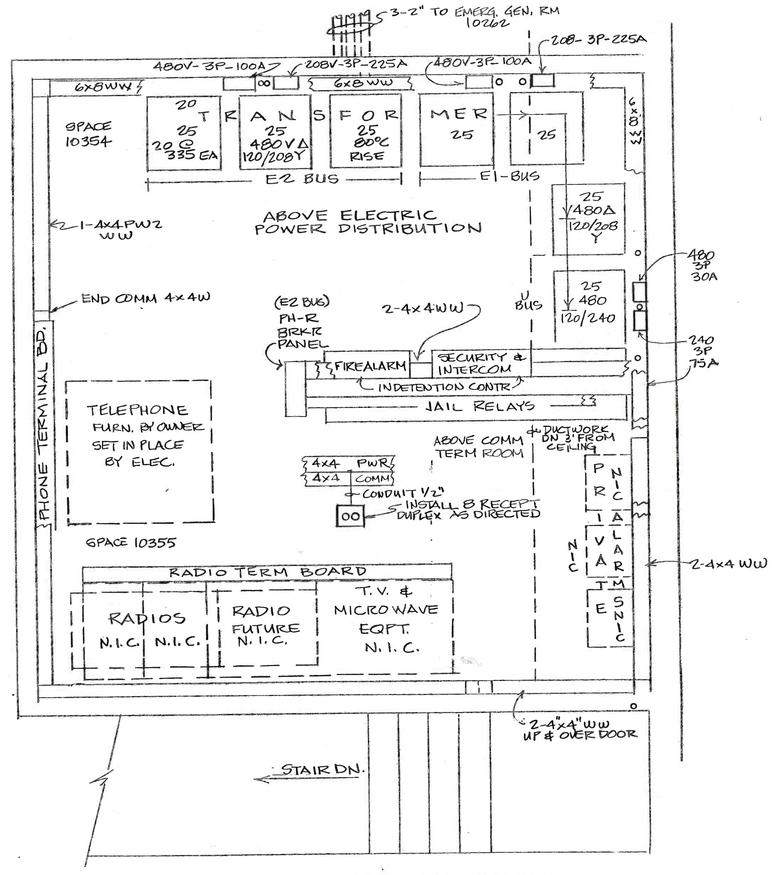


COMMUNICATION AND WIRING ROOM - SECOND FLOOR

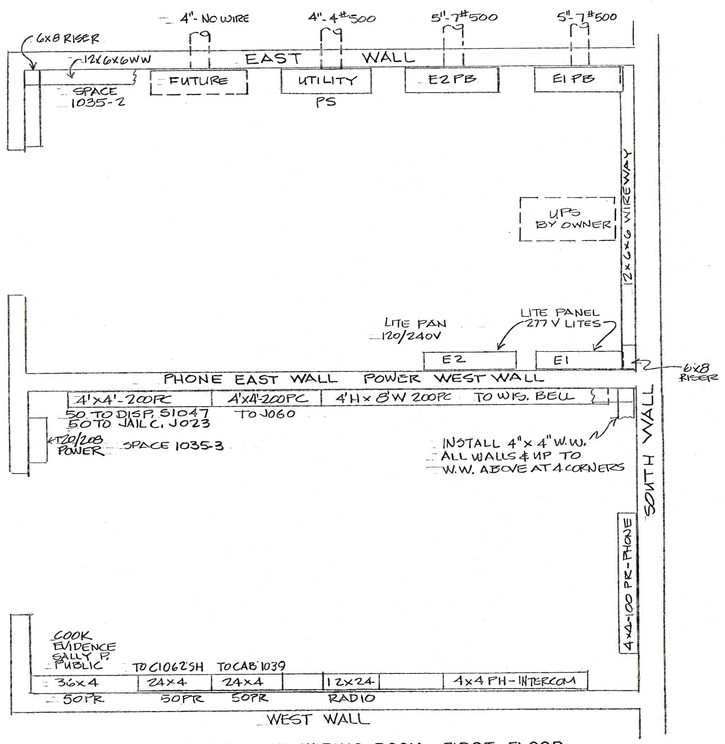

COMMUNICATION AND WIRING ROOM - FIRST FLOOR

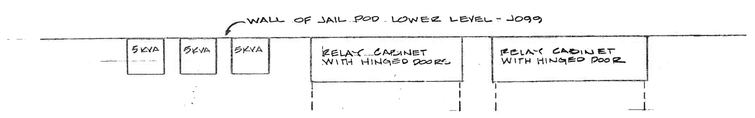


PLAN VIEW - JAIL POD LOWER LEVEL

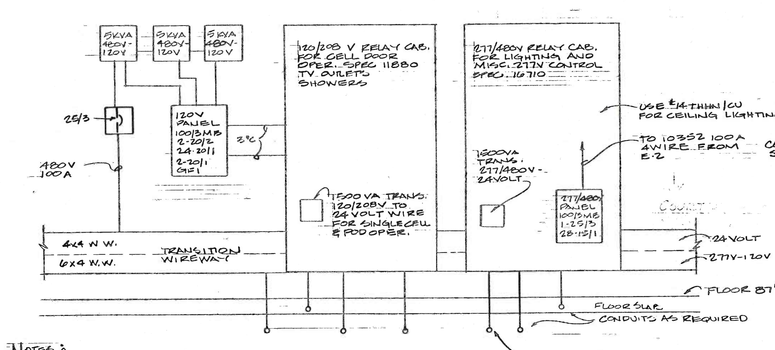


NOTES:
120V RELAYS - 24V COIL 10A CONTACTS
277V RELAYS - 24V COIL 5/10 A CONTACTS
480/600V RATED


JAIL CONTROL EQUIPMENT ELEVATION

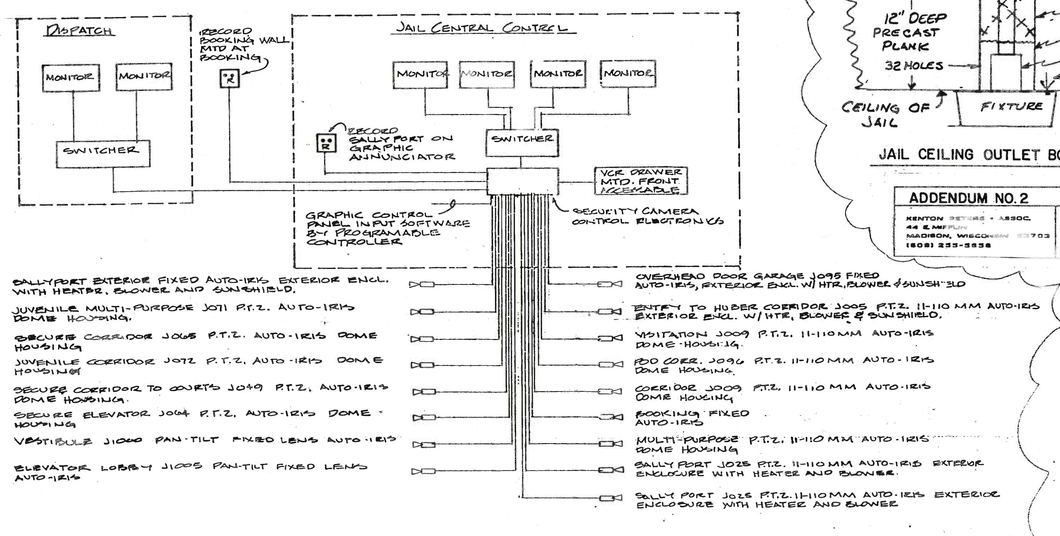


SECURITY CAMERA BLOCK DIAGRAM

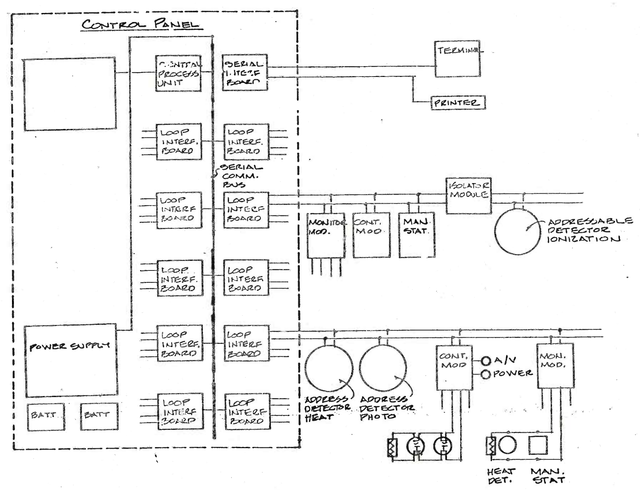


FIRE ALARM SYSTEM BLOCK DIAGRAM

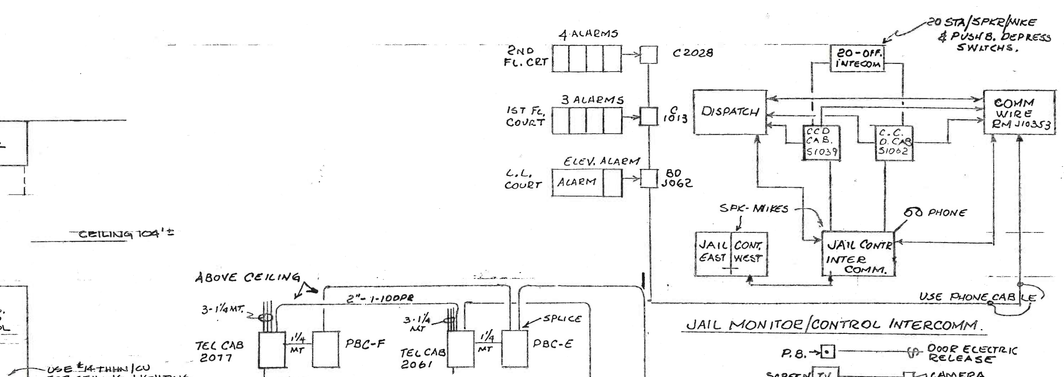


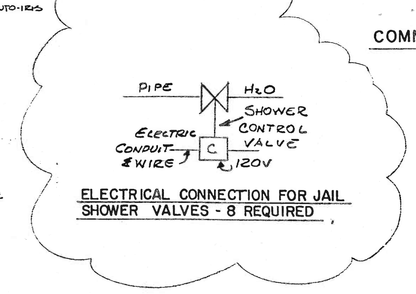


ELECTRICAL CONNECTION FOR JAIL SHOWER VALVES - 8 REQUIRED

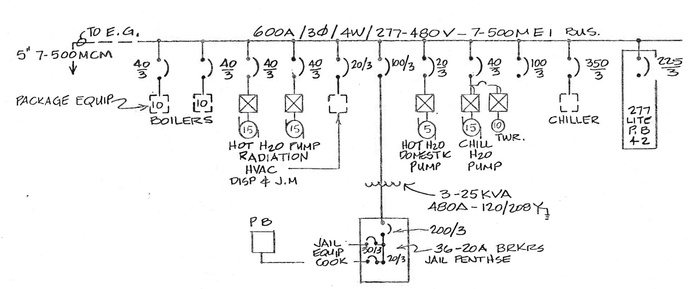

ELECTRICAL ONE LINE RISER

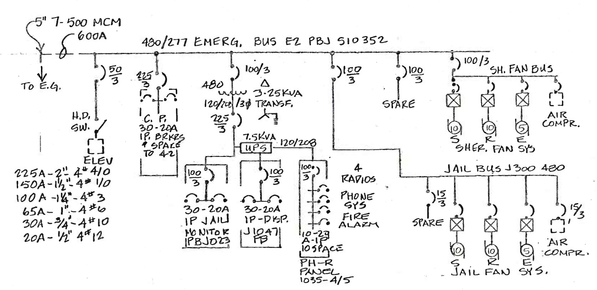

ELECTRICAL ONE LINE RISER

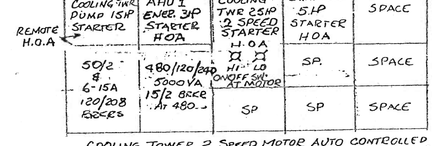

COOLING TOWER 2 SPEED MOTOR AUTO CONTROLLED BY H2O TEMP. - FOR HAND CONTROL PROVIDE REMOTE SWITCH 1 0 2 FOR SPEED SELECTION. IN ADDION TO ON OFF SW.

DATE	REVISION
1.	Panel CP on bus E-2 is panel 'JA'. Add panel 'JB' on bus E-1.
2.	Add transformer and panel 'JC' to Bus E-1. Add transformer and panel 'JD' to Bus E-2. Panels to be in wiring room.
3.	Panel PH-R to be in wiring room.
4.	Panels 'JA and 'JB' to be 100A.

STRUCTURAL CONSULTANT

MECHANICAL CONSULTANT
MDI 1910 MAYFLOWER DR. MIDDLETON, WI. 608-836-7600

ARCHITECT
KENTON PETERS + ASSOC., INC.
44 E MIFFLIN
MADISON, WISCONSIN 53703
(608) 255-5656

JEFFERSON COUNTY
LAW ENFORCEMENT CENTER
JEFFERSON, WISCONSIN

DETAILS AND RISERS

6-11-90

E-16

AS BUILT
DEC 6, 1994