


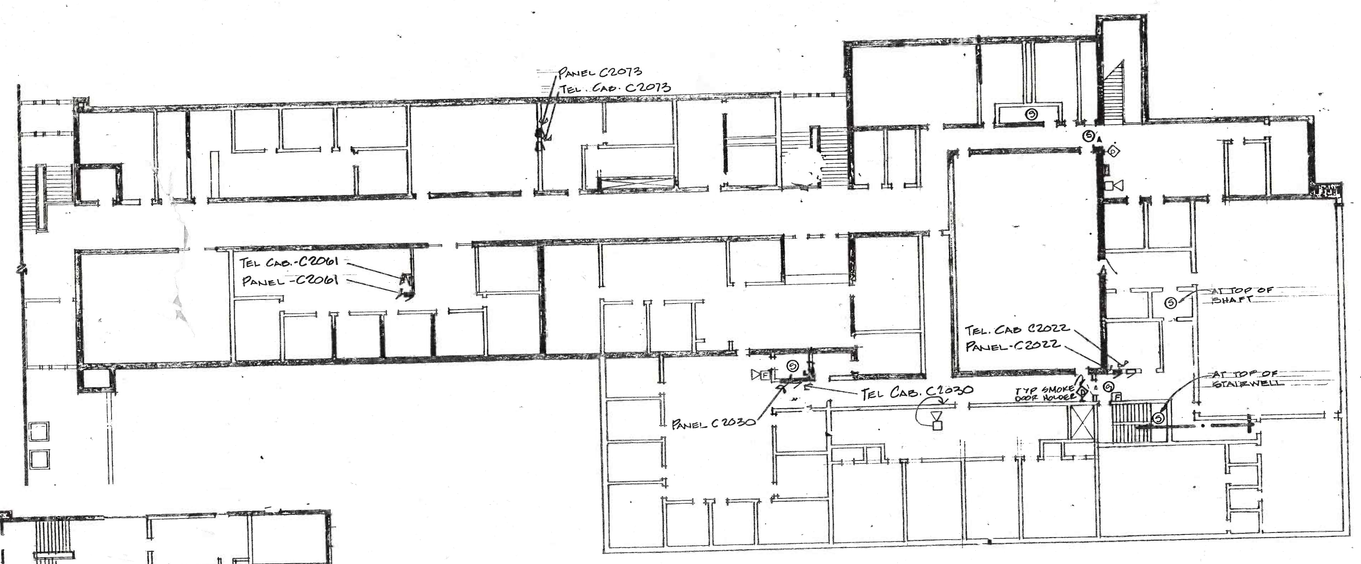



SECOND FLOOR PLAN

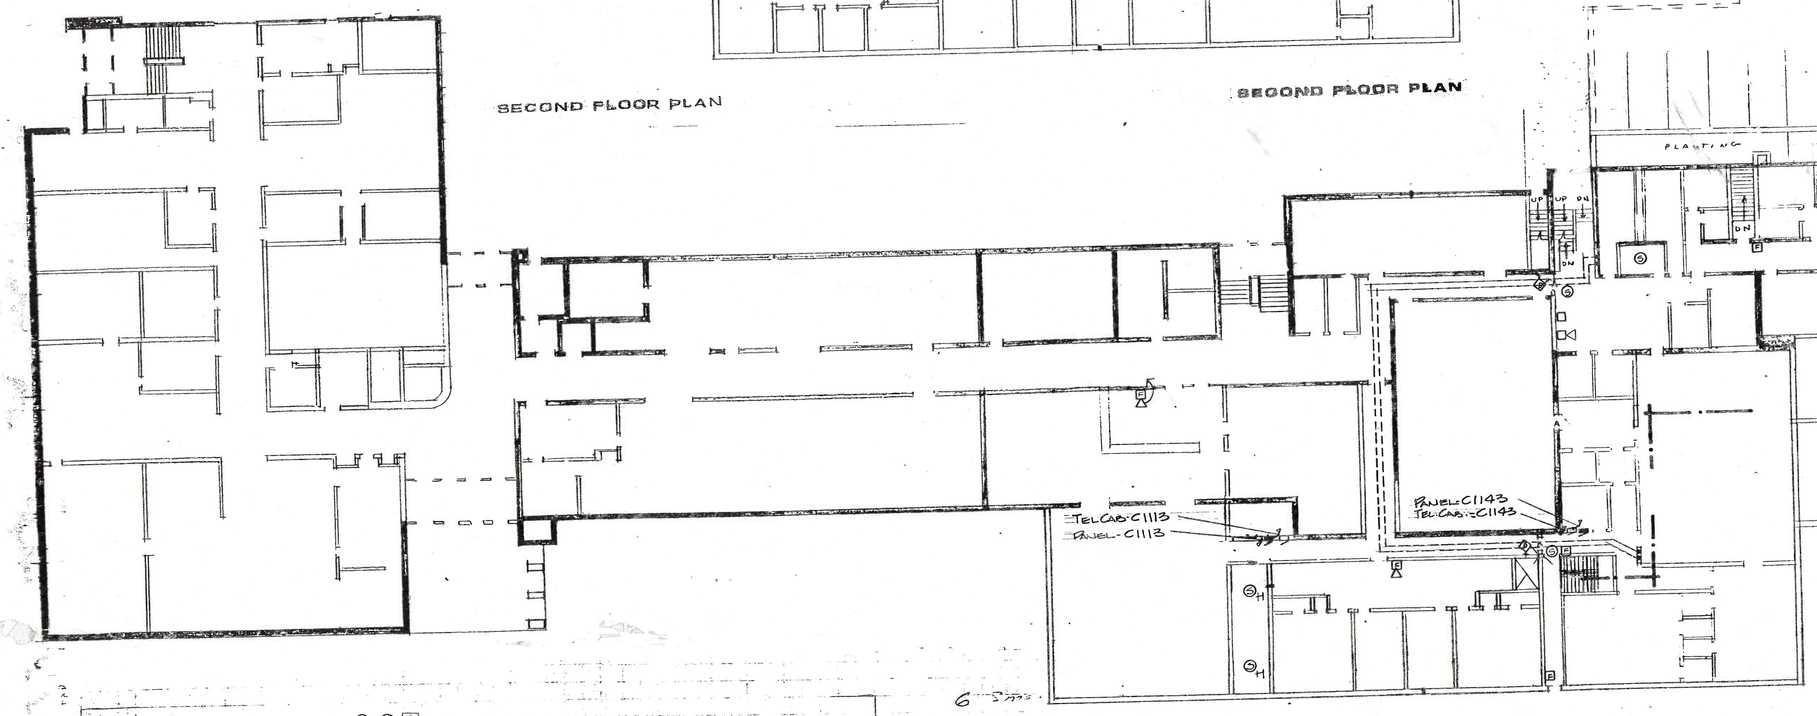

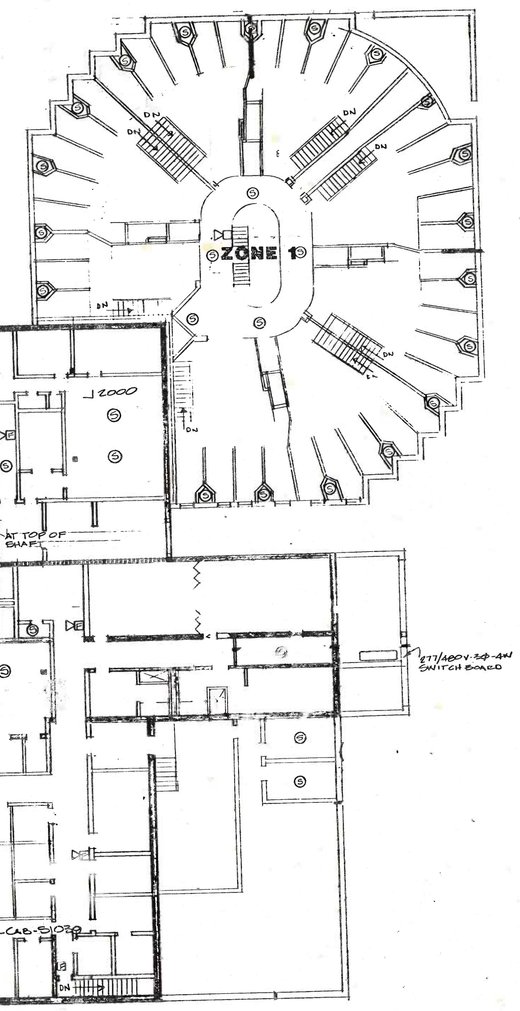

FIRST FLOOR PLAN

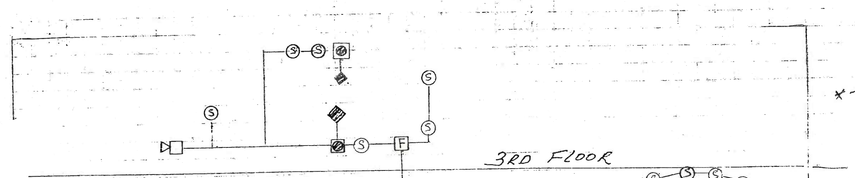


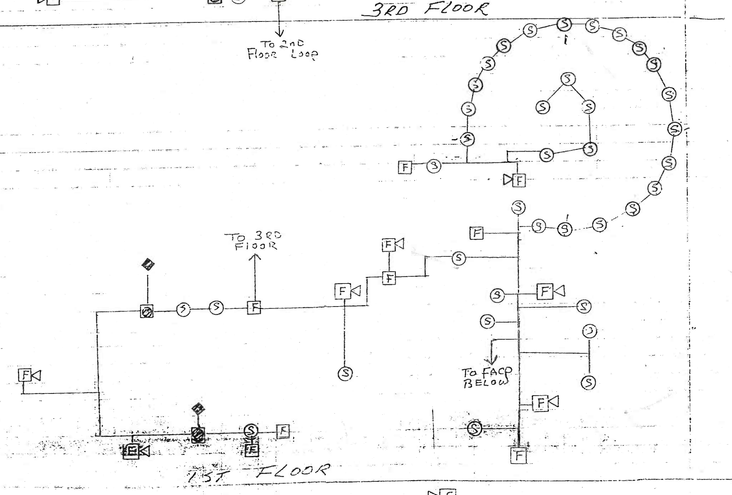


2ND FLOOR

KEY

- FACP = FIRE ALARM CONTROL
- S = PHOTO TYPE SMOKE DET.
- F = HORN STROBE ALARM
- F = MANUAL PULL STATION
- H = Heat Detector
- = Control Module
- = DOOR HOLD-OPEN

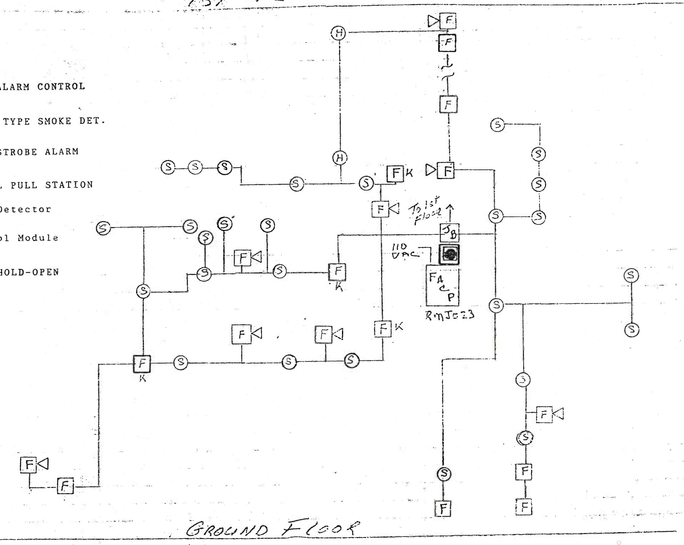

GROUND FLOOR

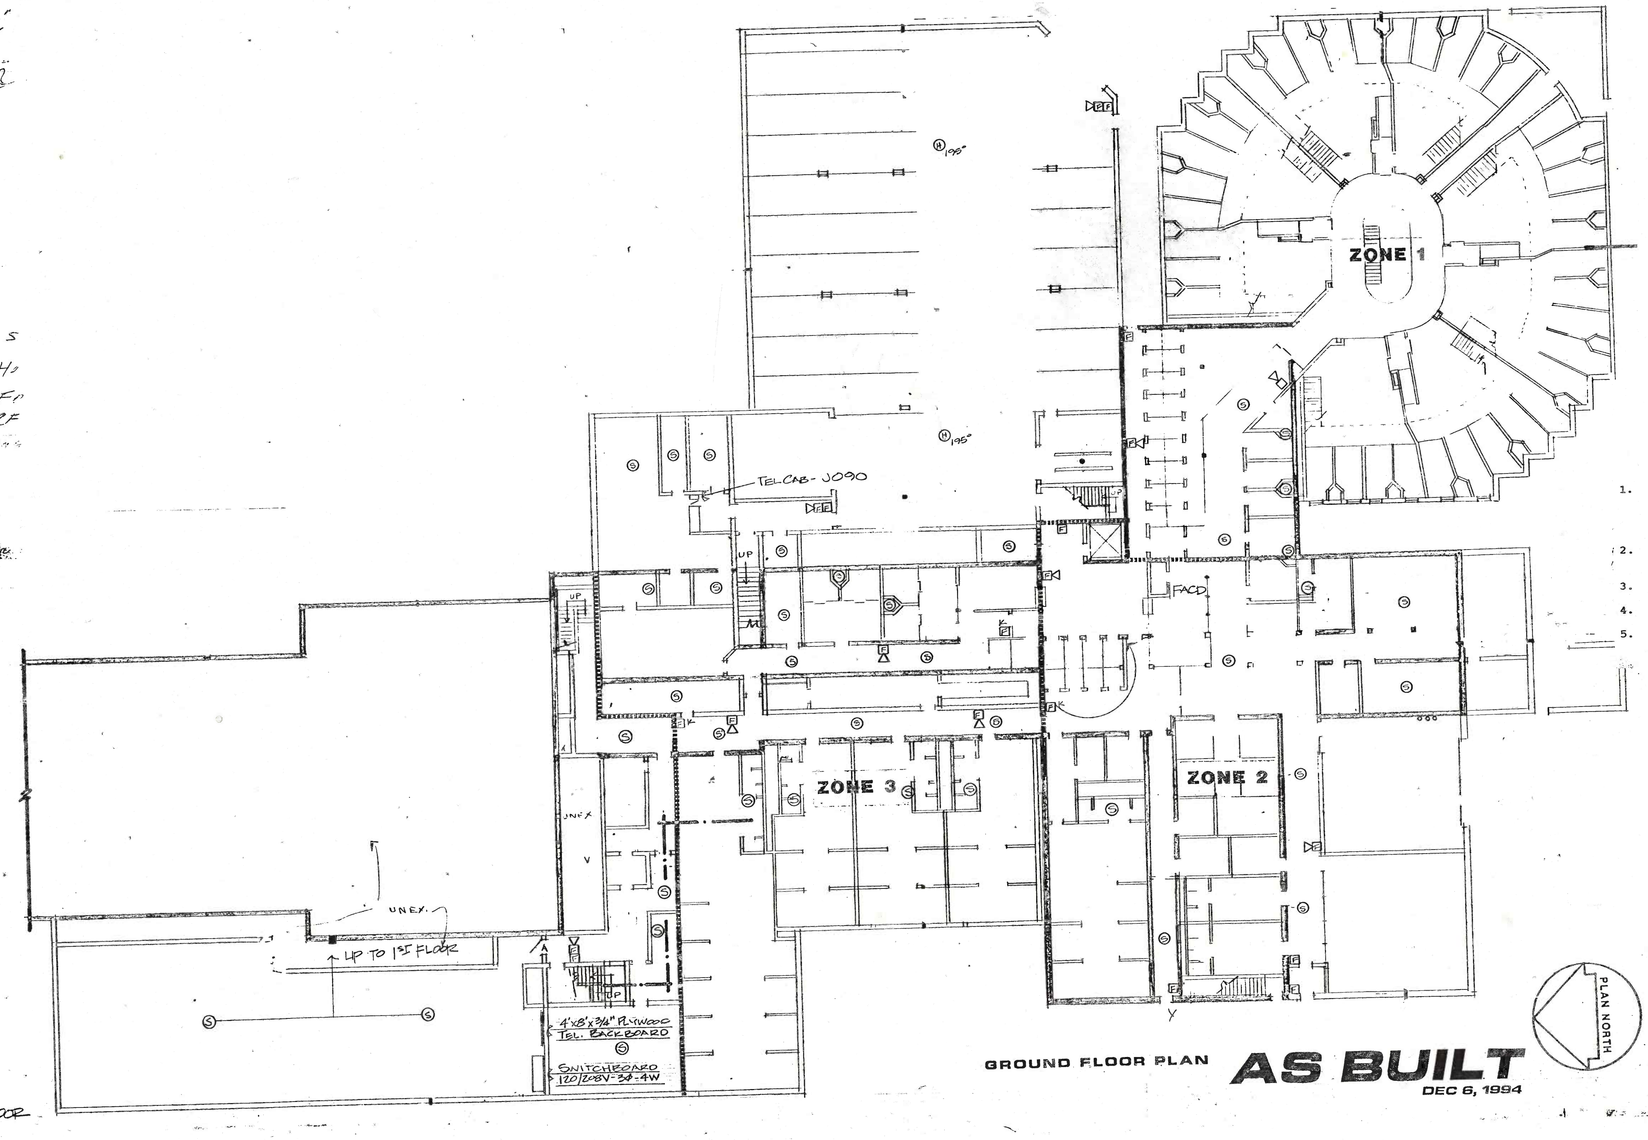

GROUND FLOOR PLAN

AS BUILT
DEC 6, 1994

DATE	REVISION
	1. Add 2 smoke detectors in mechanical room over kitchen. Add 1 smoke detector in dispatch Room S1047. Add 1 smoke detector in J060. Add 3 smoke detectors in storage room adjacent to Room J060.
	2. Delete fire alarm control panel in S1047. Add fire alarm control panel in Room J023.
	3. Delete smoke door holders in Rooms C1113 and C2030.
	4. Relocate switchboard in Generator Room to North wall.
	5. Relocate switchboard and communication equipment to East wall of Room J062 starting 16' 0" off wall between Rooms J062 and J060.

STRUCTURAL CONSULTANT

MECHANICAL CONSULTANT
MDI 1910 MAYFLOWER DR. MIDDLETON, WI.
608-836-7600

ARCHITECT
KENTON PETERS + ASSOC., INC.
44 E MIFFLIN
MADISON, WISCONSIN 53703
(608) 255-5655

JEFFERSON COUNTY
LAW ENFORCEMENT CENTER
JEFFERSON, WISCONSIN

1/16"-1'-0" SCALE
FLOOR PLANS
FIRE ALARM

10-11-90
E-17