

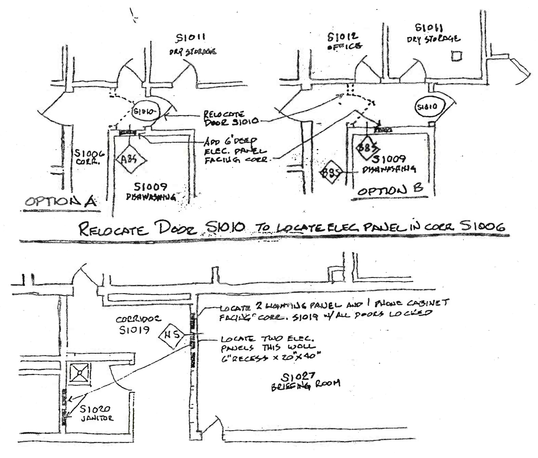


RELOCATE DOOR S1010 TO LOCATE ELEC. PANEL IN COR S1006


NORTH WALL OF ROOM S1020 WILL HAVE 2 ELEC PANELS

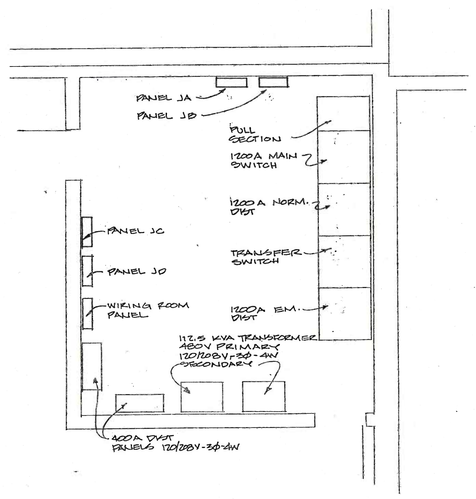

WIRING ROOM PLAN
SCALE 1/4"=1'-0"

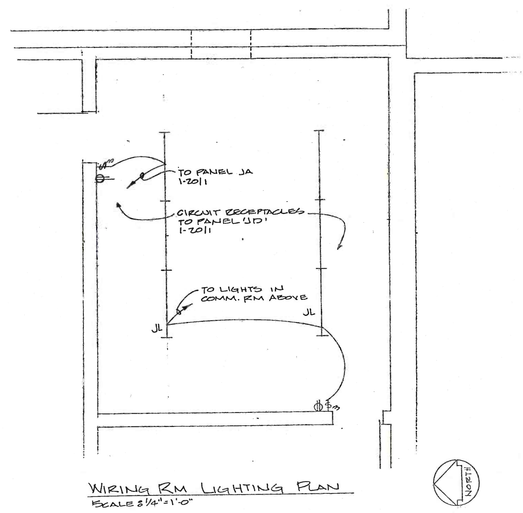

WIRING RM LIGHTING PLAN
SCALE 1/4"=1'-0"

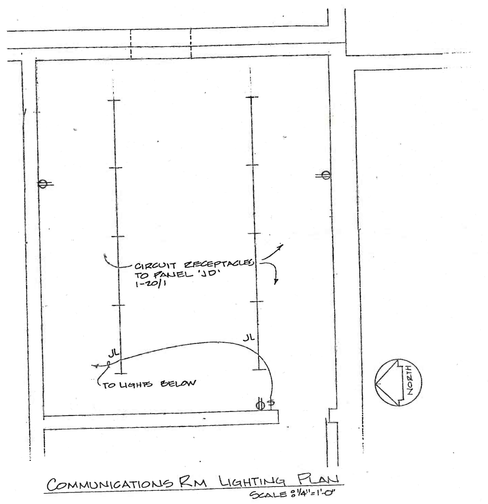

COMMUNICATIONS RM LIGHTING PLAN
SCALE 1/4"=1'-0"


Transmitted w/ Elect. Meeting Notes 10/17/90

ELECTRICAL COORDINATION		10-19-90
KENTON PETERS + ASSOC. 44 E. MIFFLIN MADISON, WISCONSIN 53703 (608) 255-5656	JEFFERSON COUNTY LAW ENFORCEMENT CENTER JEFFERSON, WISCONSIN	G23

WIRING ROOM PLAN		1/10/91
KENTON PETERS + ASSOC. 44 E. MIFFLIN MADISON, WISCONSIN 53703 (608) 255-5656	JEFFERSON COUNTY LAW ENFORCEMENT CENTER JEFFERSON, WISCONSIN	E86


WIRING RM LIGHTING		1-16-91
KENTON PETERS + ASSOC. 44 E. MIFFLIN MADISON, WISCONSIN 53703 (608) 255-5656	JEFFERSON COUNTY LAW ENFORCEMENT CENTER JEFFERSON, WISCONSIN	E93

COMMUNICATIONS RM LIGHTING		1-15-91
KENTON PETERS + ASSOC. 44 E. MIFFLIN MADISON, WISCONSIN 53703 (608) 255-5656	JEFFERSON COUNTY LAW ENFORCEMENT CENTER JEFFERSON, WISCONSIN	E94

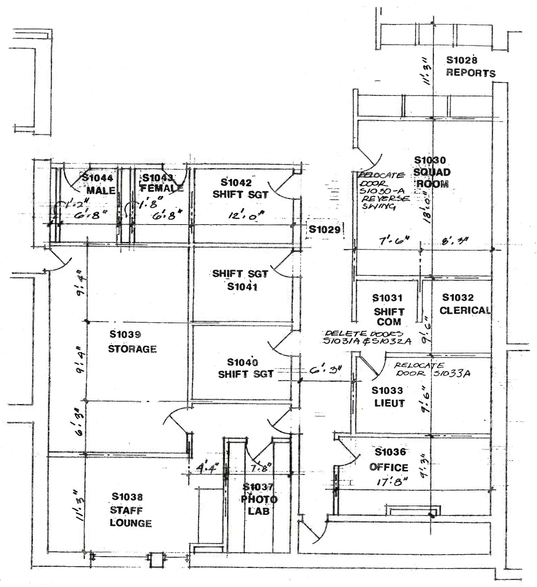


PARTIAL PLAN
1/8"=1'-0"

PARTIAL PLAN		2/10/81
KENTON PETERS + ASSOC. 44 E. MIFFLIN MADISON, WISCONSIN 53703 (608) 255-5656	JEFFERSON COUNTY LAW ENFORCEMENT CENTER JEFFERSON, WISCONSIN	G112

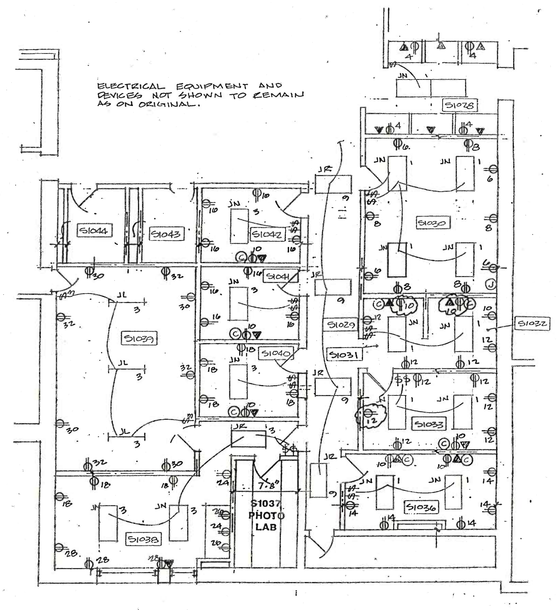


PARTIAL PLAN
1/8"=1'-0"

ELECTRICAL AT PATROL OFFICES		6/5/91
KENTON PETERS + ASSOC. 44 E. MIFFLIN MADISON, WISCONSIN 53703 (608) 255-5656	JEFFERSON COUNTY LAW ENFORCEMENT CENTER JEFFERSON, WISCONSIN	E149

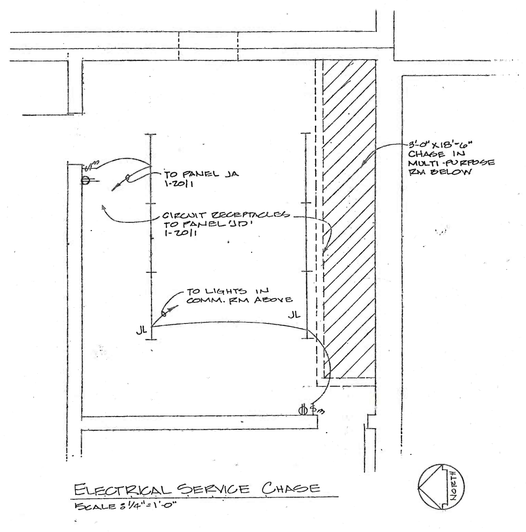

ELECTRICAL SERVICE CHASE
SCALE 1/4"=1'-0"

SERVICE CHASE AT J025 REVISED		11/5/91
KENTON PETERS + ASSOC. 44 E. MIFFLIN MADISON, WISCONSIN 53703 (608) 255-5656	JEFFERSON COUNTY LAW ENFORCEMENT CENTER JEFFERSON, WISCONSIN	E150

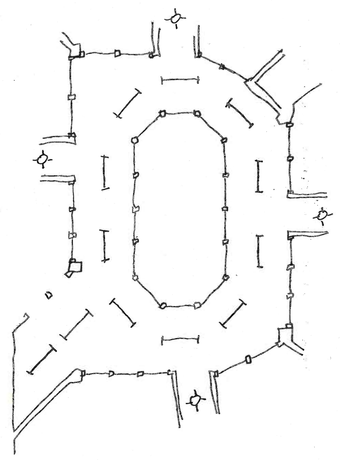

J096 REFLECTED CEILING PLAN		6/24/91
KENTON PETERS + ASSOC. 44 E. MIFFLIN MADISON, WISCONSIN 53703 (608) 255-5656	JEFFERSON COUNTY LAW ENFORCEMENT CENTER JEFFERSON, WISCONSIN	E175

AS BUILT
DEC 6, 1994

KENTON PETERS + ASSOCIATES, INC.
324 SOUTH HAMILTON STREET
MADISON, WI 53703
(608) 255-5656

SUPPLEMENTARY DRAWING
E-2A