

FIXTURE SCHEDULE			
SYM	DESCRIPTION	LAMPS	MANUFACTURER / CAT. NO.
JY/E	WALL LT.	1-150W MH.	HALO
JW	FLOOR, CAN	4-15W-FLOFT	HALO

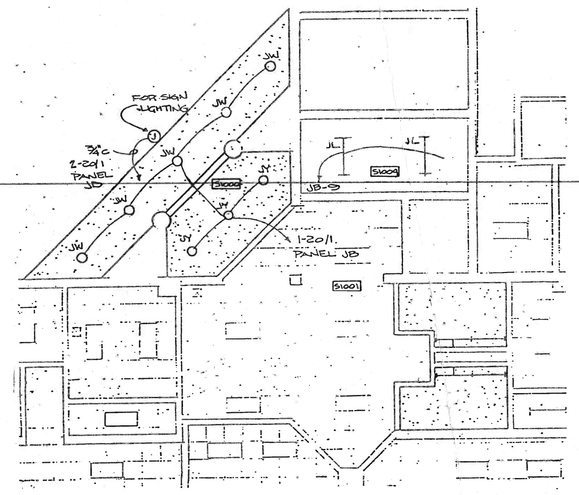

A-12 REFLECTED CLG. PLAN - FIRST FLOOR SHERIFF'S
REVISIONS TO S1000, S1002, S1003

ADDENDUM NO.2		7/10/90
KENTON PETERS + ASSOC. 44 E. MIFFLIN MADISON, WISCONSIN 53703 (608) 255-5858	JEFFERSON COUNTY LAW ENFORCEMENT CENTER JEFFERSON, WISCONSIN	EA-1

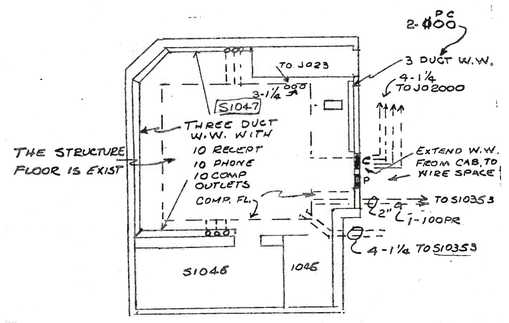

NOTE COMPUTER FLOOR.

RM 2000 IS MECH. SPACE ABOVE KITCHEN PROVIDE SLEEVES AT NE. & S.E. CORNER FOR RADIO MICROWAVE. 1¼" SLEEVES.

COMMUNICATIONS ROOM J1047

1. J1000 - Delete 2 'JR' fixtures. Install 3 'JY' fixtures in Room J1000.
2. Install 5 'JW' fixtures in canopy outside Room J1000.
3. Install junction box in canopy for sign lighting. Provide 2 20/1 circuits from panel 'JB'.
4. S1004 - Delete 2 'JS' fixtures. Provide 2 'JL' fixtures. See Sheet ER-1.
5. S1015 - Provide 1 'JP' fixture over sink and water closet. Delete 1 'JM' fixture at East end of room. 'JM' fixture at West end of room to remain.
6. Control pod - delete to 'JH' fixtures. Install 2 'JS' fixtures. See reflected ceiling plan.
7. S1026-1 - Delete 2 'JL' fixtures. Install 2 'JG' fixtures.
8. Add one (1) 'JE' fixture in each of 4 cell block vestibules. Lights to be controlled individually from "Pod Control Center".
9. Add six (6) 'JL' fixtures in generator room. Add switch and receptacle at door.

Exit light: south side of door S1004-B and south side of door S1060-B

NOTE: Exit lights above doors S1004-B and S1060-B hooked up to panel JB

DATE	REVISION

STRUCTURAL CONSULTANT

MECHANICAL CONSULTANT
MDI 1910 MAYFLOWER DR. MIDDLETON, WI. 608-836-7600

ARCHITECT
KENTON PETERS + ASSOC., INC.
44 E MIFFLIN
MADISON, WISCONSIN 53703
(608) 255-5858

JEFFERSON COUNTY
LAW ENFORCEMENT CENTER
JEFFERSON, WISCONSIN

FIRST FLOOR PLAN
3/8"=1'-0"
LIGHTING

6-11-90
E-2

AS BUILT
DEC 6, 1994

PLAN NORTH