

1. C1124 - See Sheet ER-2 for new lighting layout.
2. C1125 - See Sheet ER-2 for new lighting layout.
3. C1133 - See Sheet ER-2 for new lighting layout.
4. C1134 - See Sheet ER-2 for new lighting layout.
5. C1137 - Delete 2 'LA' fixtures. Install 2 'CB' fixtures.
6. C1110 - Delete 5 'CB' fixtures. Install 4 'CG' fixtures.
7. C1127 - Provide 4 'CE' fixtures in corridor C1127 circuit to existing panel.
8. C1114 - Delete 3 'CA' fixtures, 1 from each 2 fixture row.
9. C1117 and C1118 - See Sheet ER-4 for new lighting layout.
10. C1151-1 - See Sheet ER-2 for new lighting layout.
11. Add two (2) 'CL' fixtures in Room C1129 4' 0" off East wall. One (1) fixture 4' 0" off North wall to center and one (1) fixture 6' 0" South to center. Fixture to be flange type.
12. Add exit light at stair C1129-1 in Room C1129. Add exit light at exit door stair C1129-1.
13. Add cabinet unit heater in Room C1129-1 at exit door. See HVAC Drawings for exact location. CUH to be same size as motor #51. Circuit to panel 'CB'.
14. All new exit lights in Courthouse to be circuited to existing exit light panel.
15. Add exit light in Room C1101 at door to Room C1127.


Exit lights: north side of door C1113-B, west side of doors C1122-A and C1122-B; east side of door C1122-C; east side of doors C1142-A and C1143-A; and west side of door C1151-A

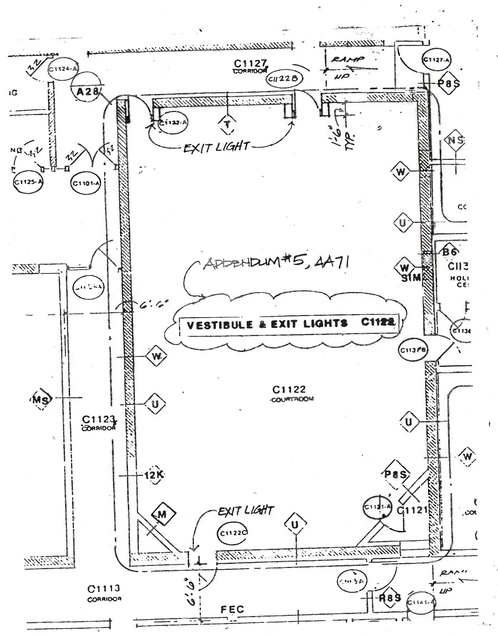

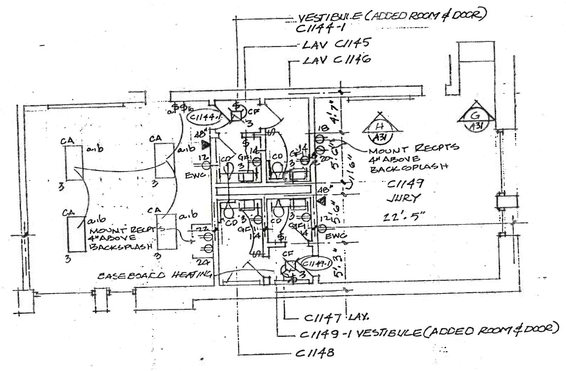

A G2.1 PARTIAL FIRST FLOOR PLAN
1/8"= 1'-0"

PARTIAL FIRST FLOOR PLAN - ELECTRICAL		11/12/9

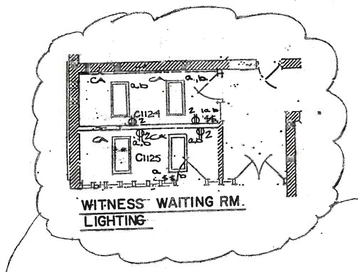

ADDENDUM NO2, EA-2

AS BUILT
DEC 6, 1994

STRUCTURAL CONSULTANT

MECHANICAL CONSULTANT.
MDI 1910 MAYFLOWER DR. MIDDLETON, WI.
608-836-7600

ARCHITECT.
KENTON PETERS + ASSOC., INC.
44 E MIFFLIN
MADISON, WISCONSIN 53703
(608) 255-5656

JEFFERSON COUNTY
LAW ENFORCEMENT CENTER
JEFFERSON, WISCONSIN

FIRST FLOOR PLAN
COURTHOUSE
1/8"=1'-0"
LIGHTING

6-11-90
E-3