


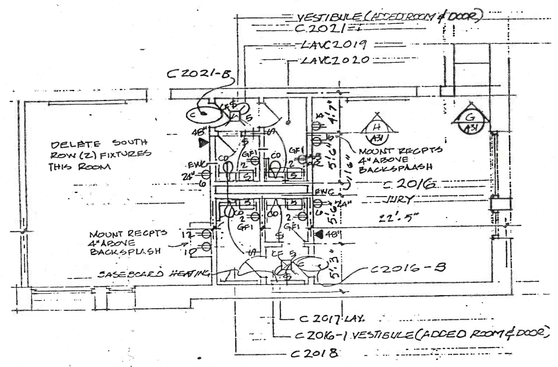


A G51 PARTIAL SECOND FLOOR PLAN
1/8"=1'-0"

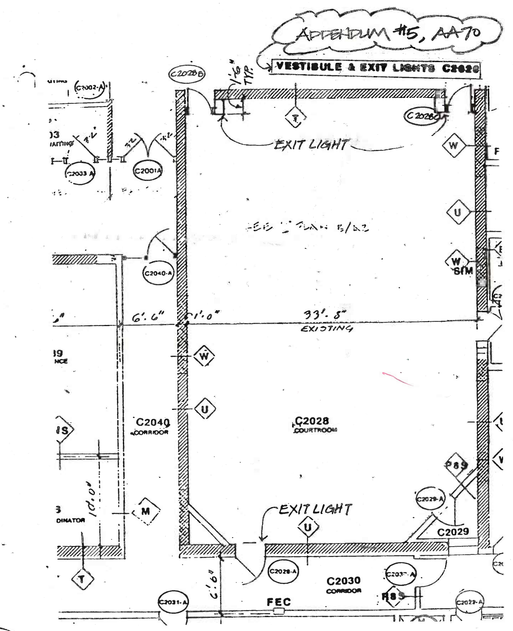


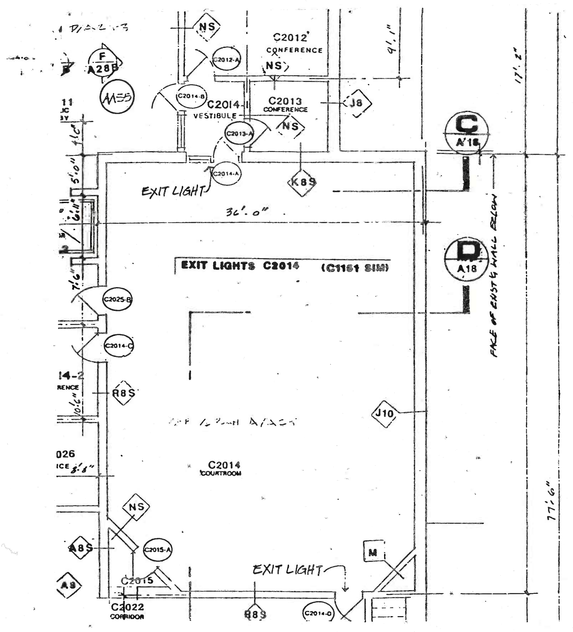


PARTIAL SECOND FLOOR PLAN - ELECTRICAL		11/21/
KENTON PETERS + ASSOC. 44 E MIFFLIN MADISON, WISCONSIN (608) 255-5656 53703	PORTAGE COUNTY JAIL & SHERIFF'S DEPARTMENT STEVENS POINT, WISCONSIN	G51

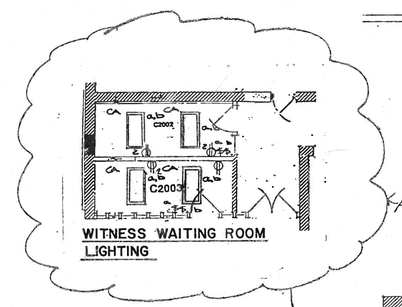

ADDENDUM #02
EA-3

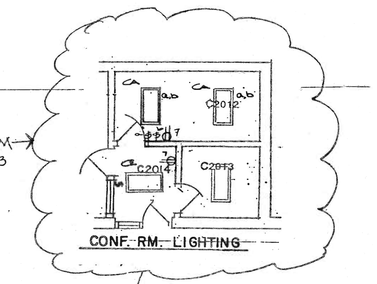

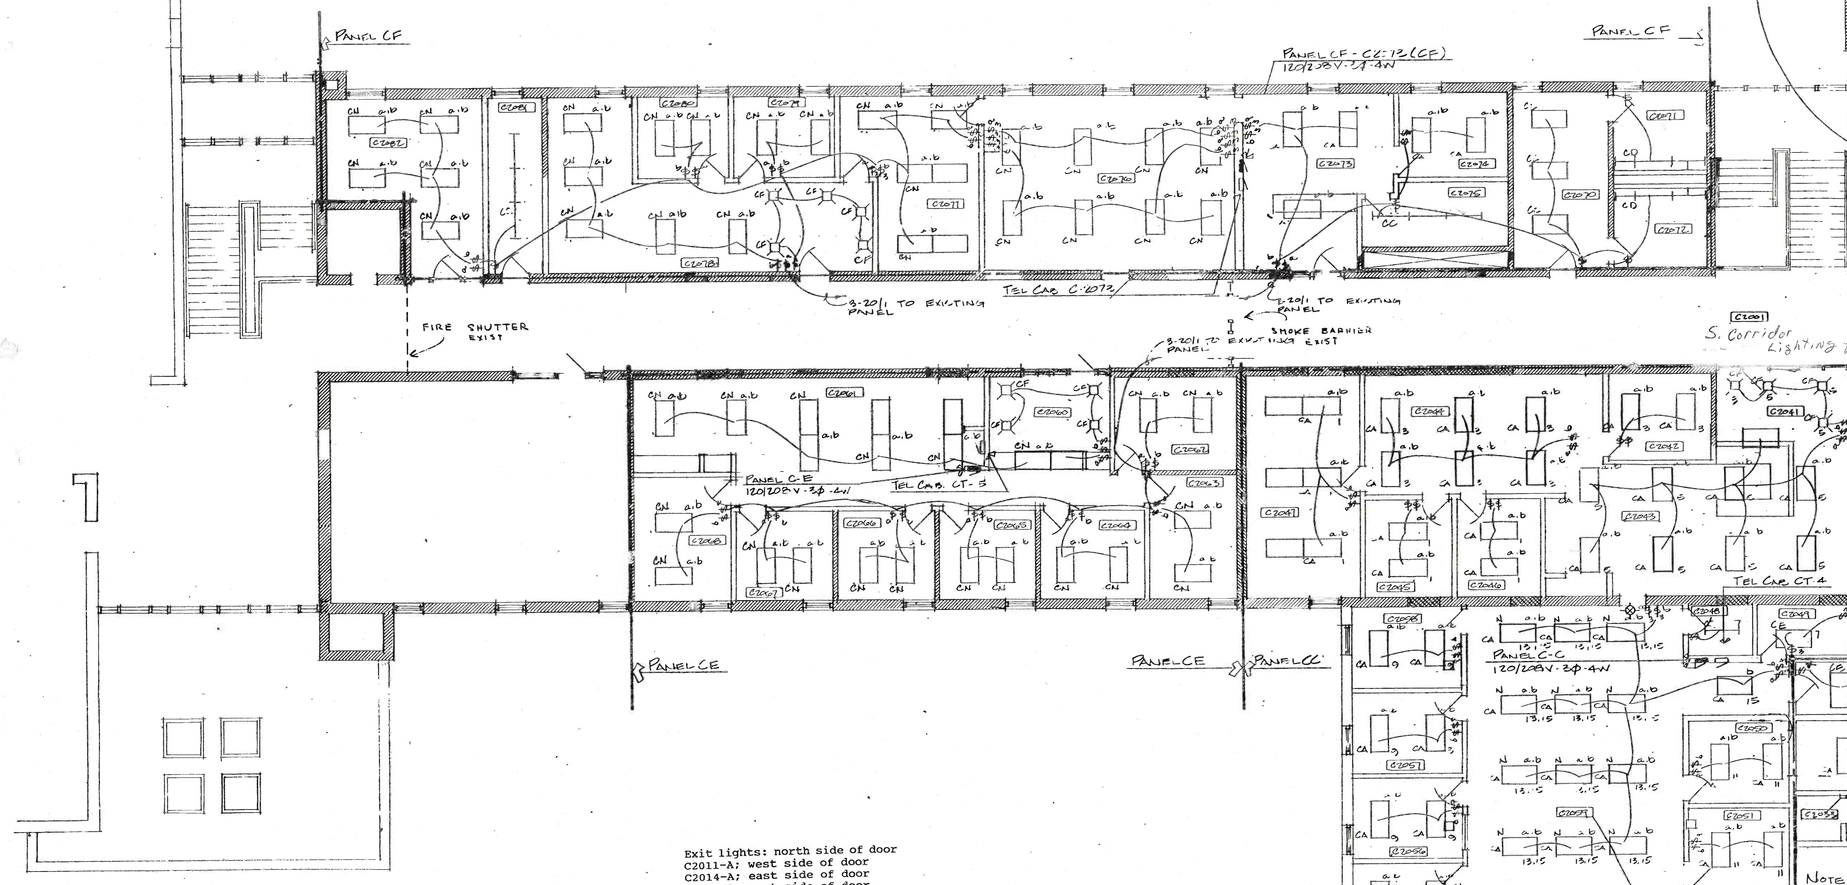

Exit lights: north side of door C2011-A; west side of door C2014-A; east side of door C2014-D; east side of door C2028-A; west side of door C2028-B and C2028-C; north side of door C2059-A

NOTE: New Courthouse exit lights are to be tied into existing courthouse exit light circuit.

1. C2002 - See Sheet ER-3 for new lighting layout.
2. C2003 - See Sheet ER-3 for new lighting layout.
3. C2012 - See Sheet ER-3 for new lighting layout.
4. C2013 - See Sheet ER-3 for new lighting layout.
5. C2014-1 - See Sheet ER-3 for new lighting layout.
6. C2025 - Delete 2 'CA' fixtures. Provide 2 'CE' fixtures.
7. C2004 - Provide 4 'CE' fixtures, circuit to existing panel.
8. C2031 - Delete 3 'CA' fixtures, 1 from each 2 fixture row.
9. 2034 and 2035 - See Sheet ER-4 for new lighting layout.
10. Add two (2) 'CL' fixtures in Room C2011 4' 0" off East wall. One (1) fixture 4' 0" off North wall to center and one (1) fixture 6' 0" South to center. Fixtures to be flange type.
11. Add exit light at top of stair C2010 in Room C2011.
12. Add exit light in Room C2004 at door to Room C2011.
13. Add exit light with directional arrow at South end of Room C2001.
14. Add exit light with double face and directional arrows at intersection of Rooms C2030 and C2040.

AS BUILT
DEC 6, 1994

DATE	REVISION
	CET 2

STRUCTURAL CONSULTANT

MECHANICAL CONSULTANT
MDI 1910 MAYFLOWER DR. MIDDLETON, WI. 608-836-7600

ARCHITECT
KENTON PETERS + ASSOC., INC.
44 E MIFFLIN
MADISON, WISCONSIN 53703
(608) 255-5656

JEFFERSON COUNTY
LAW ENFORCEMENT CENTER
JEFFERSON, WISCONSIN

SECOND FLOOR PLAN
COURTHOUSE
LIGHTING

6-11-90

E-4