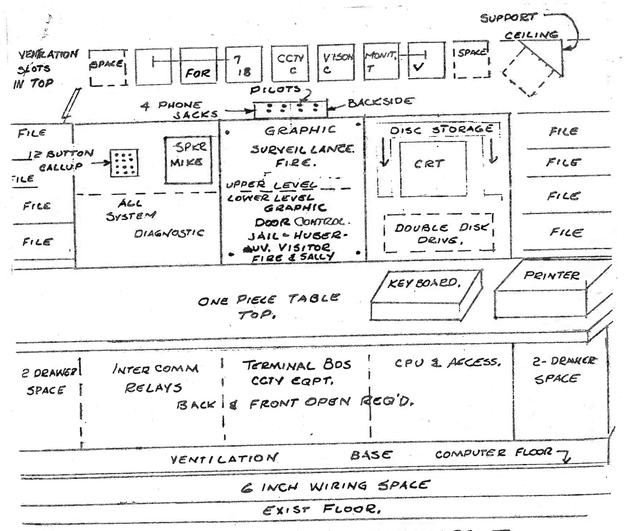


1. ARRANGEMENT SHOWN FLAT FILE MAY BE E—
2. ALL METAL CONSTRUCTION STRIPS
3. CONTRACTOR E/E 16710 SMALL DESIGN & BUILD ABOVE.
4. CONTRACTOR E/E 11880 SMALL WIRE 11880 DOORS.
5. CCTV BY E/E 16710 ON ALL DOORS & SPACES.
6. ARRANGEMENT FLEXIBLE.
7. ONE(1) REQUIRED

JAIL CONTROL CONSOLE RM. J023

ADDENDUM NO.2	7/10/90
KENTON PETERS + ASSOC. 44 E. MIFFLIN MADISON, WISCONSIN 53703 (608) 255-5656	JEFFERSON COUNTY LAW ENFORCEMENT CENTER JEFFERSON, WISCONSIN
	EA-15

1. J033 - Mount receptacles 2" to center above backsplash.
2. Install GFI receptacle in chase adjacent to Rooms J078 and J081.
3. J076 - Relocate receptacle on East wall 4' 0" to the North. Relocate receptacle on South wall to East wall 4' 0" off South wall.
4. J071 - Install 1 'GFI' receptacle on South wall 8' 0" off East wall. Install 2 'GFI' receptacles on North wall - 1-7' 0" off East wall, 1-4' 0" off West wall. Receptacles to be controlled from control Room J023. Mount receptacles at 24" AFF.
5. J026 - Install 1 'GFI' receptacle on East wall 13' 0" off North wall. Install 1 'GFI' receptacle on North wall 14' 0" off West wall. Install 1 'GFI' receptacle on West wall 8' 0" off South wall. Receptacles to be controlled from control Room J023. Mount receptacles at 24" AFF.
6. Provide junction box and 3/4" conduit to an accessible space above ceiling in Rooms J025 and J026 in Southeast corner adjacent to overhead door in Room J095.
7. Add connections for incinerator in Room S1007. Provide receptacle for heat tape connection to Room S1015.

DATE	REVISION

STRUCTURAL CONSULTANT

MECHANICAL CONSULTANT
M.S.I. 1910 MAYFLOWER DR. MIDDLETON, WI.
608-836-7600

ARCHITECT
KENTON PETERS + ASSOC., INC.
44 E MIFFLIN
MADISON, WISCONSIN 53703
(608) 255-5656

JEFFERSON COUNTY
LAW ENFORCEMENT CENTER
JEFFERSON, WISCONSIN

GROUND FLOOR PLAN — 6-11-90
1/8"=1'-0"
POWER, TV & COMMUNICATION — E-5

AS BUILT
DEC 6, 1994